


- ⊕ FOUND MONUMENT OF RECORD
- SET 5/8" x 36" IRON PIN W/CAP MARKED AP & A
- () RECORD DATA
- HEDGE

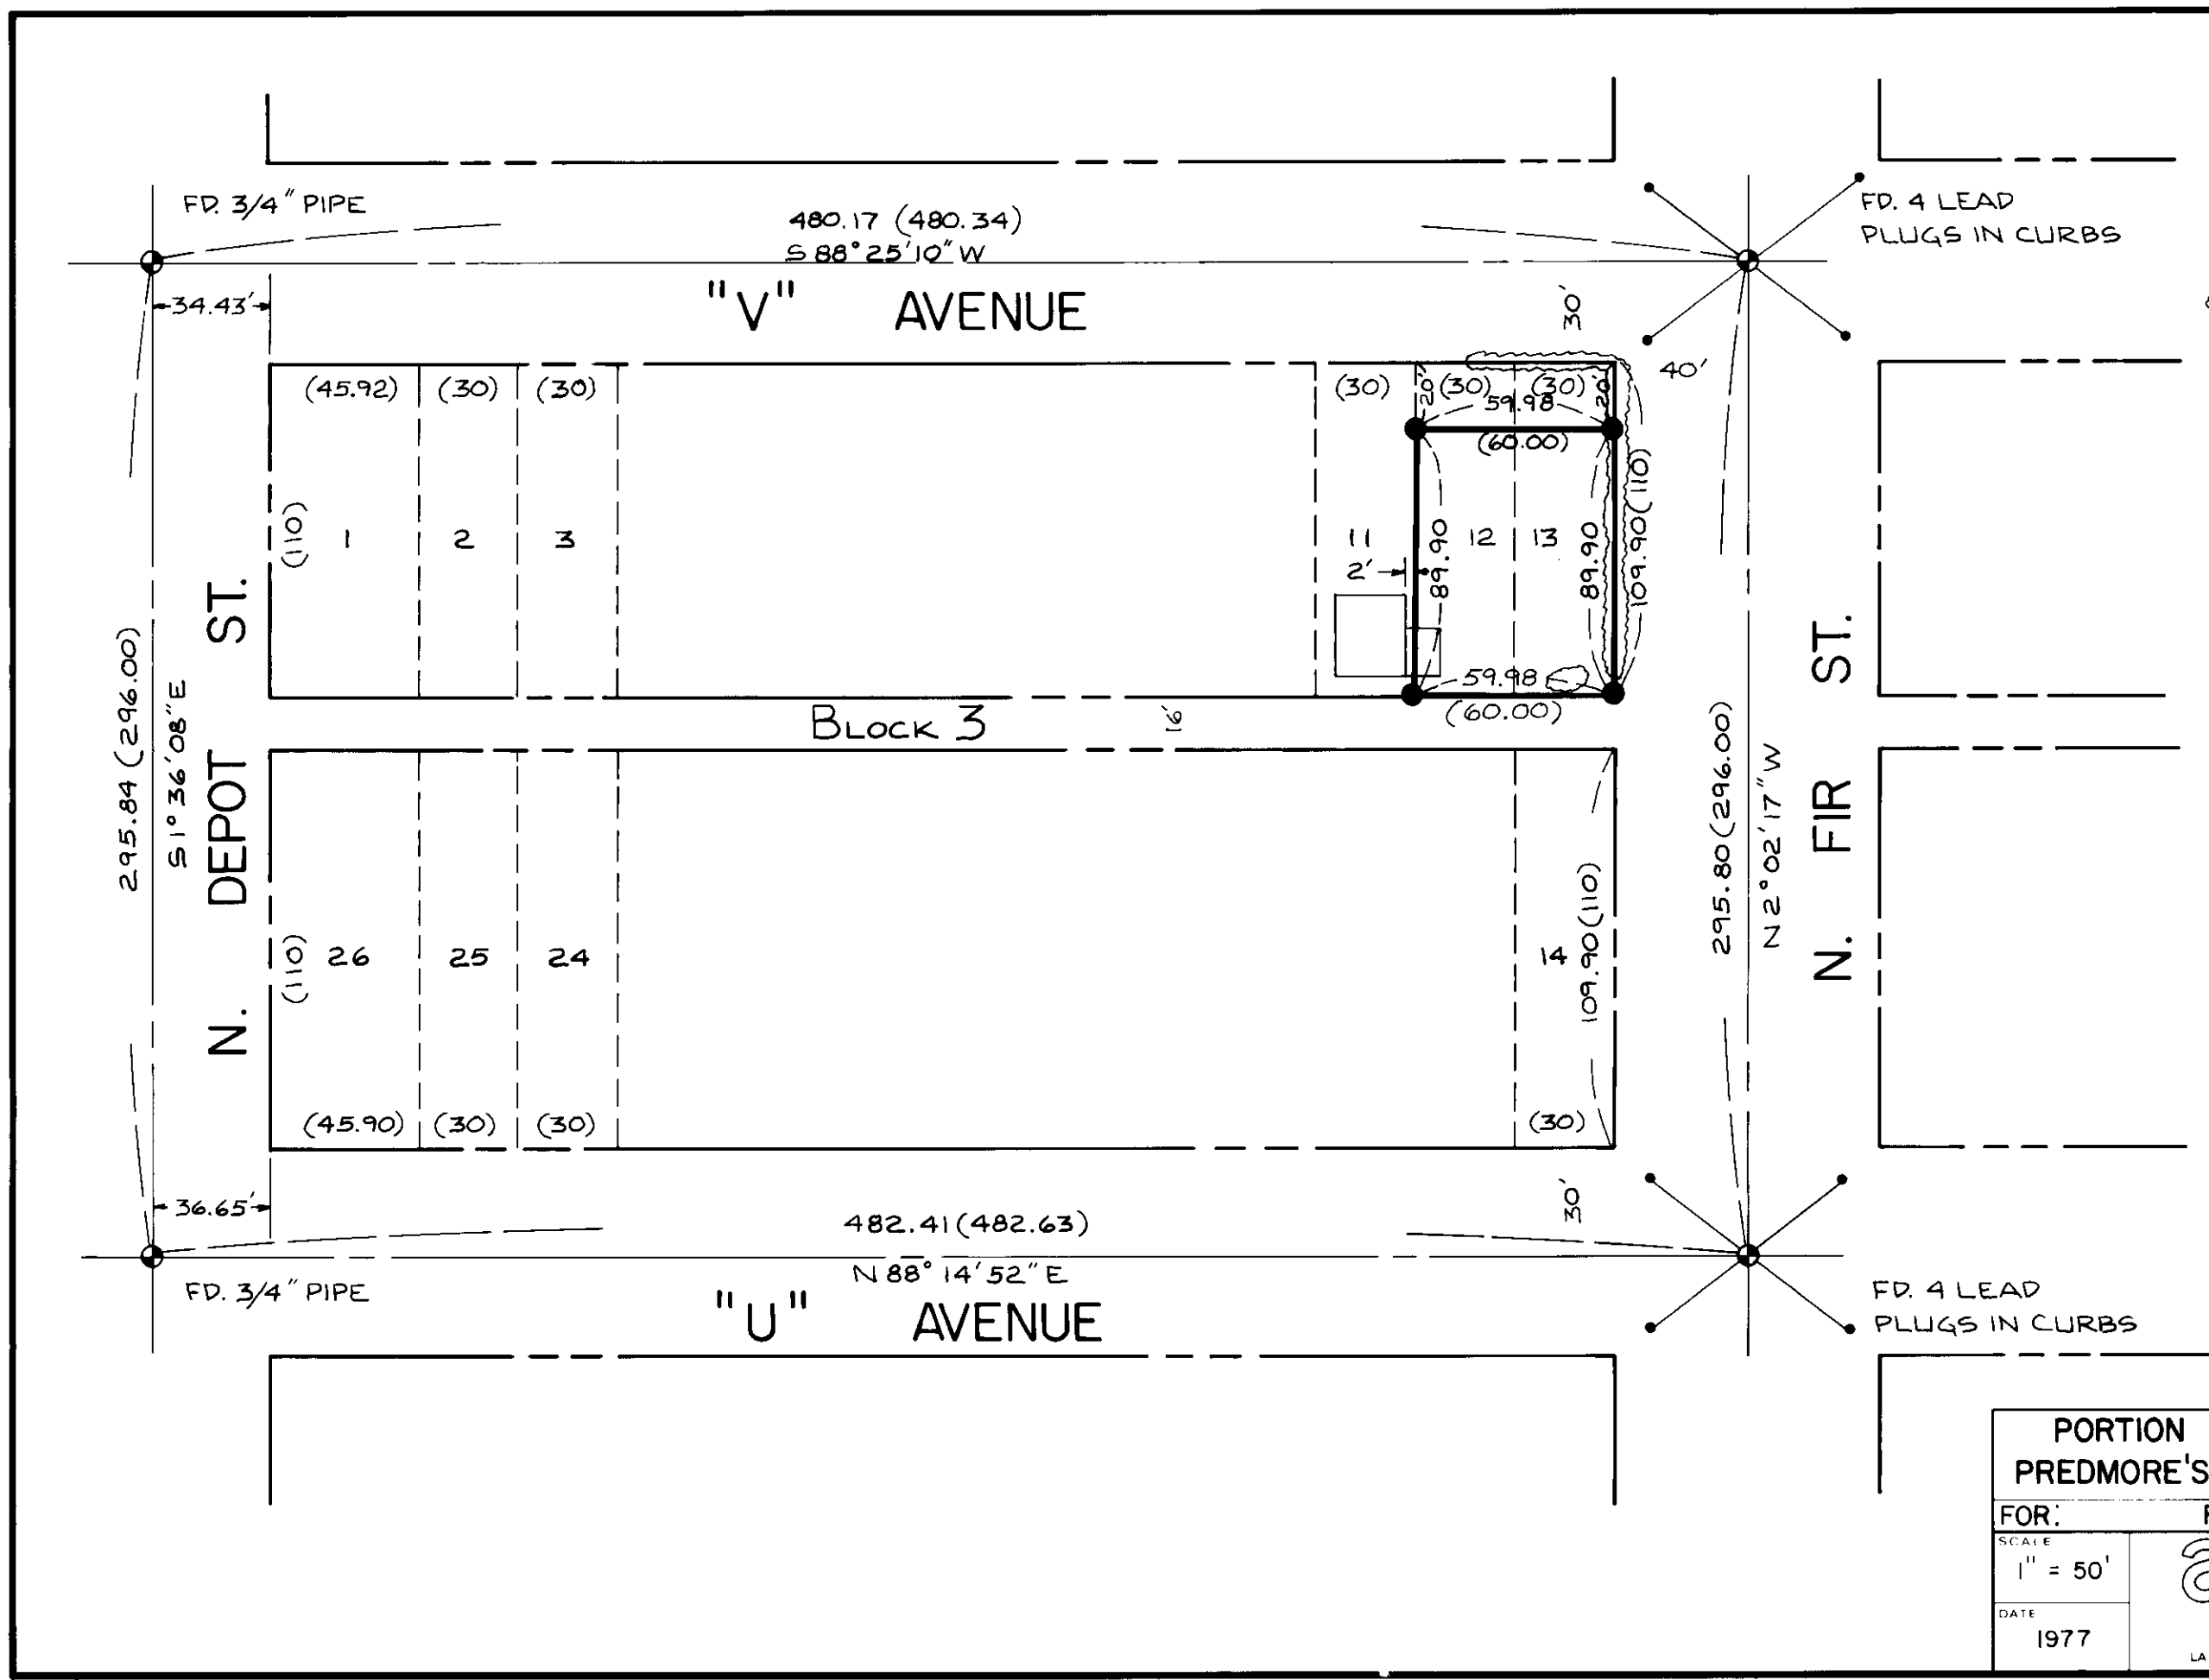

PORTION OF LOTS 12 & 13 OF PREDMORE'S ADDITION TO LA GRANDE		
FOR:	RON McDONALD	
SCALE	 anderson perry associates, inc. <small>engineering • surveying • materials testing</small> LA GRANDE & ENTERPRISE OREGON	SHEET NO.
DATE		1977



3577