



FOUND STONE MATCHING SIZE CALLED FOR IN ORIGINAL NOTES. FOUND REMNANTS OF OLD TREE STUMPS MATCHING BEARINGS AND DISTANCES CALLED FOR. FOUND OLD BLAZE LINES.

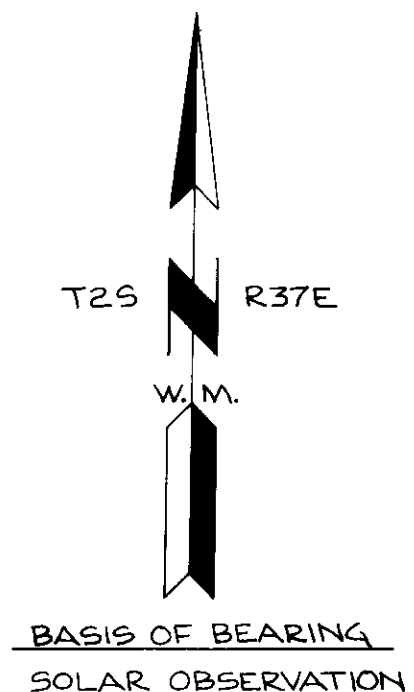

- LEGEND**
- FOUND MONUMENT OF RECORD - SET 2" IRON PIPE WITH BRASS CAP
 - MON. OF RECORD NOT FOUND - SET 2" IRON PIPE WITH BRASS CAP
 - SET 5/8" STEEL PIN WITH YELLOW CAP MARKED AP & A

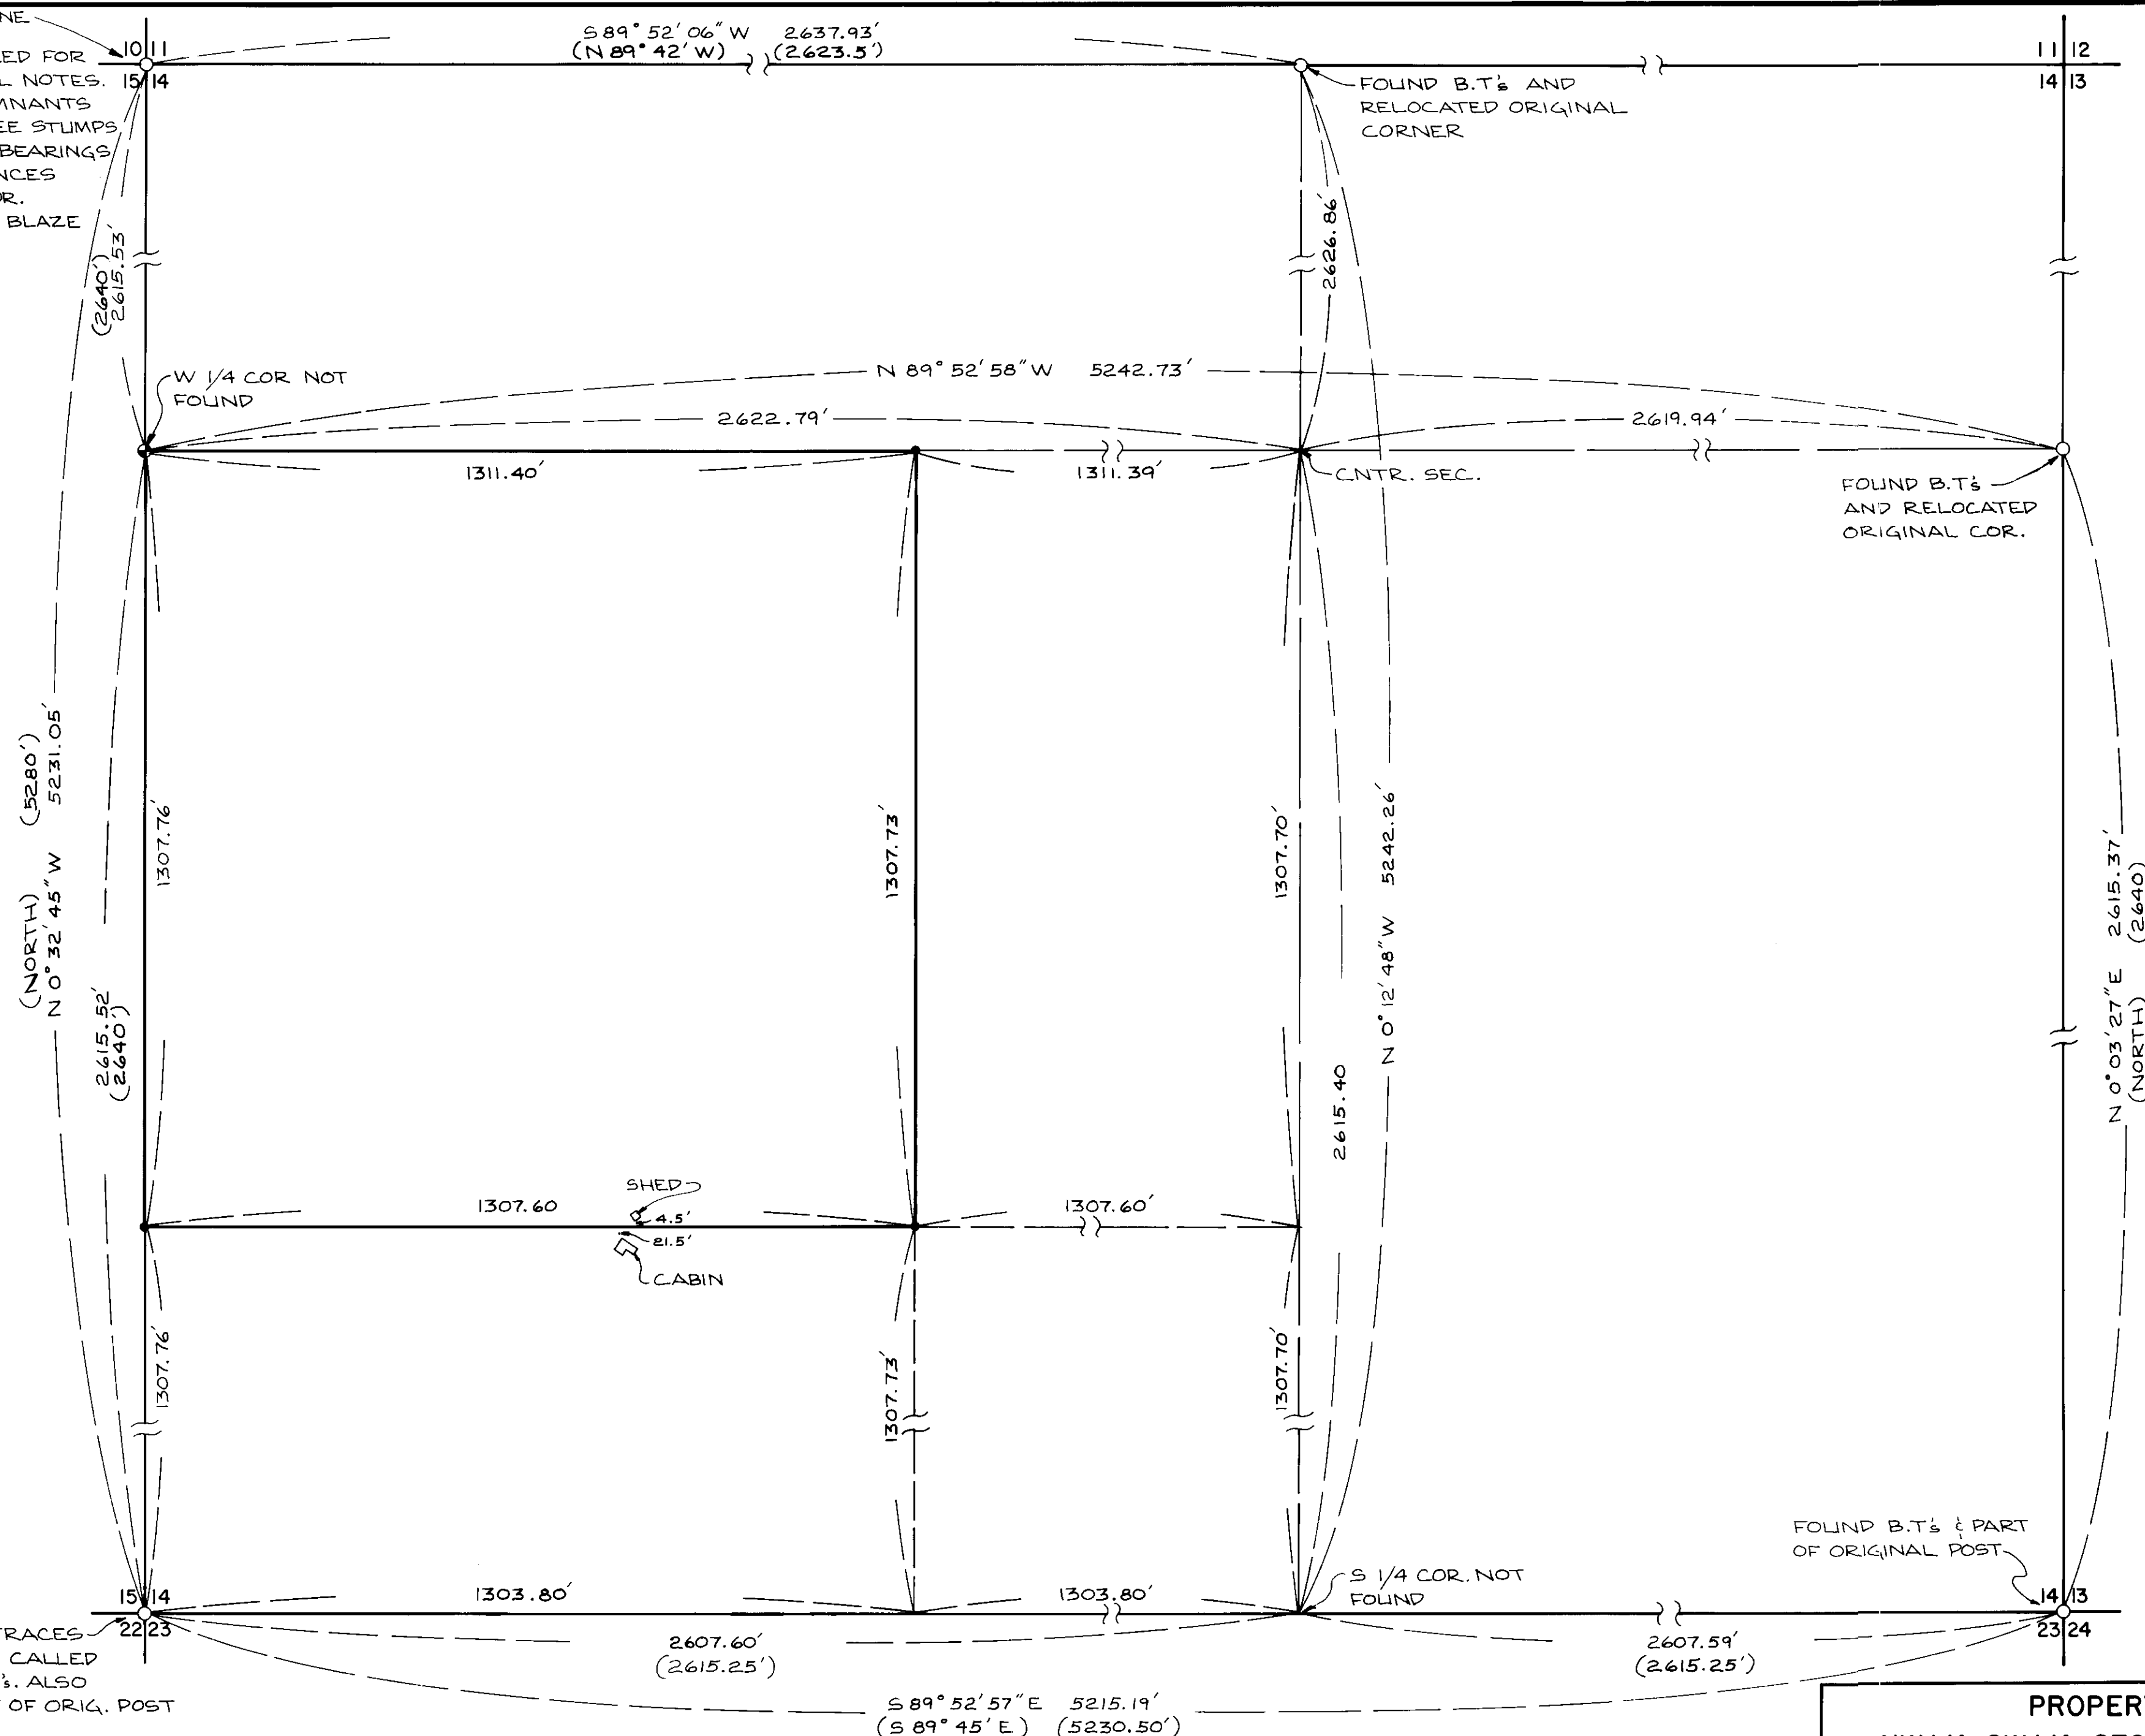

FOUND TRACES OF ORIG. CALLED FOR B.T.'s. ALSO FD. PART OF ORIG. POST

FOUND B.T.'s & PART OF ORIGINAL POST

| | | |
|------------------------------------|--|--------------------------------|
| PROPERTY SURVEY | | |
| NW1/4 SW1/4 SEC. 14 T2S, R37E W.M. | | |
| FOR: MARK McFARLAND | | |
| SCALE 1" = 200' | ANDERSON · PERRY & ASSOCIATES, INC. <small>ENGINEERING, SURVEYING, AND MATERIALS TESTING</small> | SHEET NO. |
| DATE: 1977 | | LA GRANDE & ENTERPRISE, OREGON |

45-77