

FOUND 1/2" STEEL PIN SET OVER CONCRETE MONUMENT


FOUND BRASS PIPE IN CONCRETE AS REFERENCE TO SEC. COR.

LEGEND

- ◆ FOUND MONUMENT OF RECORD
- SET 5/8" x 30" STEEL PIN WITH CAP MARKED A.P.&A
- SET P.K. NAIL
- () RECORD DATA
- PROPERTY LINE ————
- SECTION LINE - - - - -
- FENCE LINE * * * * *

REFERENCE MATERIAL

- RECORD SURVEY NO. 14-64
- RECORD SURVEY NO. 42-64
- RECORD SURVEY NO. 18-67
- RECORD SURVEY NO. 51-71

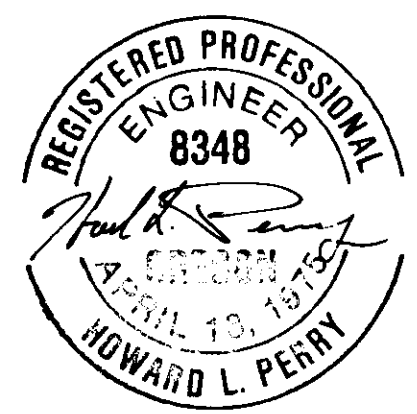

PROPERTY SURVEY		
LOCATED IN THE SE. 1/4 OF THE SW. 1/4, SEC 9 T 35, R 38E, W.M.		
FOR: ROGER LARSEN		
SCALE 1" = 50'	 anderson perry & associates, inc. engineering • surveying • materials testing LA GRANDE & ENTERPRISE, OREGON	SHEET NO.
DATE JULY, 1977		

55-77