

MONUMENTS

 \triangle

FOUND 5/8" x 2" x 17 /2 & 19/2"
STEEL POINTED SURVEY STAKES

- SET 21/2" x 30" GALVANIZED
 IRON PIPE WITH BRASS CAP
- SET I" x 30" GALVANIZED IRON PIPE WITH BRASS CAP

BASIS OF BEARING

POLARIS OBSERVATION AT EASTERN ELONGATION 8-01-77


RESURVEY OF LOTS I AND 2, FOR VIOLA V. TANDY OF BAKER, OREGON RESURVEY OF LOTS 9 AND 10, FOR RON COLE, MORTH POWDER, OREGON

GENERAL NOTES:

- I. ONLY THE POINTS MARKING, THE CENTERS OF FIFTH AND "B"
 AND FIFTH AND "C" WERE OLD MONUMENTS RECOVERED. A
 FIELD FENCE EXISTS AT THE NORTHWEST EDGE OF THE BLOCK
 AND 8 OTHER BLOCKS MARKING THE APPROXIMATE TOWN LIMITS.
 THIS FENCE, OLD IMPROVEMENTS IN LOTS 1 & 2, AND AN OLD
 FENCE IN THE ALLEY ON THE SOUTHEAST EDGE OF LOTS 1 & 2
 WERE LISED TO DETERMINE THE LENGTH OF THE LOTS.
- 2. BETWEEN LOTS 2 & 3 THERE ARE NO PERMANENT IMPROVEMENTS AFFECTED BY THIS SURVEY. BETWEEN LOTS B & 9 THERE IS A STEEL POST AND WIRE FENCE THAT ENCROACHES ONTO LOT 9 BY 0.8' ON ONE END, AND 1.5' AT THE OTHER END.
- 3. THE TWO STREET CENTER CORNERS WERE REMONUMENTED, AND THE ENDS OF THE TWO STREETS WERE MONUMENTED WITH THE CITY PAYING FOR THE MONUMENTS.
- 4. NO TRUE COPY OF THE ORIGINAL SURVEY COULD BE LOCATED. THE RECORD PISTANCES SEEM TO BE 80' FOR THE STREETS, 20' FOR THE ALLEYS, AND 50' x 150' FOR LOTS.

JULY, 1977



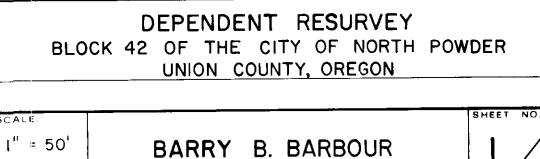

LAND SURVEYOR