MAP OF FIELD SURVEY

SOUTH ELGIN ADDITION TO CITY OF ELGIN

SOUTHEAST QUARTER SECTION 15, T. 1 N. R. 39 E.
UNION COUNTY, OREGON

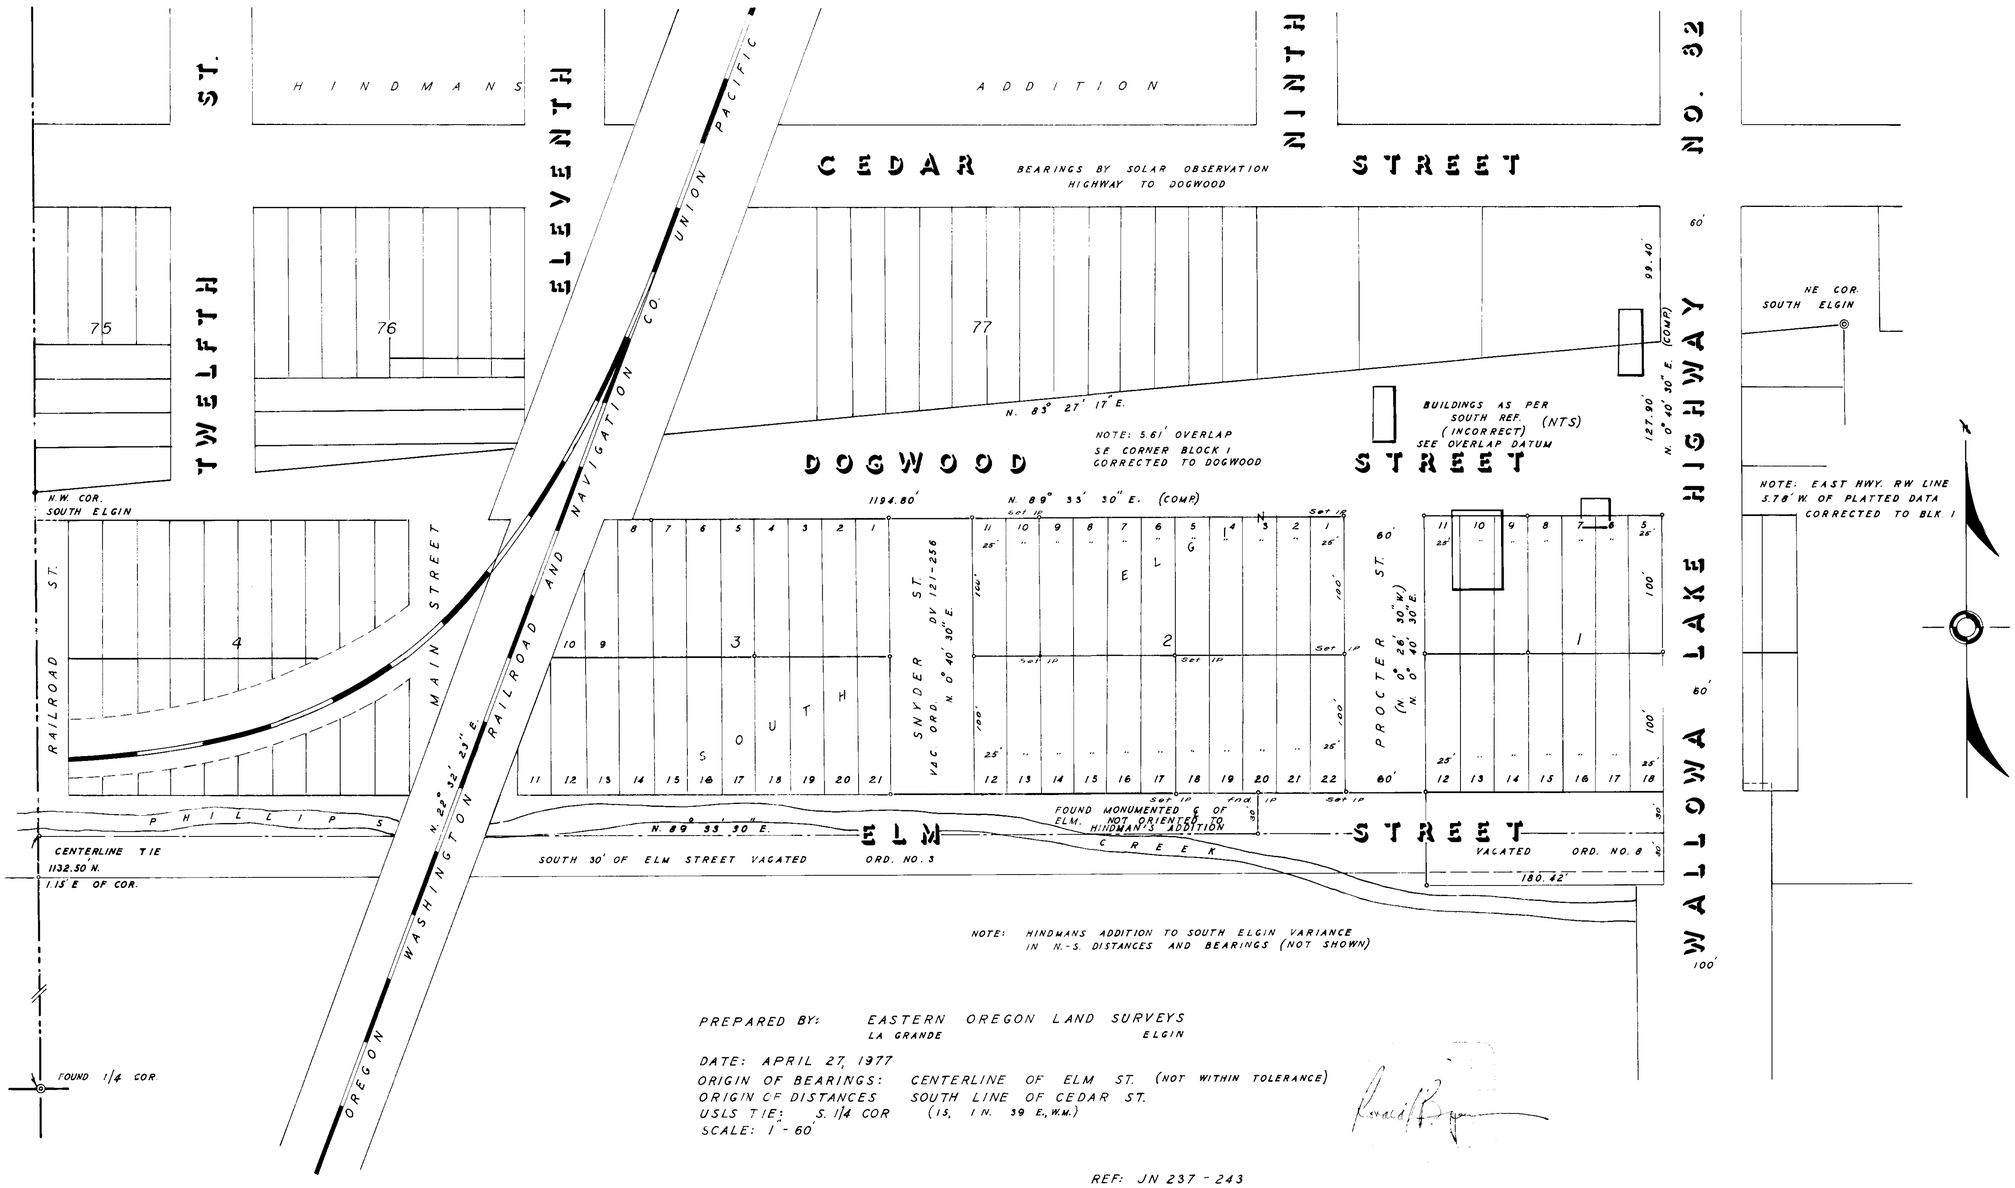

PREPARED BY: EASTERN OREGON LAND SURVEYS
LA GRANDE ELGIN

DATE: APRIL 27, 1977
ORIGIN OF BEARINGS: CENTERLINE OF ELM ST. (NOT WITHIN TOLERANCE)
ORIGIN OF DISTANCES SOUTH LINE OF CEDAR ST.
USLS TIE: S. 1/4 COR (15, 1 N. 39 E., W.M.)
SCALE: 1" - 60'

REF: JN 237 - 243