

SURVEY NO. 48-75
 S 89° 37' 18" E
 444.49 239.61

STREET

"D"
 N 0° 04' 00" W

376.52

600.00

SECOND STREET

STREET

THIRD STREET

STREET

FOURTH STREET

STREET

BRASS CAP
 SET BY O.S.H.D.


1" IRON PIN
 S 78° 12' E 5.23'

LANE

685.00
 S 0° 04' 00" E

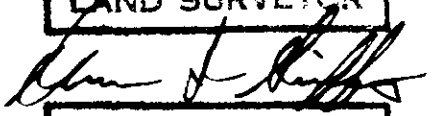
McALLISTER

S 89° 56' 00" W
 570.00


BASIS OF BEARING
 SURVEY NO. 58-73

LEGEND

- SET 5/8" x 30" IRON PIN WITH PLASTIC CAP MARKED B G A SURVEY MARKER
- FOUND UNRECORDED MONUMENT AS SHOWN
- FOUND MONUMENT OF RECORD
- * * * EXISTING FENCE LINE

REGISTERED
 PROFESSIONAL
 LAND SURVEYOR

 OREGON
 JULY 15, 1964
 DUANE J. GRIFFITH
 644

BAGETT, GRIFFITH & ASSOCIATES La Grande, Oregon	
Map of Survey WEST LINE OF "D" STREET IN ISLAND CITY UNION COUNTY, OREGON	
SURVEYED FOR	DALE YOUNG
SURVEYED BY	dig 9/77
Scale: 1" = 100"	Drawn by: SSZ 9/77

B5-77