

17-58



MAP OF FIELD SURVEY  
LOCATED IN LOT 10 BLOCK 9 OF HUG'S ADDITION TO  
ELGIN, UNION COUNTY, OREGON

DATE: SEPT. 1977 SCALE: 1" = 60'  
BEARINGS: TRUE FROM S. LINE OF SEC. 10

FOR: RYSDAM - GRANDEEN

Cor. Set by Natural Monuments

N.W. COR. LOT 10 BLOCK 9 OF HUG'S  
ADDITION 3065.17' N. AND 547.92'  
E. OF S. 1/4 COR. SEC. 10

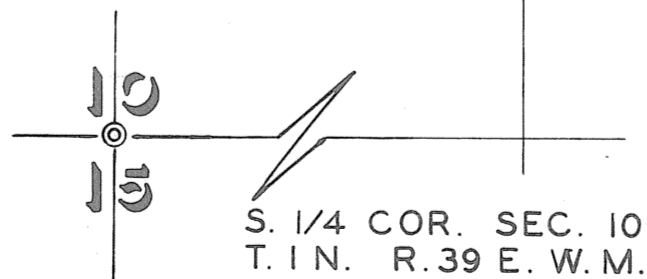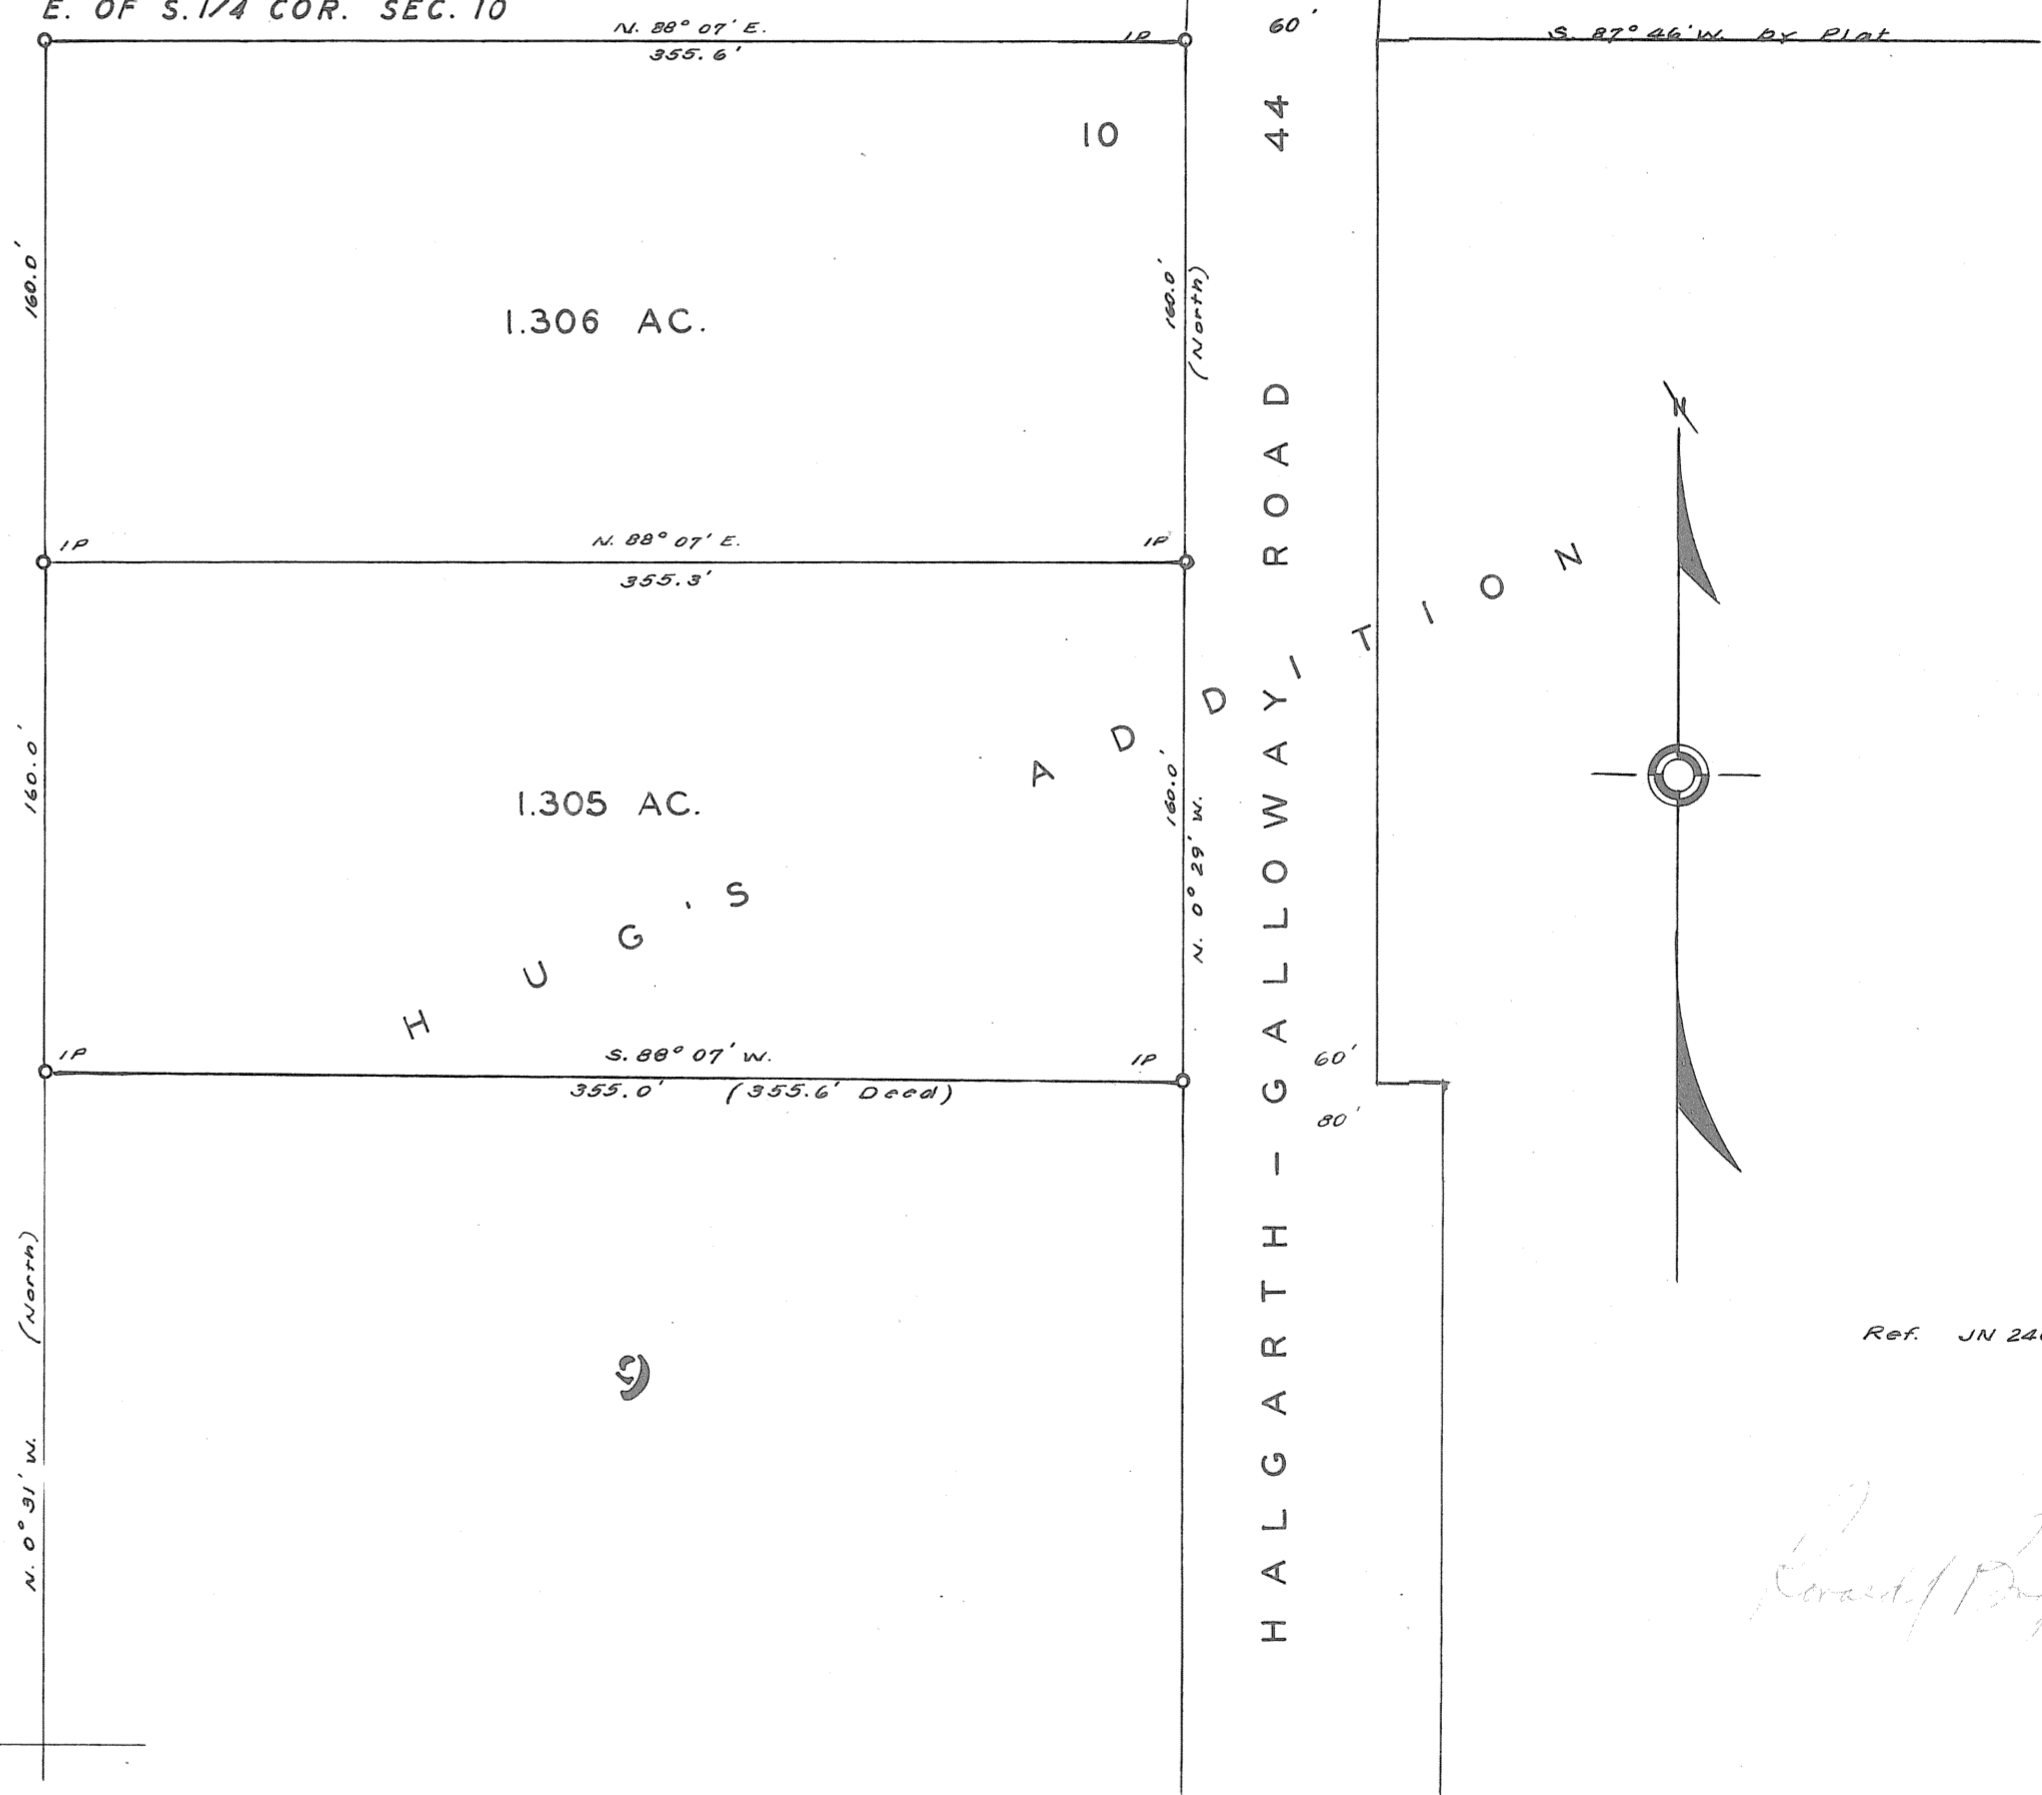

Ref. JN 246

*Ronald P. Boyer*

87-77