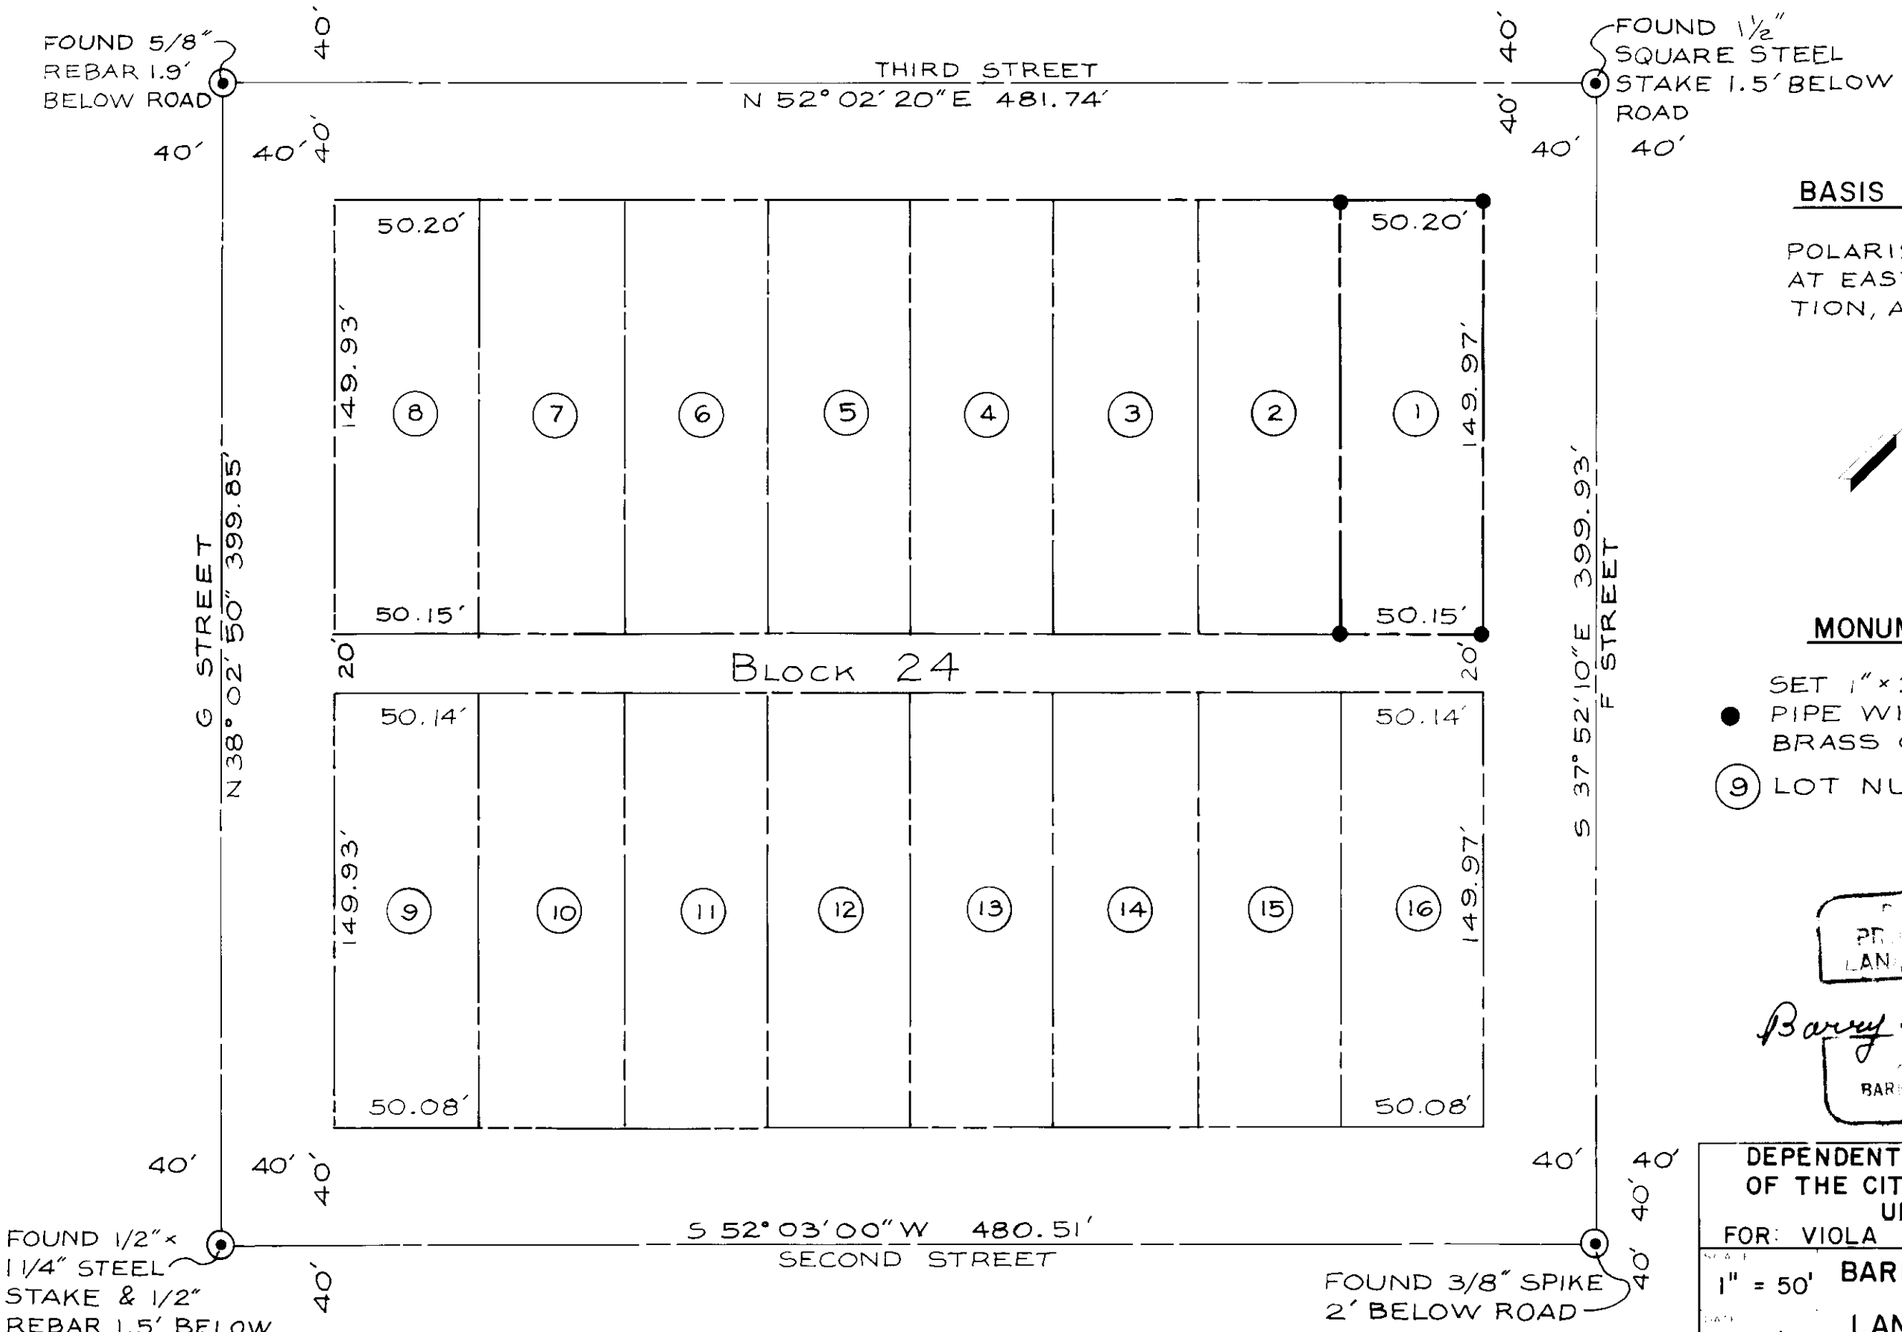

BASIS OF BEARING

POLARIS OBSERVATION AT EASTERN ELONGATION, AUGUST 1, 1977

MONUMENTS SET

● SET 1" × 30" GALVANIZED PIPE WITH MARKED BRASS CAP.

(9) LOT NUMBERS

REGISTERED PROFESSIONAL LAND SURVEYOR

Barry B. Barbour

BARRY B. BARBOUR 1051

DEPENDENT RESURVEY BLOCK 24 OF THE CITY OF NORTH POWDER, UNION CO., OREGON

FOR: VIOLA V. TANDY BAKER, OREGON

1" = 50'

SEPT. '77

BARRY B. BARBOUR

LAND SURVEYOR

35-117