


Note: Union Co. tax map and O.S.H.D map show 'B' Street is 70 ft. Original plat is 80 ft. This survey revised on 9-23-77 to conform to true 80 ft. width

LEGEND

- Indicates found monument as noted
- ⊙ " set 3/8" rebar
- " set 1/2" rebar


3

Set 3/8" rebar at intersection line of monuments between 5th & C to 3rd & C and 4th & Center to 4th & B.

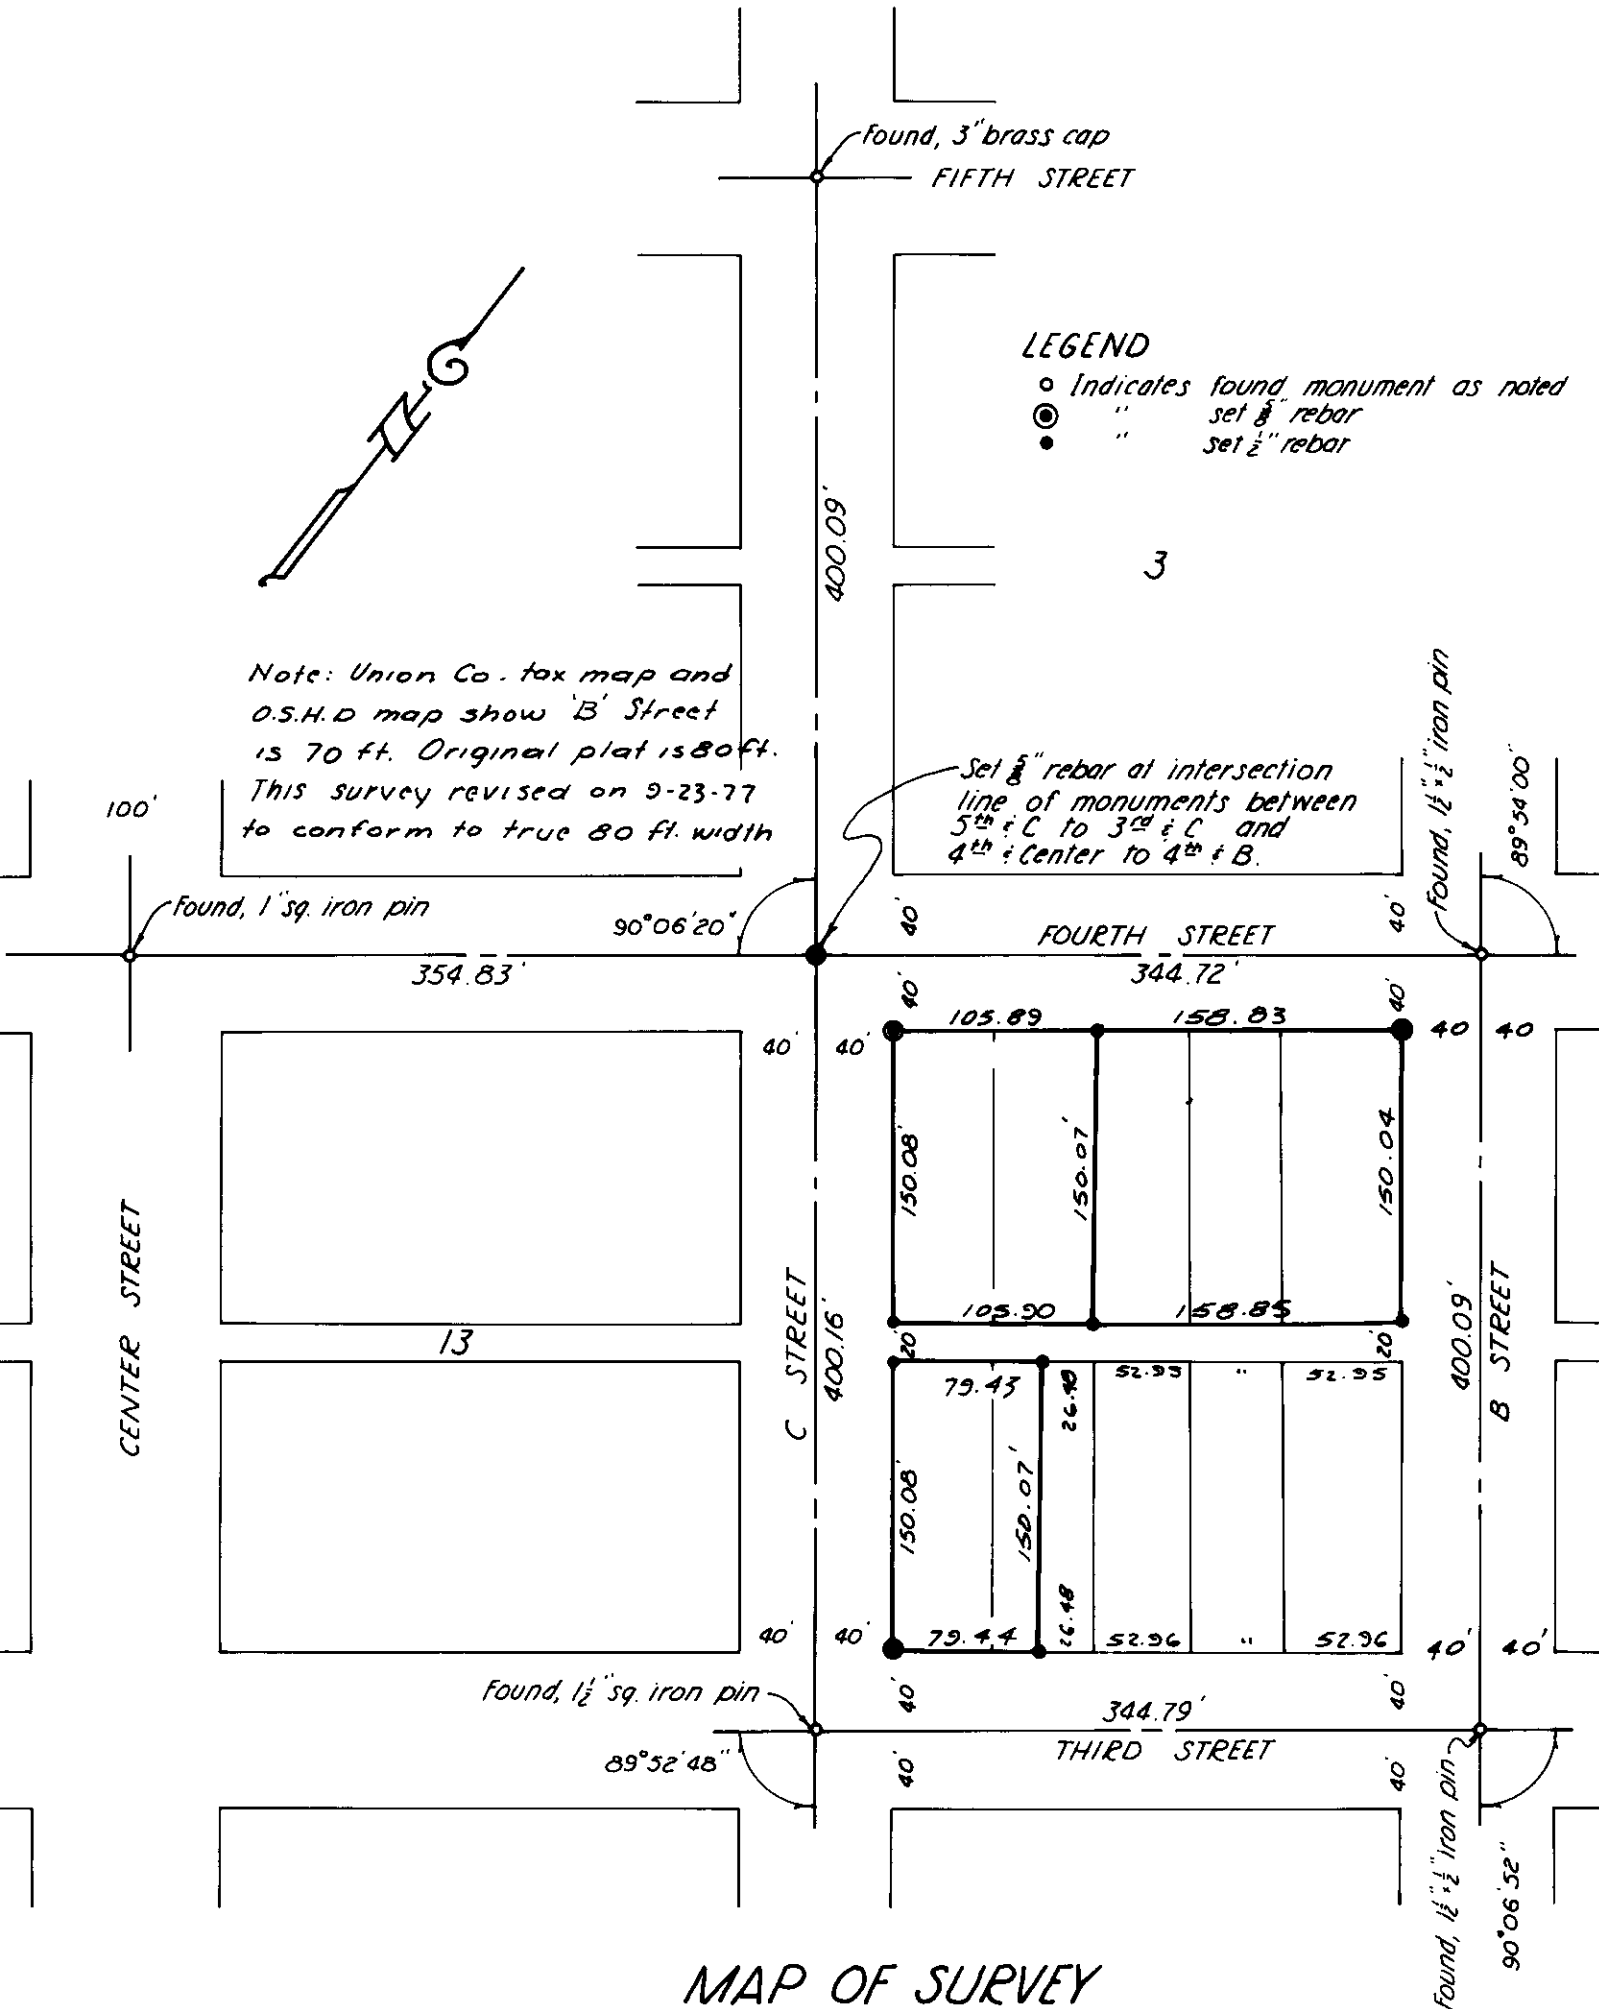

MAP OF SURVEY
LOTS 4,5,6 & W 1/2 LOT 7, BLOCK 14
NORTH POWDER, ORE.

Surveyed Aug. 18, 1977 Scale 1"=100'
 & Sept. 23, 1977
 for Leon Morrison
 & Willard Fordice

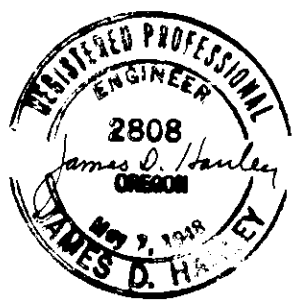

90-77