REFERENCE MATERIAL

PLAT OF NORTH UNION
SURVEY NUMBERS:
83-71
72-77
79-77

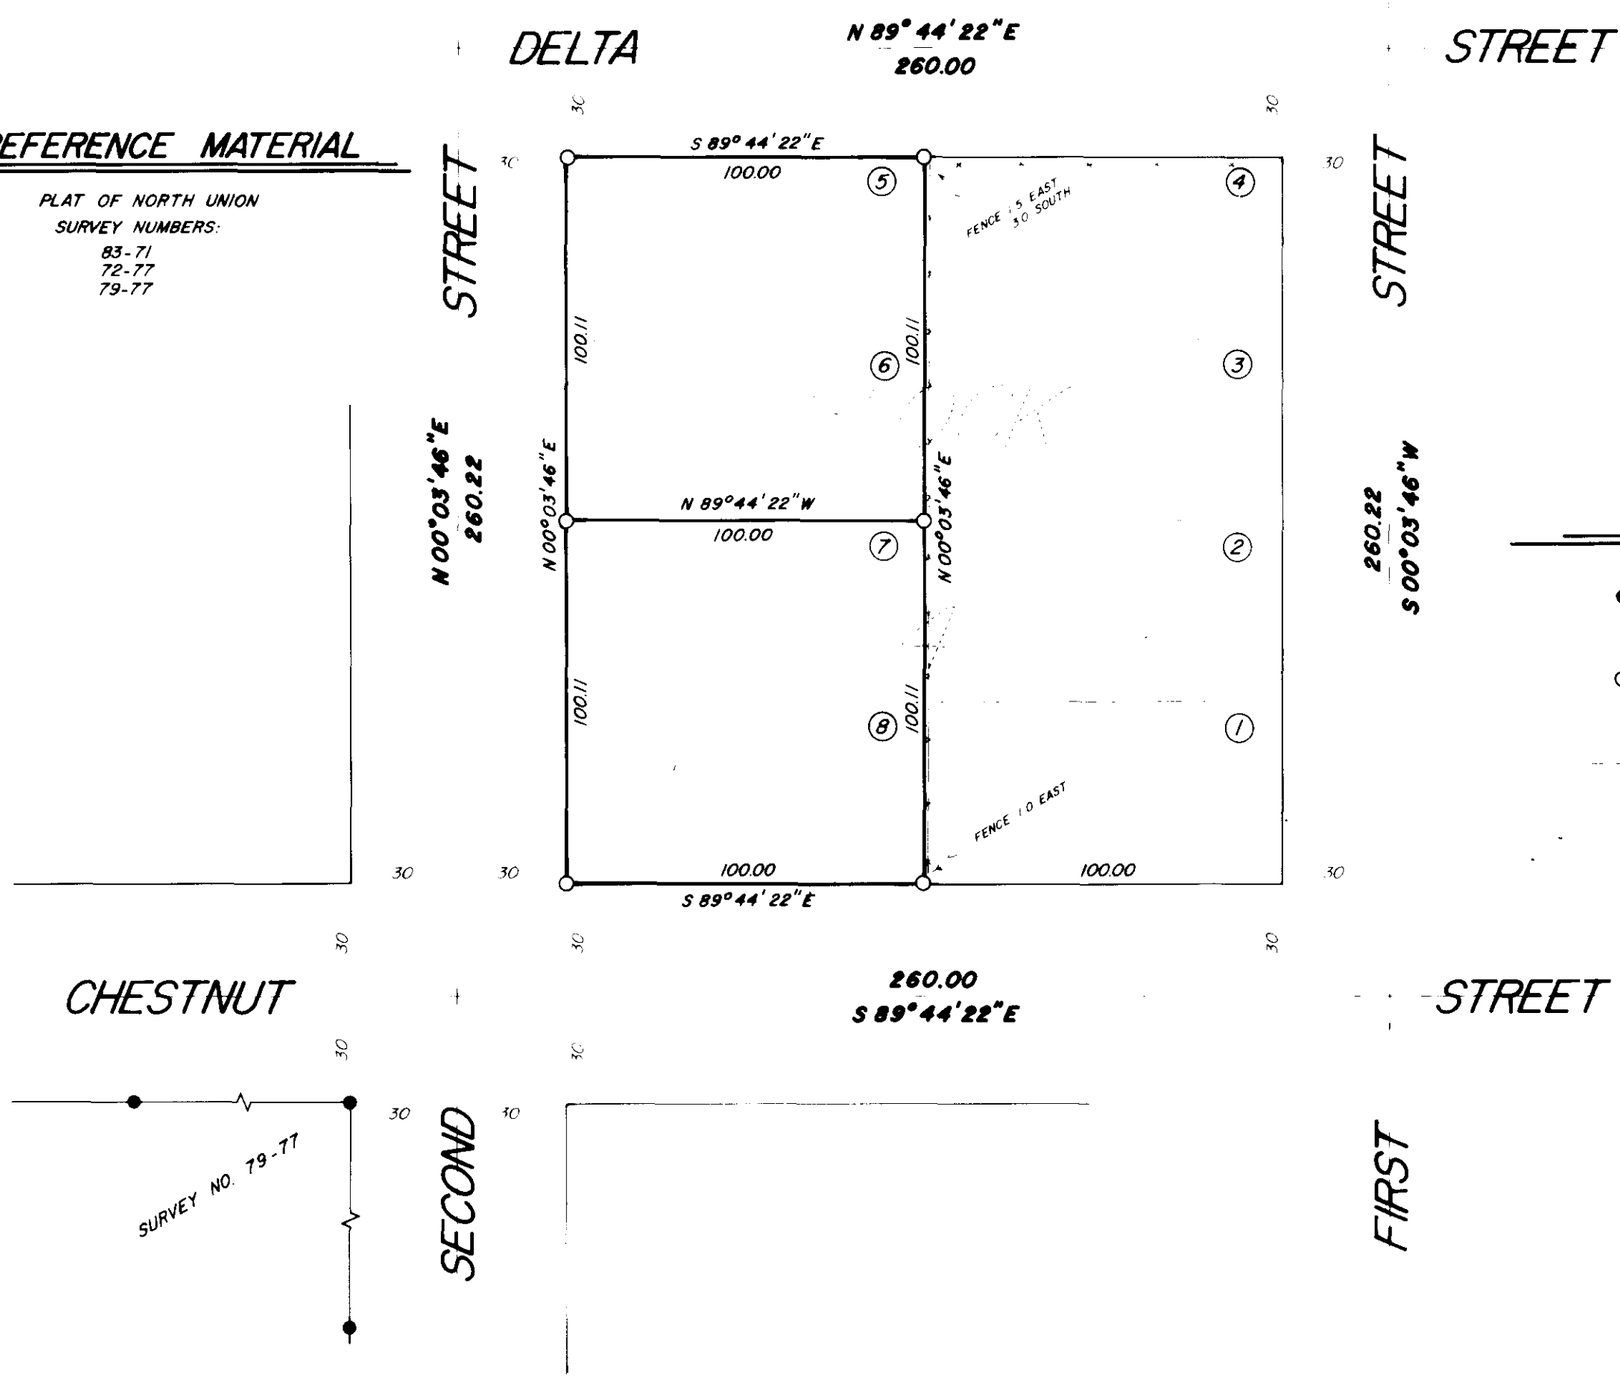

BASIS OF BEARING

SURVEY NO. 72-77

LEGEND

- ● FOUND MONUMENT OF RECORD
- ○ SET 5/8" x 30" IRON PIN WITH PLASTIC CAP MARKED B·G·A SURVEY MARKER
- CENTERLINE STREET
- EXISTING FENCE

REGISTERED PROFESSIONAL LAND SURVEYOR
OREGON JULY 10, 1984
DUANE I. GRIFFITH 644

BAGETT, GRIFFITH & ASSOCIATES
La Grande, Oregon

Map of Survey

LOTS 5,6,7,8, BLOCK 4
NORTH UNION

UNION
UNION COUNTY OREGON

SURVEYED FOR	JOHN CLAWSEN & JACK W. CARR	
SURVEYED BY	d l g	11/77
Scale: 1" = 40'	Drawn by S S Z	11/77

100-77