RECORD of SURVEY
SHEEP CREEK TRACT BOISE CASCADE
SECTION 28, T4N. R40E WM.
UNION COUNTY OREGON

Scale 1" = 1000 **Date 12-14-77**

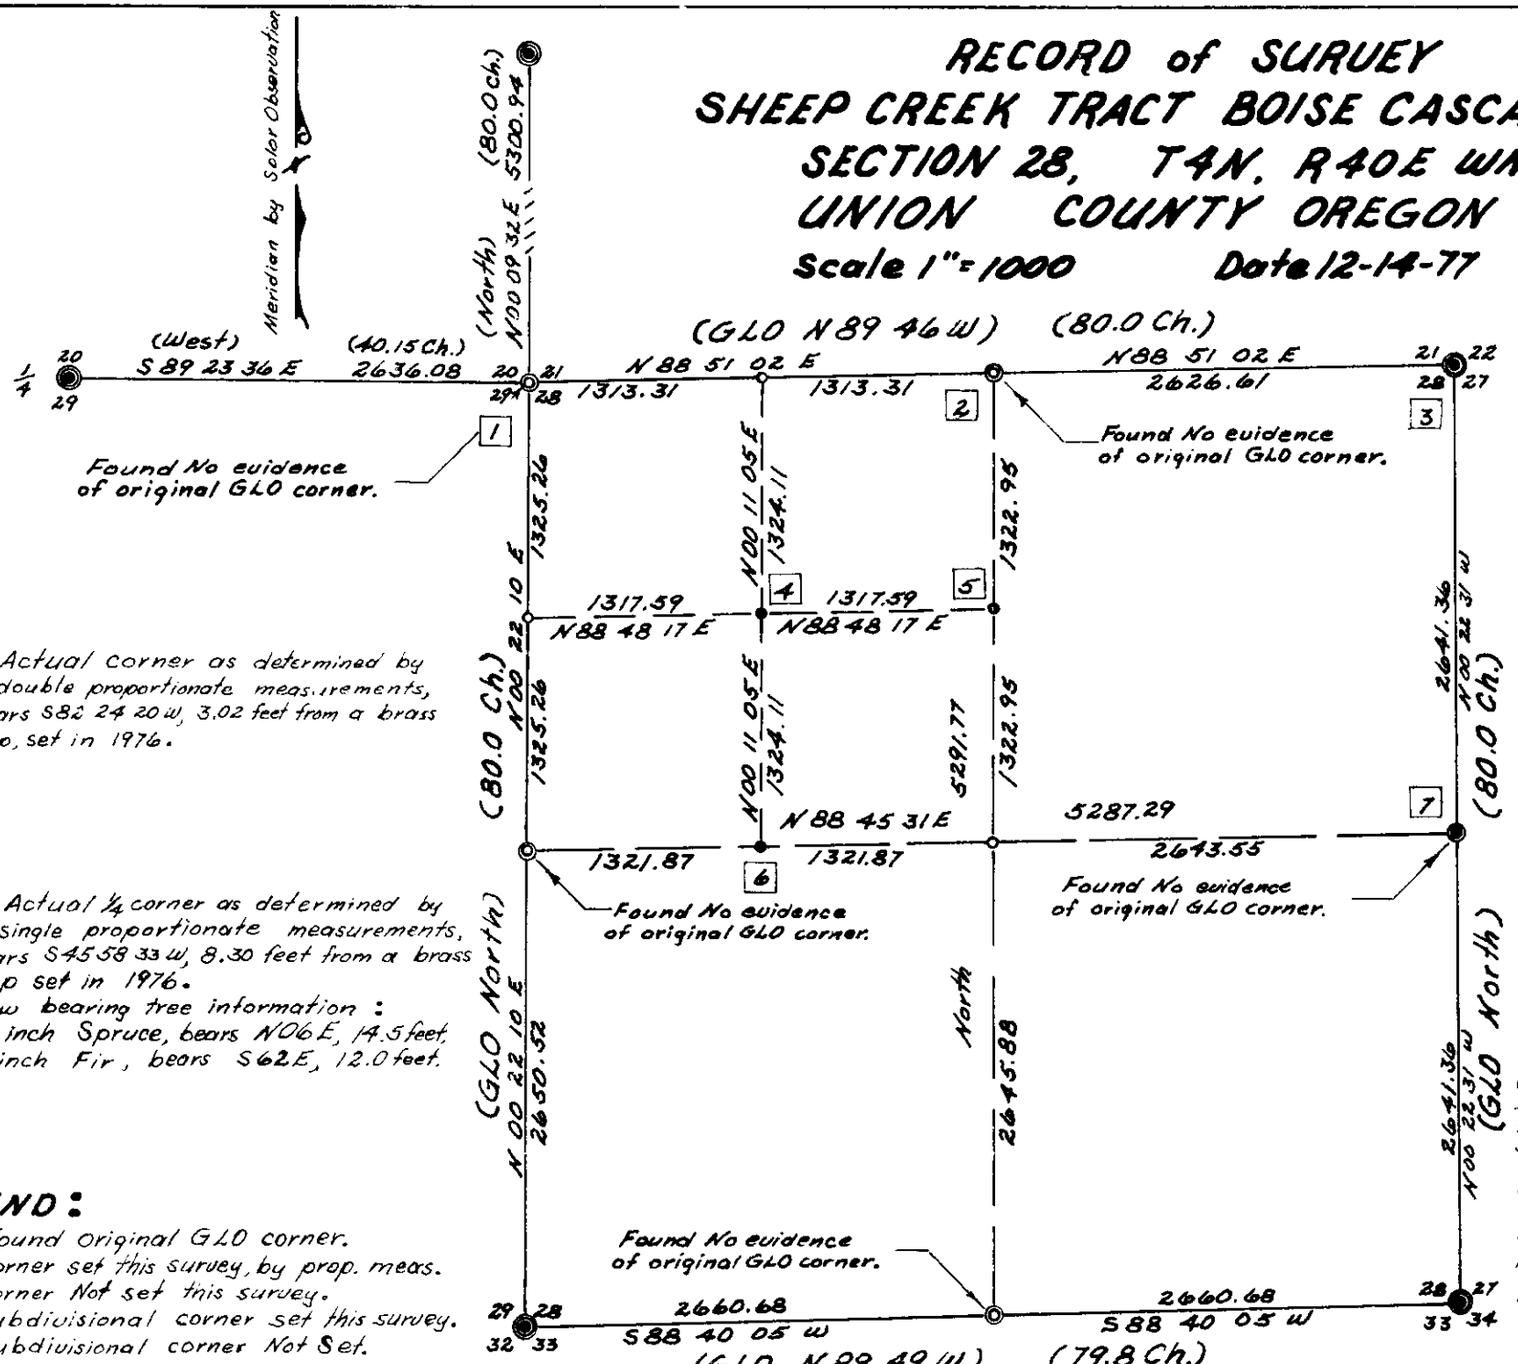

1 Actual corner as determined by double proportionate measurements, bears S 82 24 20 W, 3.02 feet from a brass cap, set in 1976.

2 Actual 1/4 corner as determined by single proportionate measurements, bears S 45 58 33 W, 8.30 feet from a brass cap set in 1976.
New bearing tree information:
10 inch Spruce, bears N 06 E, 14.5 feet.
11 inch Fir, bears S 62 E, 12.0 feet.

3 Found evidence of Original bearing trees, restored corner to its original position, found a brass cap set in 1976, to be N 40 E, 14.7 feet from the actual section corner.
New bearing tree information:
7 inch Fir bears N 29 E, 33.6 feet.
9 inch Spruce bears S 84 E, 52.5 feet.
14 inch Larch bears S 49 W, 45.4 feet.
10 inch Spruce bears N 10 W, 63.6 feet.

4 NW-C-1/16 Sec. 28; 8 inch Spruce, bear N 16 E, 49.0 feet.
10 inch Larch, bears S 63 E, 51.9 feet.

5 N-C-1/16 Sec. 28; 8 inch Spruce bears S 43 W, 25.3 feet
12 inch L.P. Pine bears S 31 E 19.9 feet.

6 W-C-1/16 Sec. 28; 11 inch Larch bears N 29 W 31.3 feet.
8 inch Larch bears S 82 E, 12.2 feet.

7 Found no acceptable evidence of original corner, Set 1/4 cor. by single proportionate measurements.
17 inch Larch bears N 71 W, 44.1 feet (New)
9 inch Larch bears S 22 E, 26.6 feet (New)

LEGEND:

- ◉ Found original GLO corner.
- ◉ Corner set this survey, by prop. meas.
- ◎ Corner Not set this survey.
- ● Subdivisional corner set this survey.
- ○ Subdivisional corner Not Set.

CERTIFICATE of SURVEY:

I, James H. Hamilton being a registered Land Surveyor in the State of Oregon, do hereby certify that this plat correctly represents a survey made by me or under my direction, for Boise Cascade Lumber Co., using public and private records and in conformance with the BLM manual and the laws of the State of Oregon.

James H. Hamilton
OR LS 645

REGISTERED PROFESSIONAL LAND SURVEYOR
JAMES H. HAMILTON