


BELLWOOD AVENUE

BEAKMAN STREET

ST

STREET

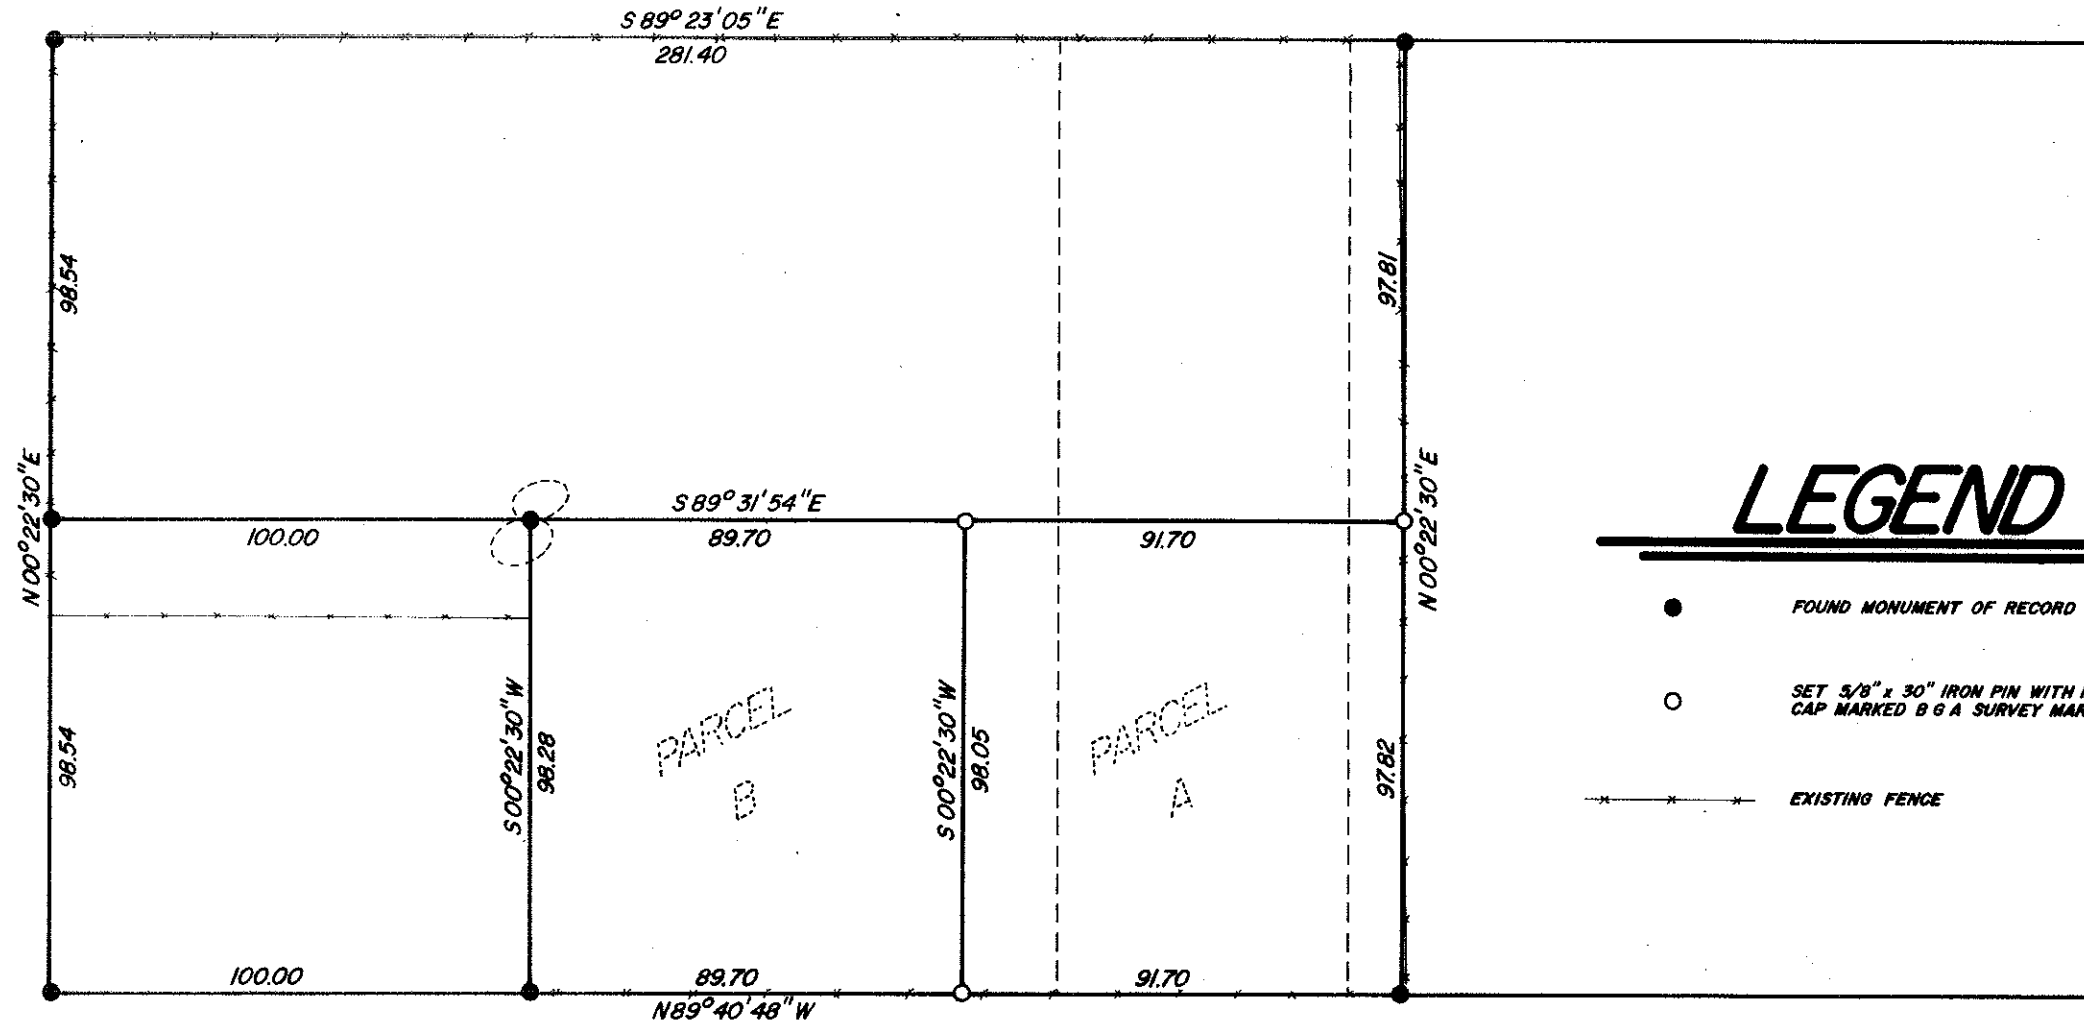


CENTER STREET

STREET

BELLWOOD

GALE

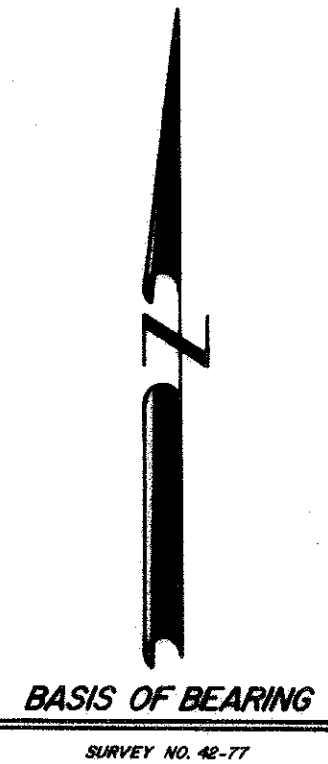

LEGEND

- FOUND MONUMENT OF RECORD
- SET 5/8" x 30" IRON PIN WITH PLASTIC CAP MARKED B G A SURVEY MARKER
- * * * — EXISTING FENCE

REFERENCE MATERIAL
SURVEY NO. 42-77

REGISTERED
PROFESSIONAL
LAND SURVEYOR

Gregory T. Blackman
OREGON
JULY 13, 1978
GREGORY T. BLACKMAN
991

BAGETT, GRIFFITH & ASSOCIATES

La Grande, Oregon

Map of Survey

A PORTION OF BLOCKS 7 AND 8 IN
THE ORIGINAL TOWN OF UNION

UNION
UNION COUNTY, OREGON

SURVEYED FOR	RANDAL BROOKSHIRE	
SURVEYED BY	G T B	1 / 78
Scale: 1" = 40'	Drawn by: S S Z	1 / 78

81-4