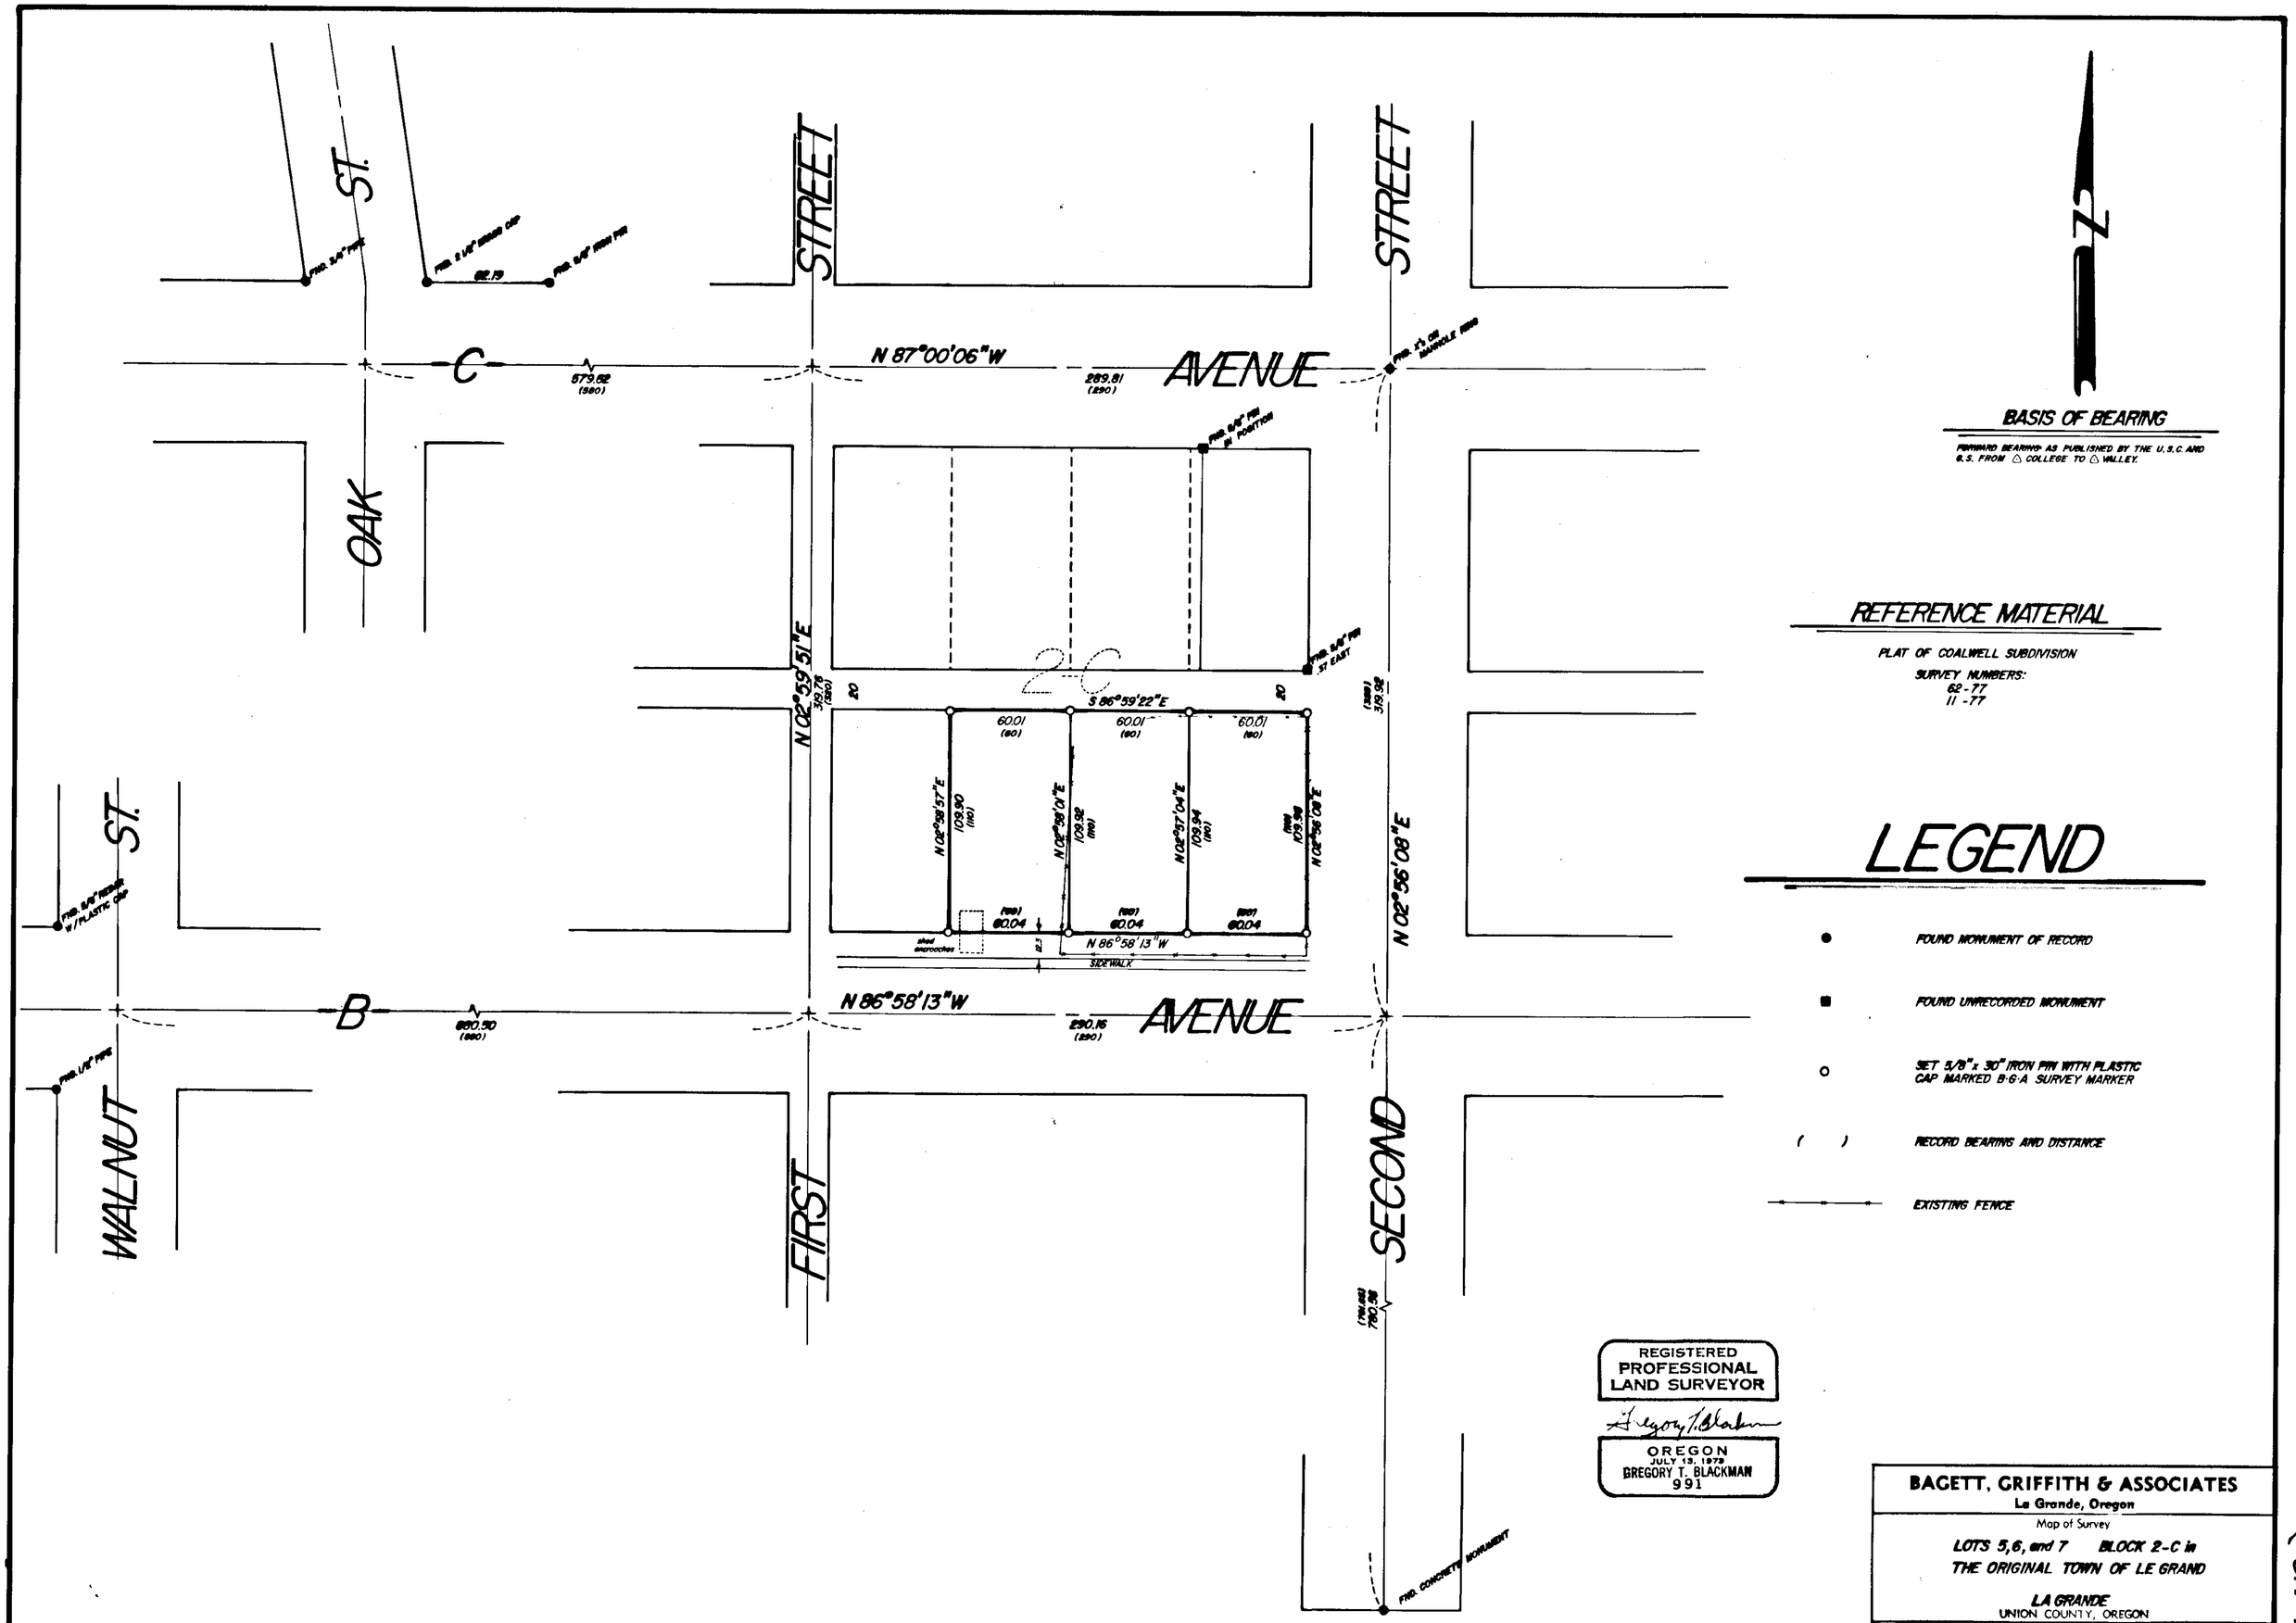

BASIS OF BEARING

FORWARD BEARINGS AS PUBLISHED BY THE U.S.C. AND G.S. FROM △ COLLEGE TO △ WALLEY.

REFERENCE MATERIAL

PLAT OF COALWELL SUBDIVISION

SURVEY NUMBERS:
62-77
11-77

LEGEND

- ● FOUND MONUMENT OF RECORD
- ■ FOUND UNRECORDED MONUMENT
- ○ SET 5/8" x 30" IRON PIN WITH PLASTIC CAP MARKED B·G·A SURVEY MARKER
- ( ) RECORD BEARING AND DISTANCE
- EXISTING FENCE

REGISTERED
PROFESSIONAL
LAND SURVEYOR

Gregory T. Blackman

OREGON
JULY 13, 1979
GREGORY T. BLACKMAN
991

BAGETT, GRIFFITH & ASSOCIATES
La Grande, Oregon

Map of Survey

LOTS 5, 6, and 7 BLOCK 2-C in
THE ORIGINAL TOWN OF LE GRAND

LA GRANDE
UNION COUNTY, OREGON

SURVEYED FOR	PHINNEY - SCHWARZ - BROGOITTI	
SURVEYED BY	GTB	2/78
Scale: 1" = 50'	Drawn by: SSZ	2/78

5-78