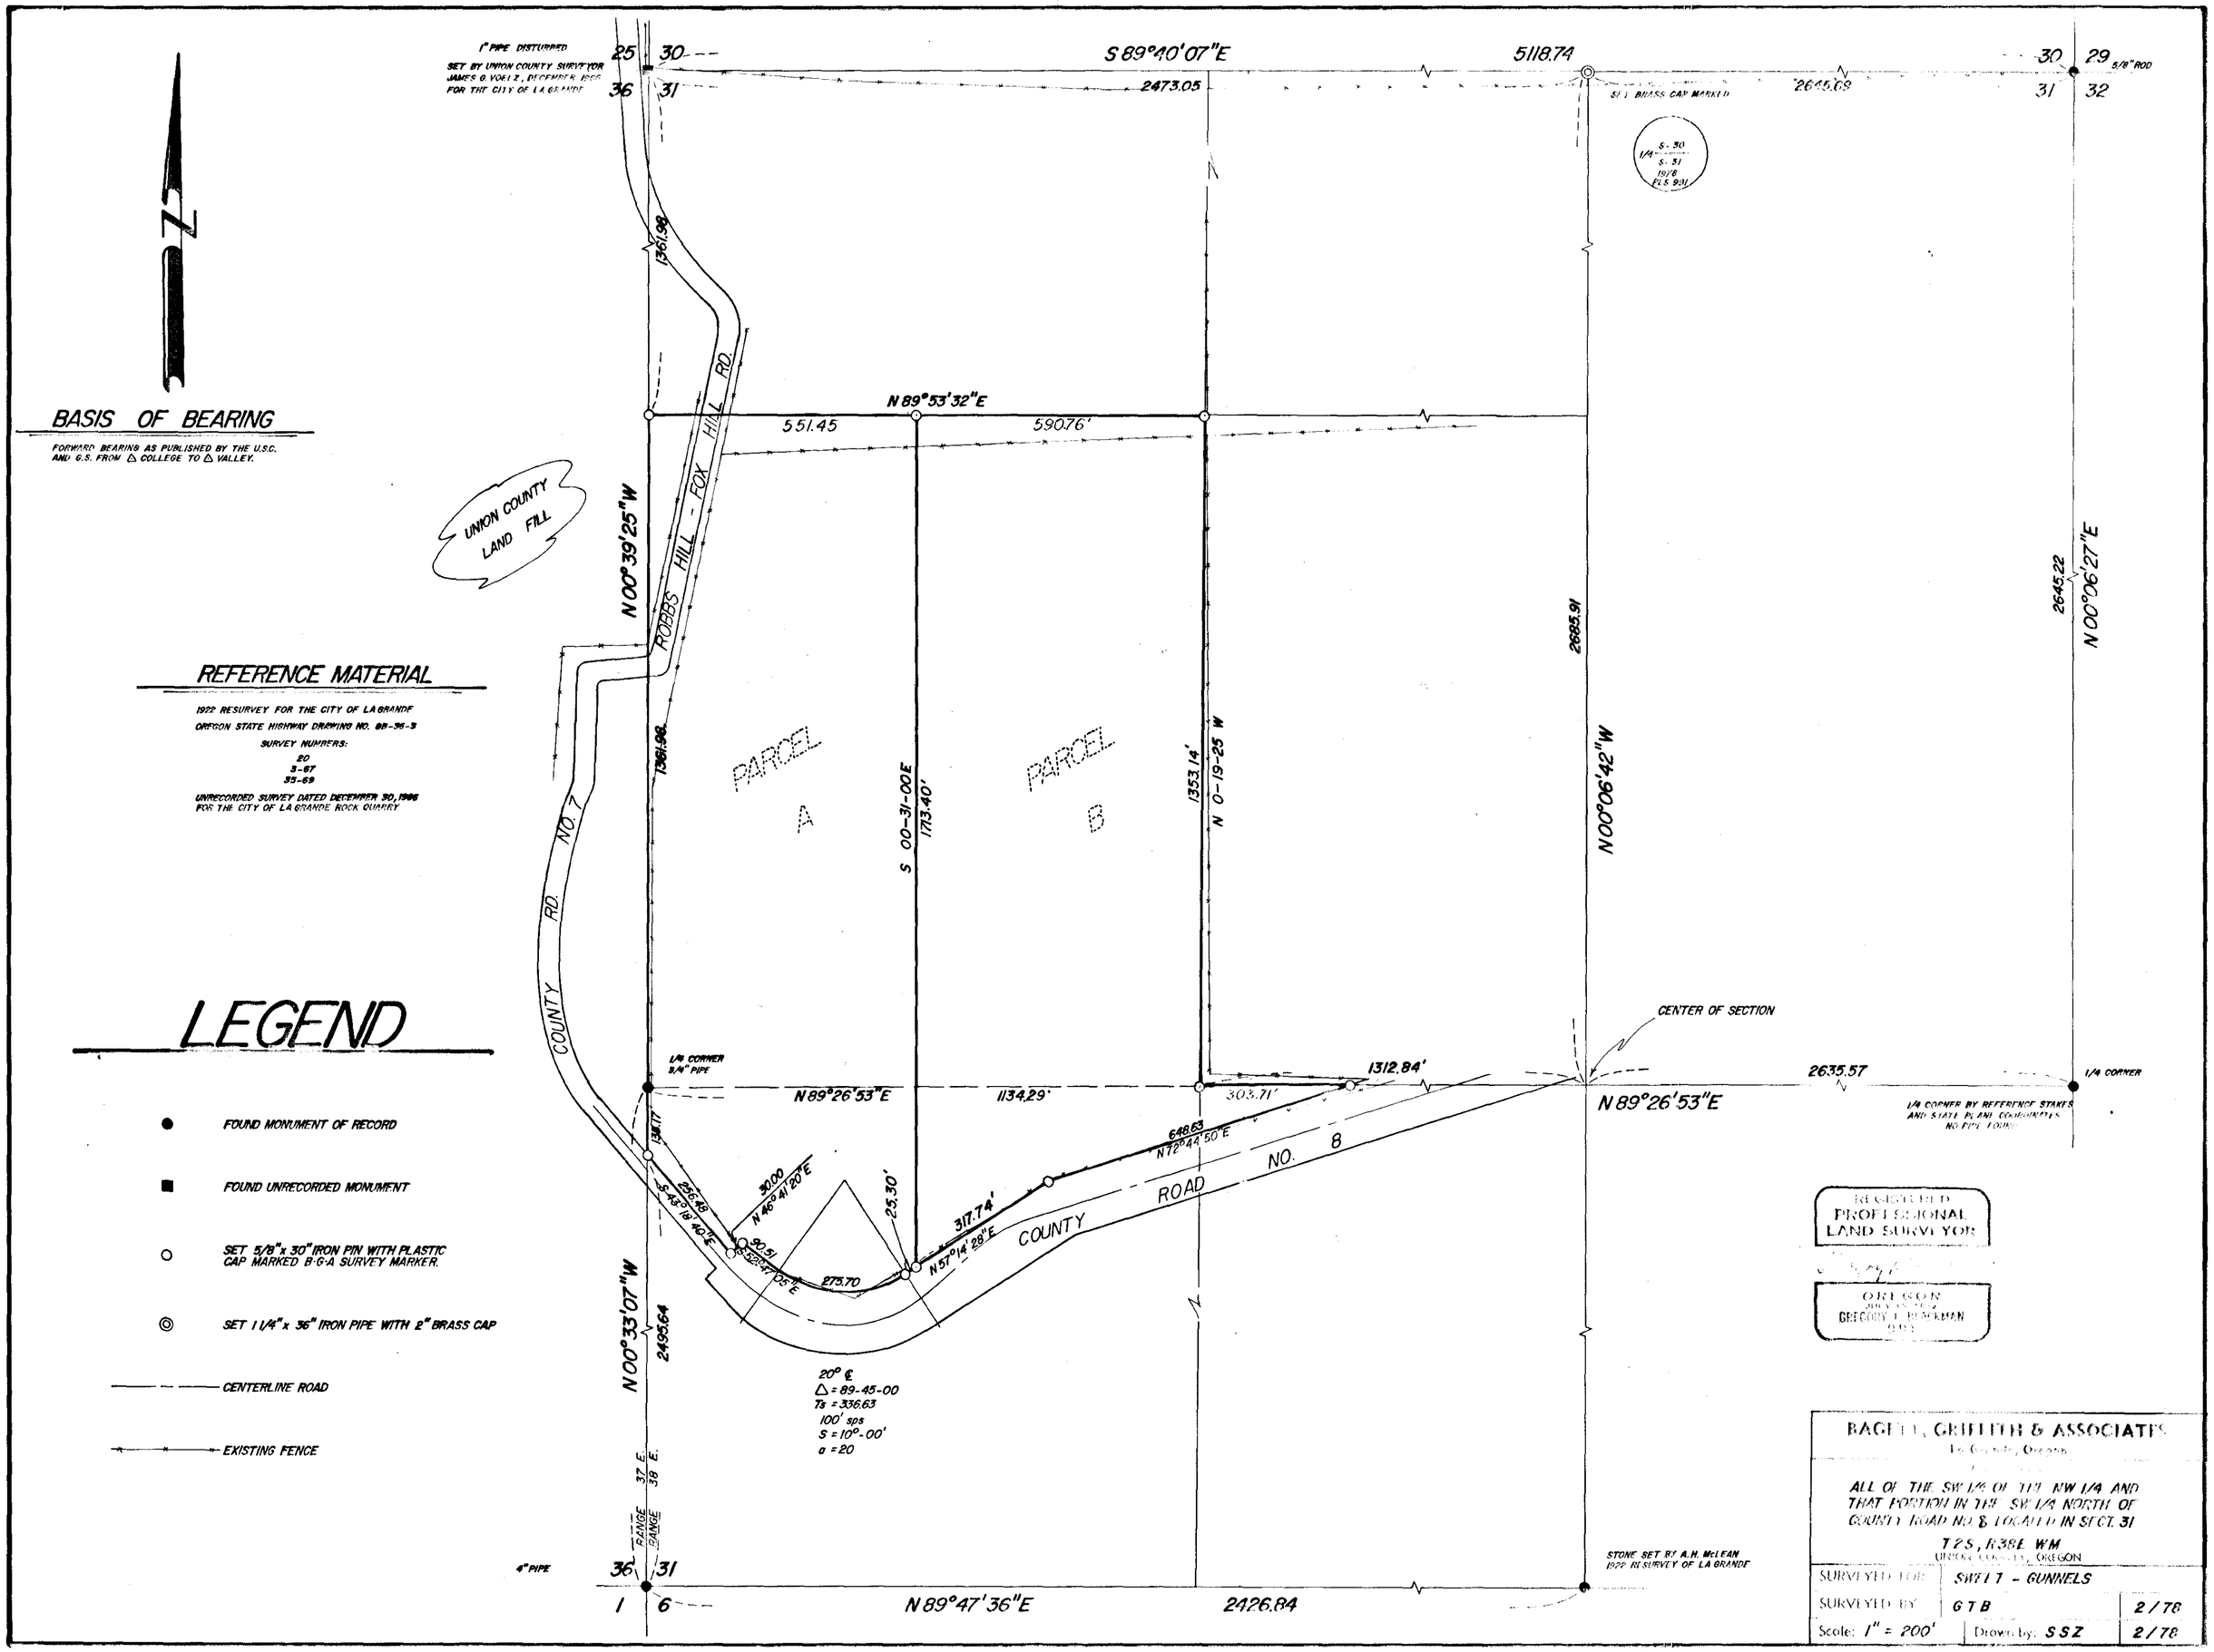

1" PIPE DISTURBED
SET BY UNION COUNTY SURVEYOR JAMES G. VOELZ, DECEMBER 1966 FOR THE CITY OF LA GRANDE
S 89°40'07"E
5118.74
2473.05
2645.69
5/8" ROD
SET BRASS CAP MARKED
S-30
1/4
S-31
1978
PLS 991
BASIS OF BEARING
FORWARD BEARING AS PUBLISHED BY THE U.S.C. AND G.S. FROM △ COLLEGE TO △ VALLEY.
UNION COUNTY LAND FILL
N 89°53'32"E
551.45
590.76'
N 00°39'25"W
ROBBS HILL - FOX HILL RD.
1361.98
PARCEL A
PARCEL B
S 00-31-00E
1713.40'
1353.14'
N 0-19-25 W
2685.91
N 00°06'42"W
2645.22
N 00°06'27"E
REFERENCE MATERIAL
1922 RESURVEY FOR THE CITY OF LA GRANDE
OREGON STATE HIGHWAY DRAWING NO. 88-36-3
SURVEY NUMBERS:
20
3-67
35-69
UNRECORDED SURVEY DATED DECEMBER 30, 1966 FOR THE CITY OF LA GRANDE ROCK QUARRY
COUNTY RD. NO. 7
CENTER OF SECTION
1/4 CORNER 3/4" PIPE
N 89°26'53"E
1134.29'
303.71'
1312.84'
2635.57
1/4 CORNER
1/4 CORNER BY REFERENCE STAKES AND STATE PLANE COORDINATES NO PIPE FOUND
N 89°26'53"E
648.63
N 72°44'50"E
COUNTY ROAD NO. 8
317.74'
N 57°14'28"E
25.30'
30.00
N 46°41'20"E
256.48
S 43°18'40"E
90.51
S 52°47'05"E
275.70
N 00°33'07"W
2495.64
20° ℄
△ = 89-45-00
Ts = 336.63
100' sps
S = 10°-00'
a = 20
RANGE 37 E.
RANGE 38 E.
4" PIPE
N 89°47'36"E
2426.84
STONE SET BY A.H. McLEAN 1922 RESURVEY OF LA GRANDE
LEGEND
FOUND MONUMENT OF RECORD
FOUND UNRECORDED MONUMENT
SET 5/8" x 30" IRON PIN WITH PLASTIC CAP MARKED B-G-A SURVEY MARKER.
SET 1 1/4" x 36" IRON PIPE WITH 2" BRASS CAP
CENTERLINE ROAD
EXISTING FENCE
REGISTERED PROFESSIONAL LAND SURVEYOR
OREGON
GREGORY L. BLACKMAN
BAGELL, GRIFFITH & ASSOCIATES
La Grande, Oregon
ALL OF THE SW 1/4 OF THE NW 1/4 AND THAT PORTION IN THE SW 1/4 NORTH OF COUNTY ROAD NO. 8 LOCATED IN SECT. 31
T2S, R38E WM
UNION COUNTY, OREGON
SURVEYED FOR SWEET - GUNNELS
SURVEYED BY GTB 2/78
Scale: 1" = 200' Drawn by: SSZ 2/78

6-78