PLAT
of survey for

DUANE H. STICKNEY

1106 WALL STREET
LA GRANDE, OREGON, 97850

SURVEY OF LOTS 12, 13, 14, 15 and 16 in BLOCK 27 of RIVERSIDE ADDITION
LA GRANDE, UNION COUNTY, OREGON

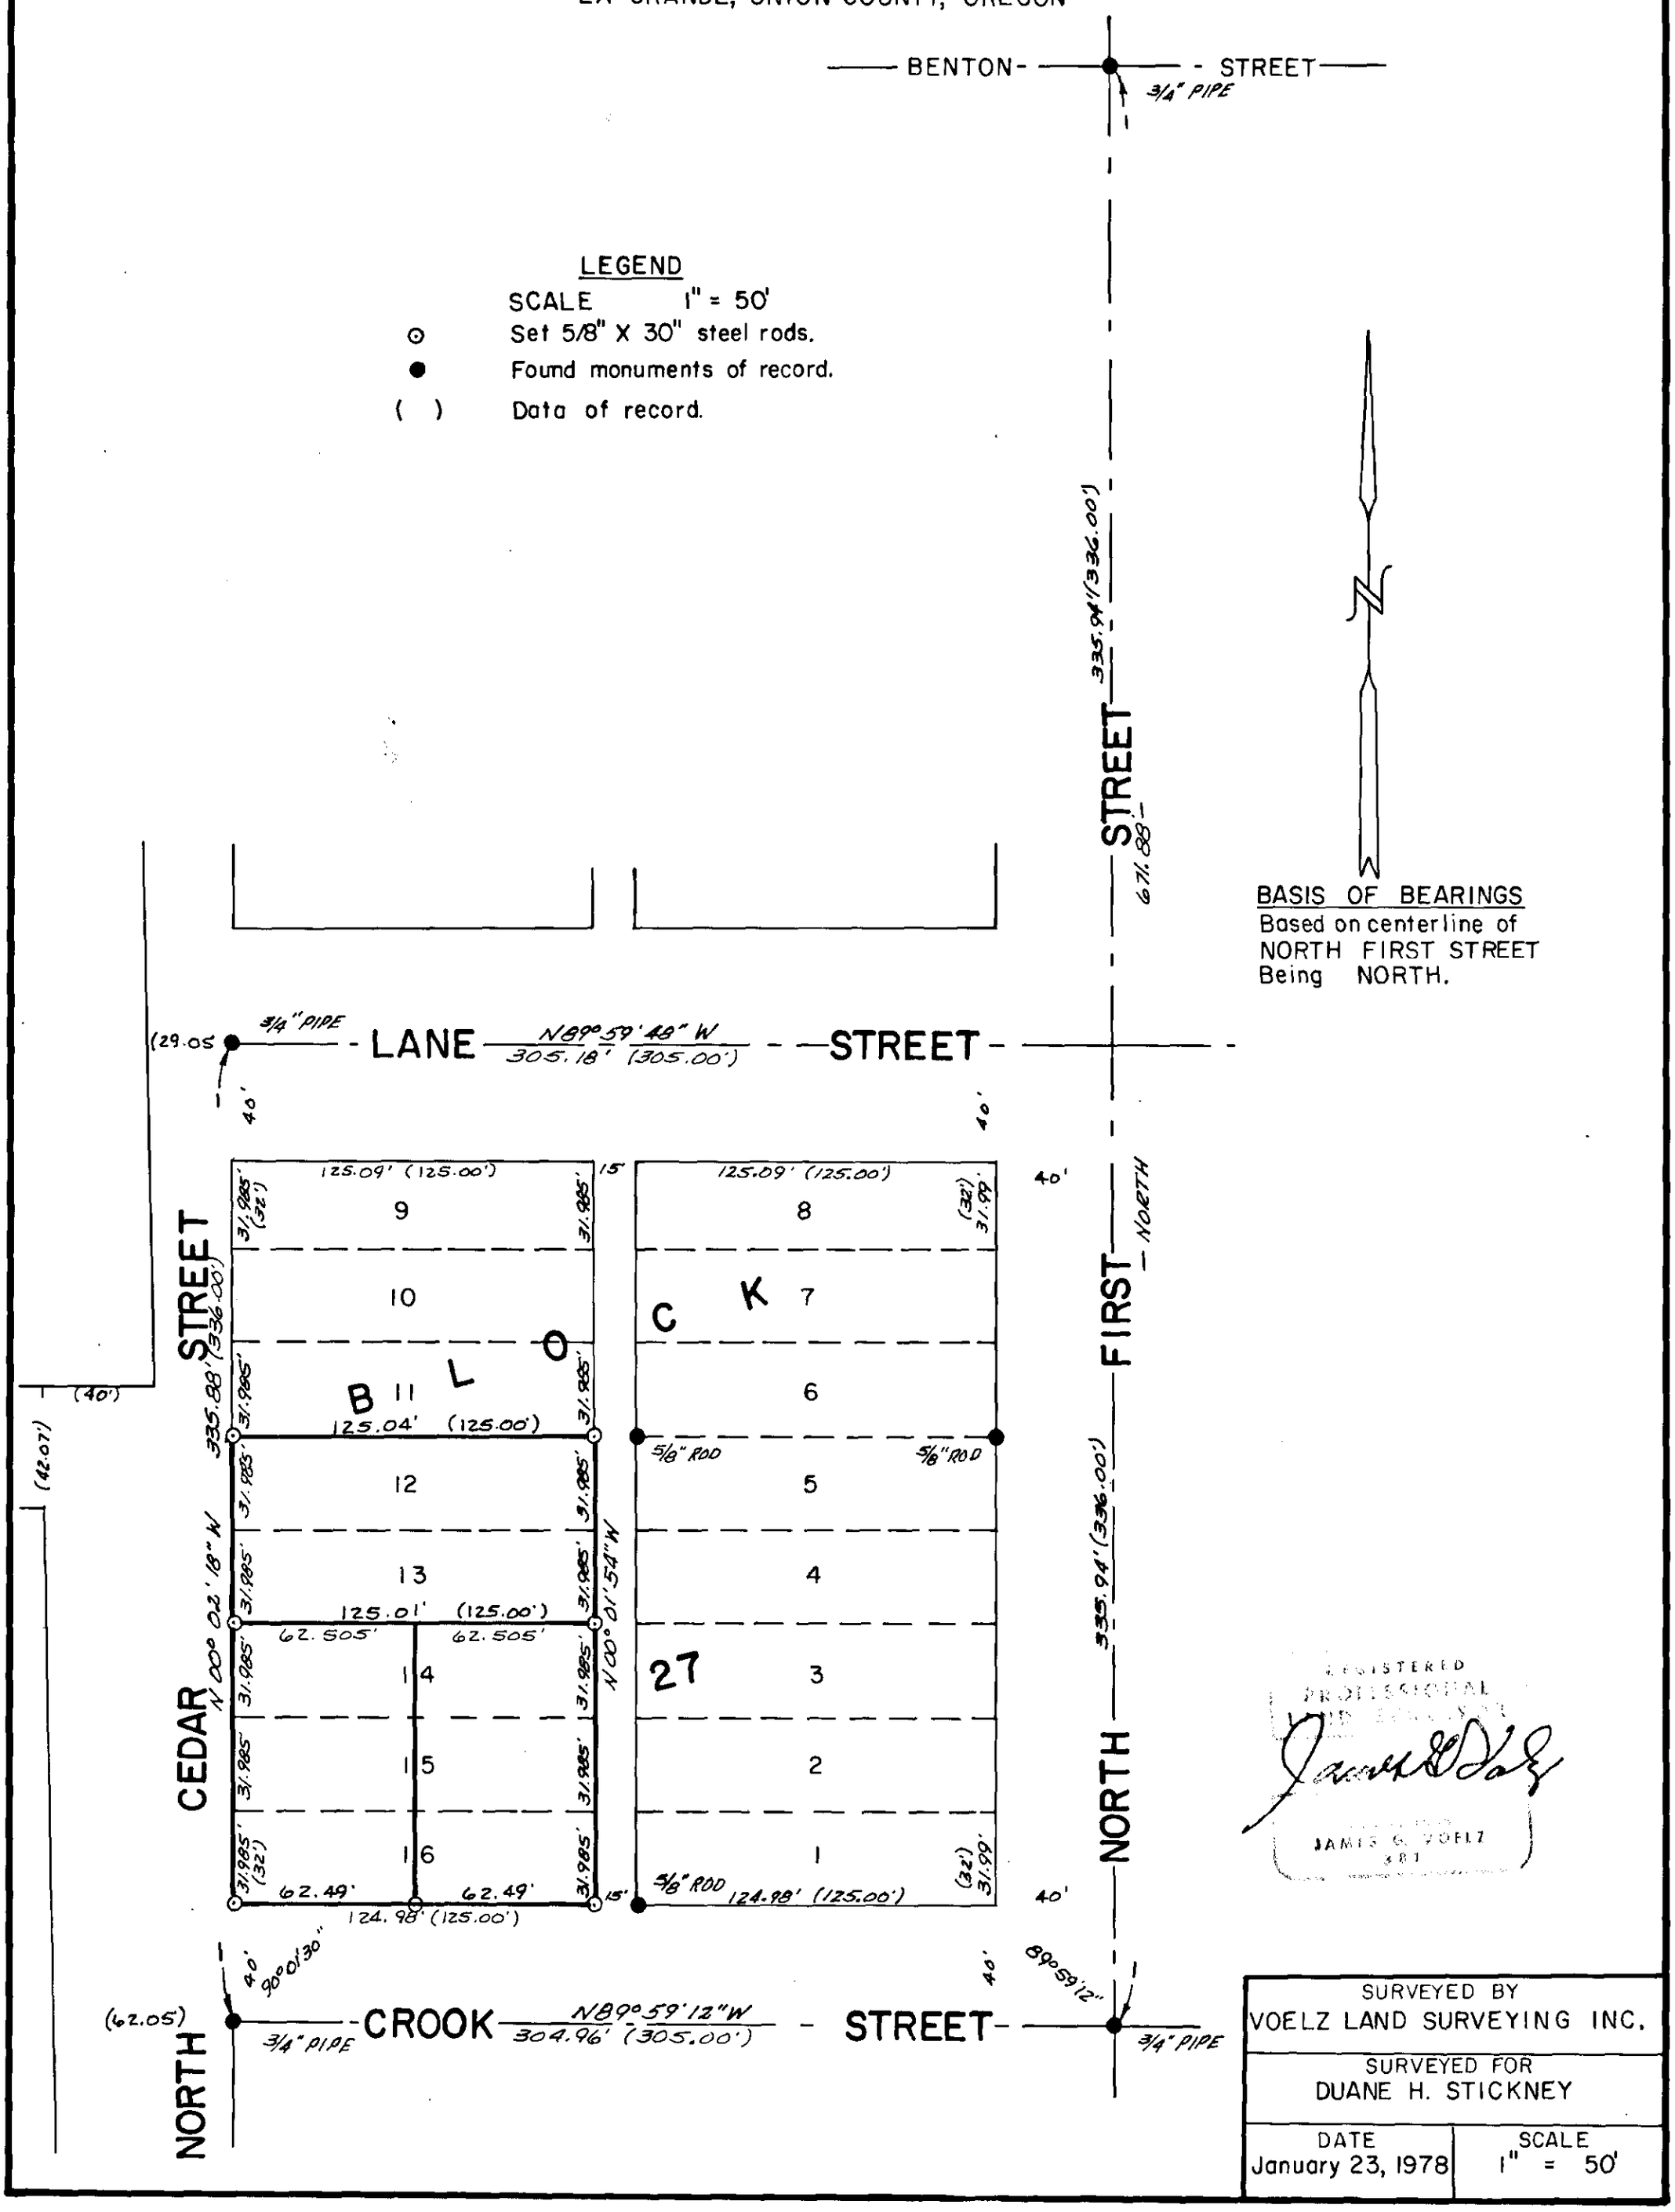

SURVEYED BY	
VOELZ LAND SURVEYING INC.	
SURVEYED FOR	
DUANE H. STICKNEY	
DATE	SCALE
January 23, 1978	1" = 50'

7-78