

(JN 282)


FOR: MOODENBAUGH, GLENN D - MYRTLE  
P.O. BOX 416 ELGIN, OREGON. 97827  
DEED: MF 59486

MAP OF FIELD SURVEY  
LOCATED IN N.W.1/4, N.E.1/4, SEC. 15, TWP. 1N, R.39 E; W.M.  
UNION COUNTY, OREGON.

DATE: FEBRUARY 24 1978  
BASIS OF BEARINGS: SOUTH LINE, SECTION 10.

SCALE: 1"=60'

PREPARED BY: E.O.L.S. — P.L.S. NO. 374

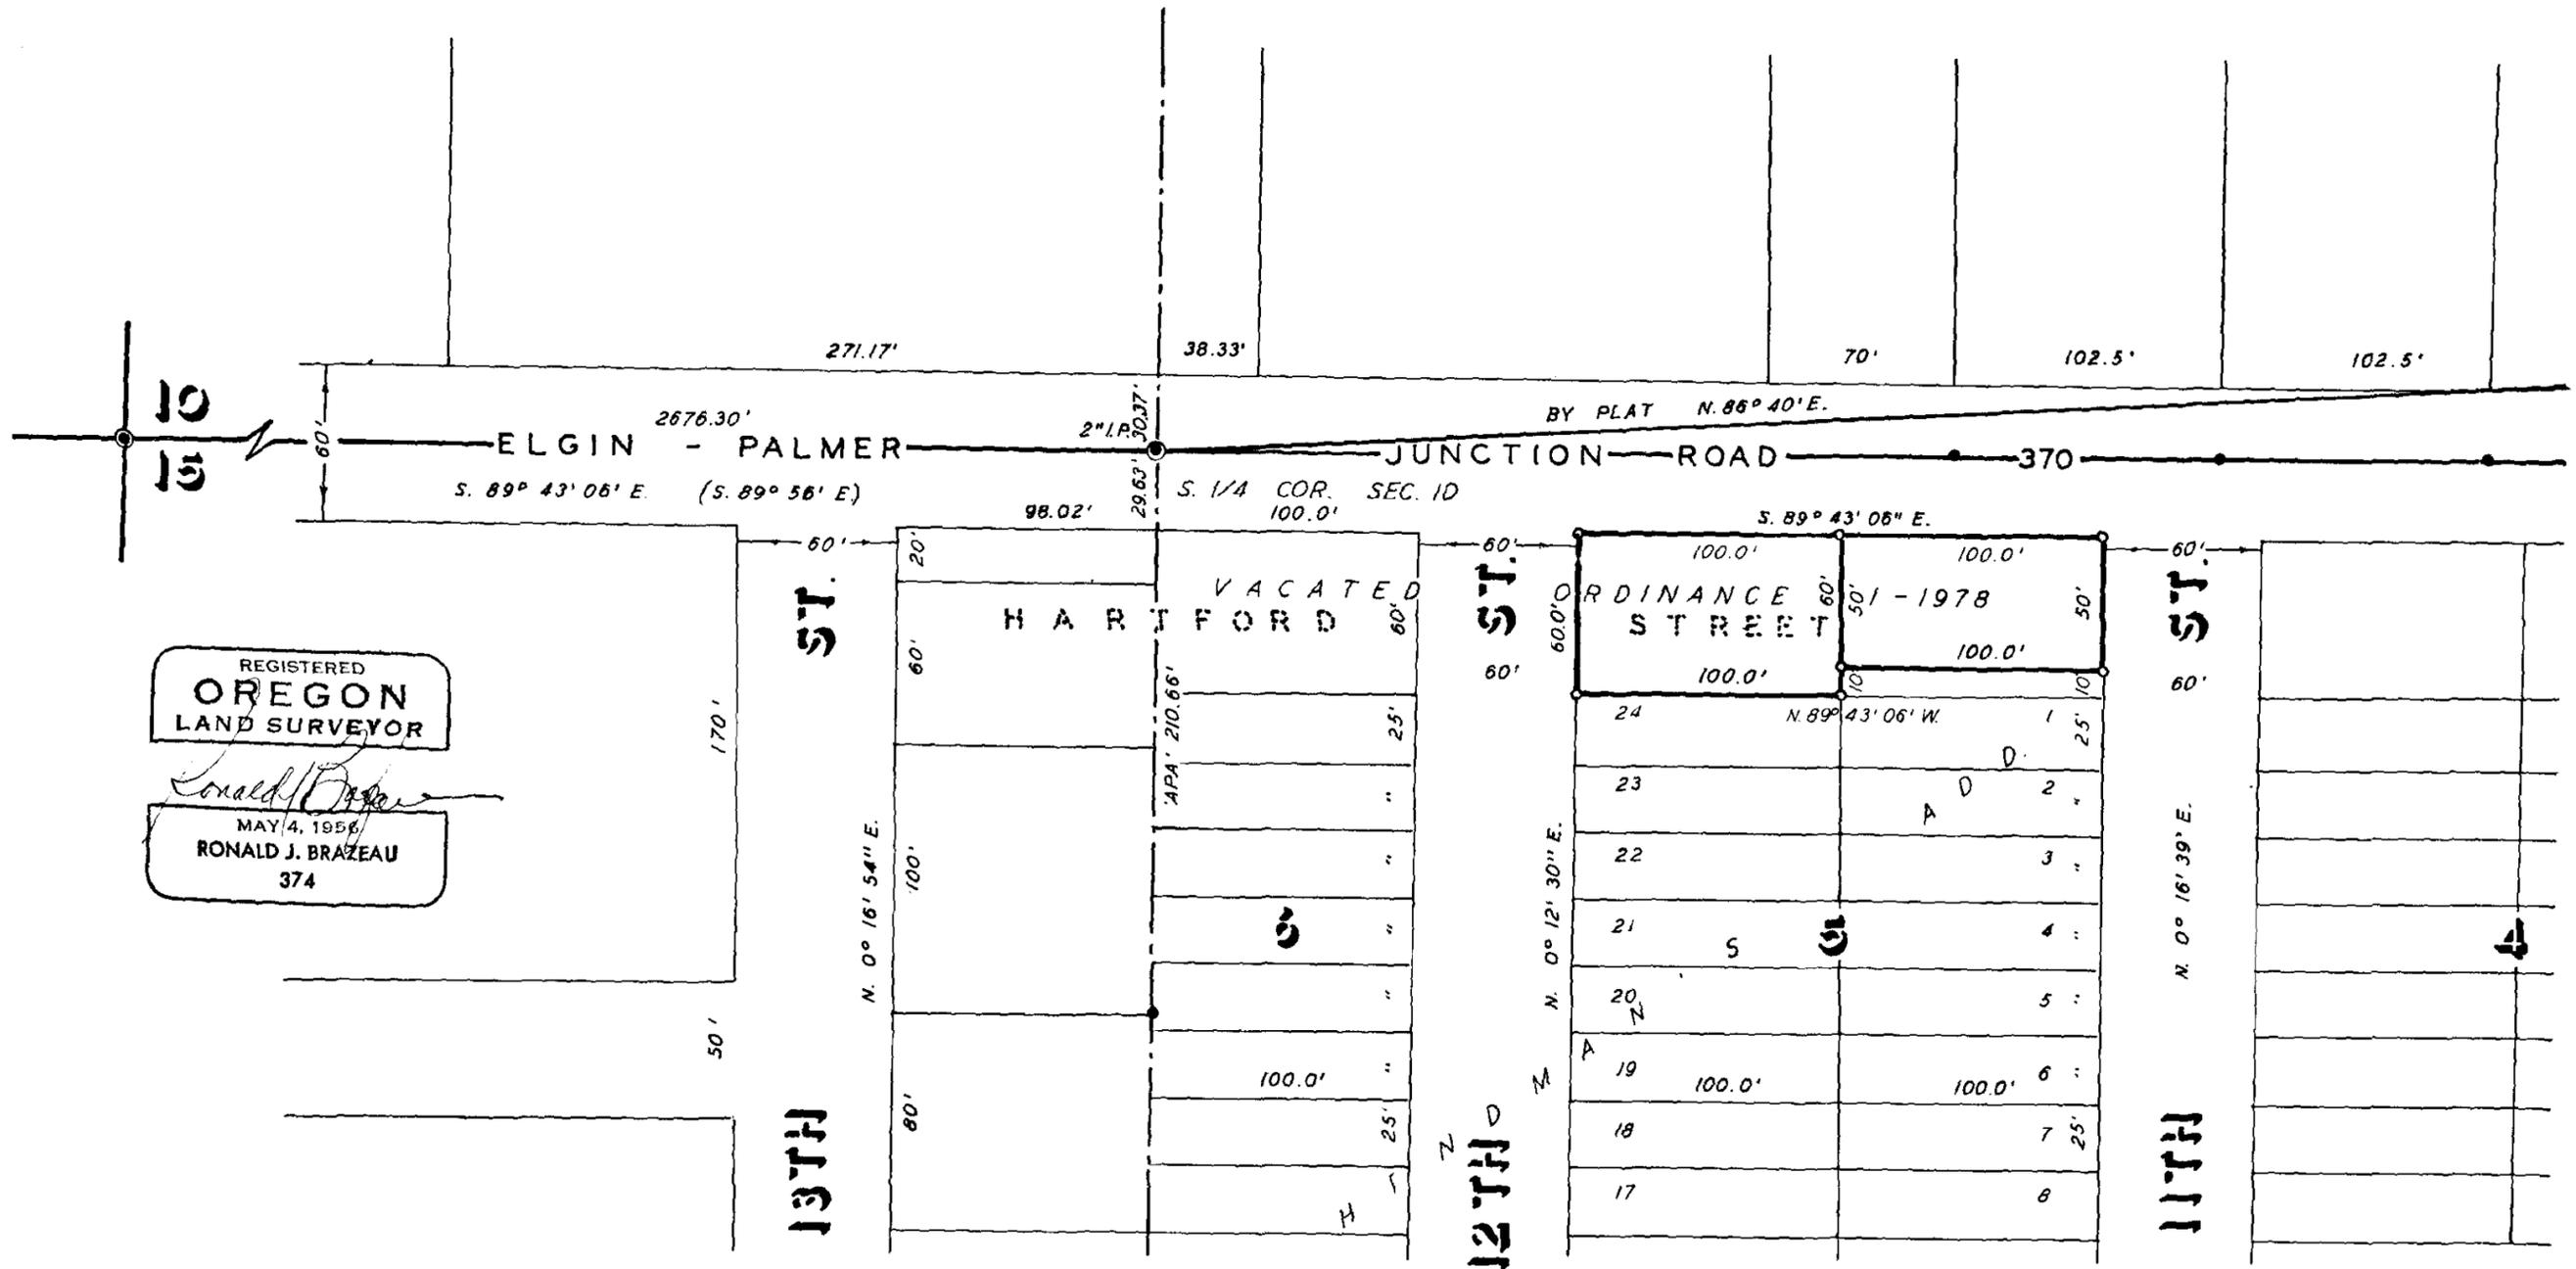

REGISTERED  
OREGON  
LAND SURVEYOR

*Ronald J. Brazeau*  
MAY 4, 1956  
RONALD J. BRAZEAU  
374

15-78