

MAP OF FIELD SURVEY
 LOCATED IN N.E. 1/4, OF S.W. 1/4, OF SECTION 15, TWP 1N., R.39 E.; W.M.
 UNION COUNTY OREGON (ELGIN)


JN 284

DATE: 3-1-1978
 ORIGIN OF BEARINGS: WEST LINE OF 12TH STREET
 PREPARED BY: EOLS - PLS NO.374

SCALE: 1"=60'
 ○ SET 1P
 ● FND.

FOR: MARTIN, AUSTIN V., AND KATHRYN C.
 1390 ALDER STREET ELGIN, OREGON 97827
 DEED REF. MF52141

REGISTERED
OREGON
 LAND SURVEYOR
Ronald J. Brazfa
 MAY 4, 1956
 RONALD J. BRAZFAU
 374

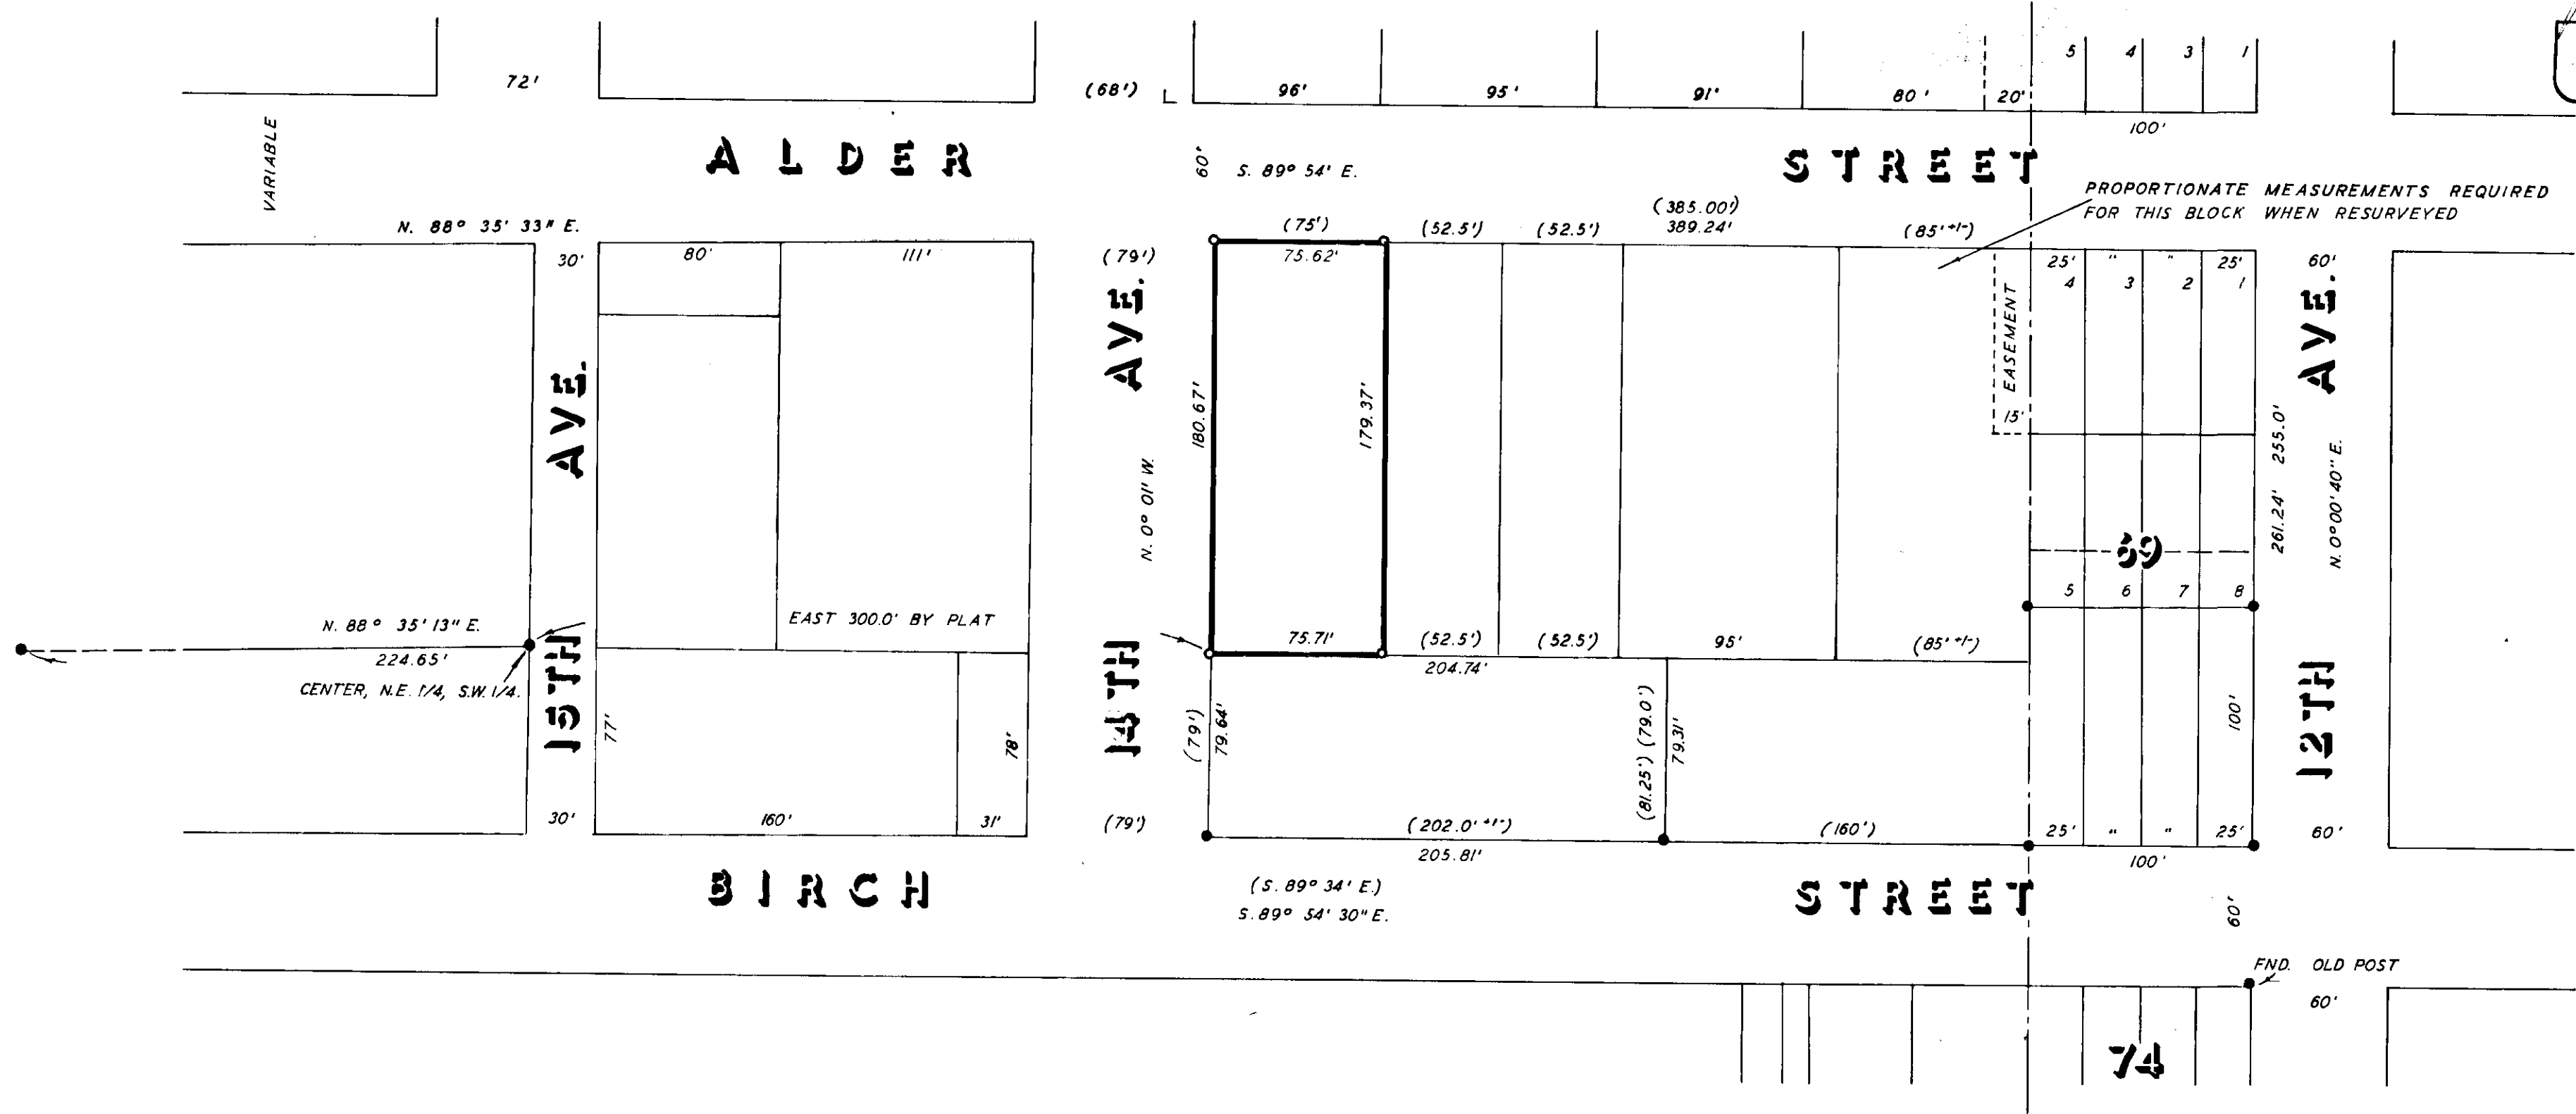

16-78