


COVE AVE

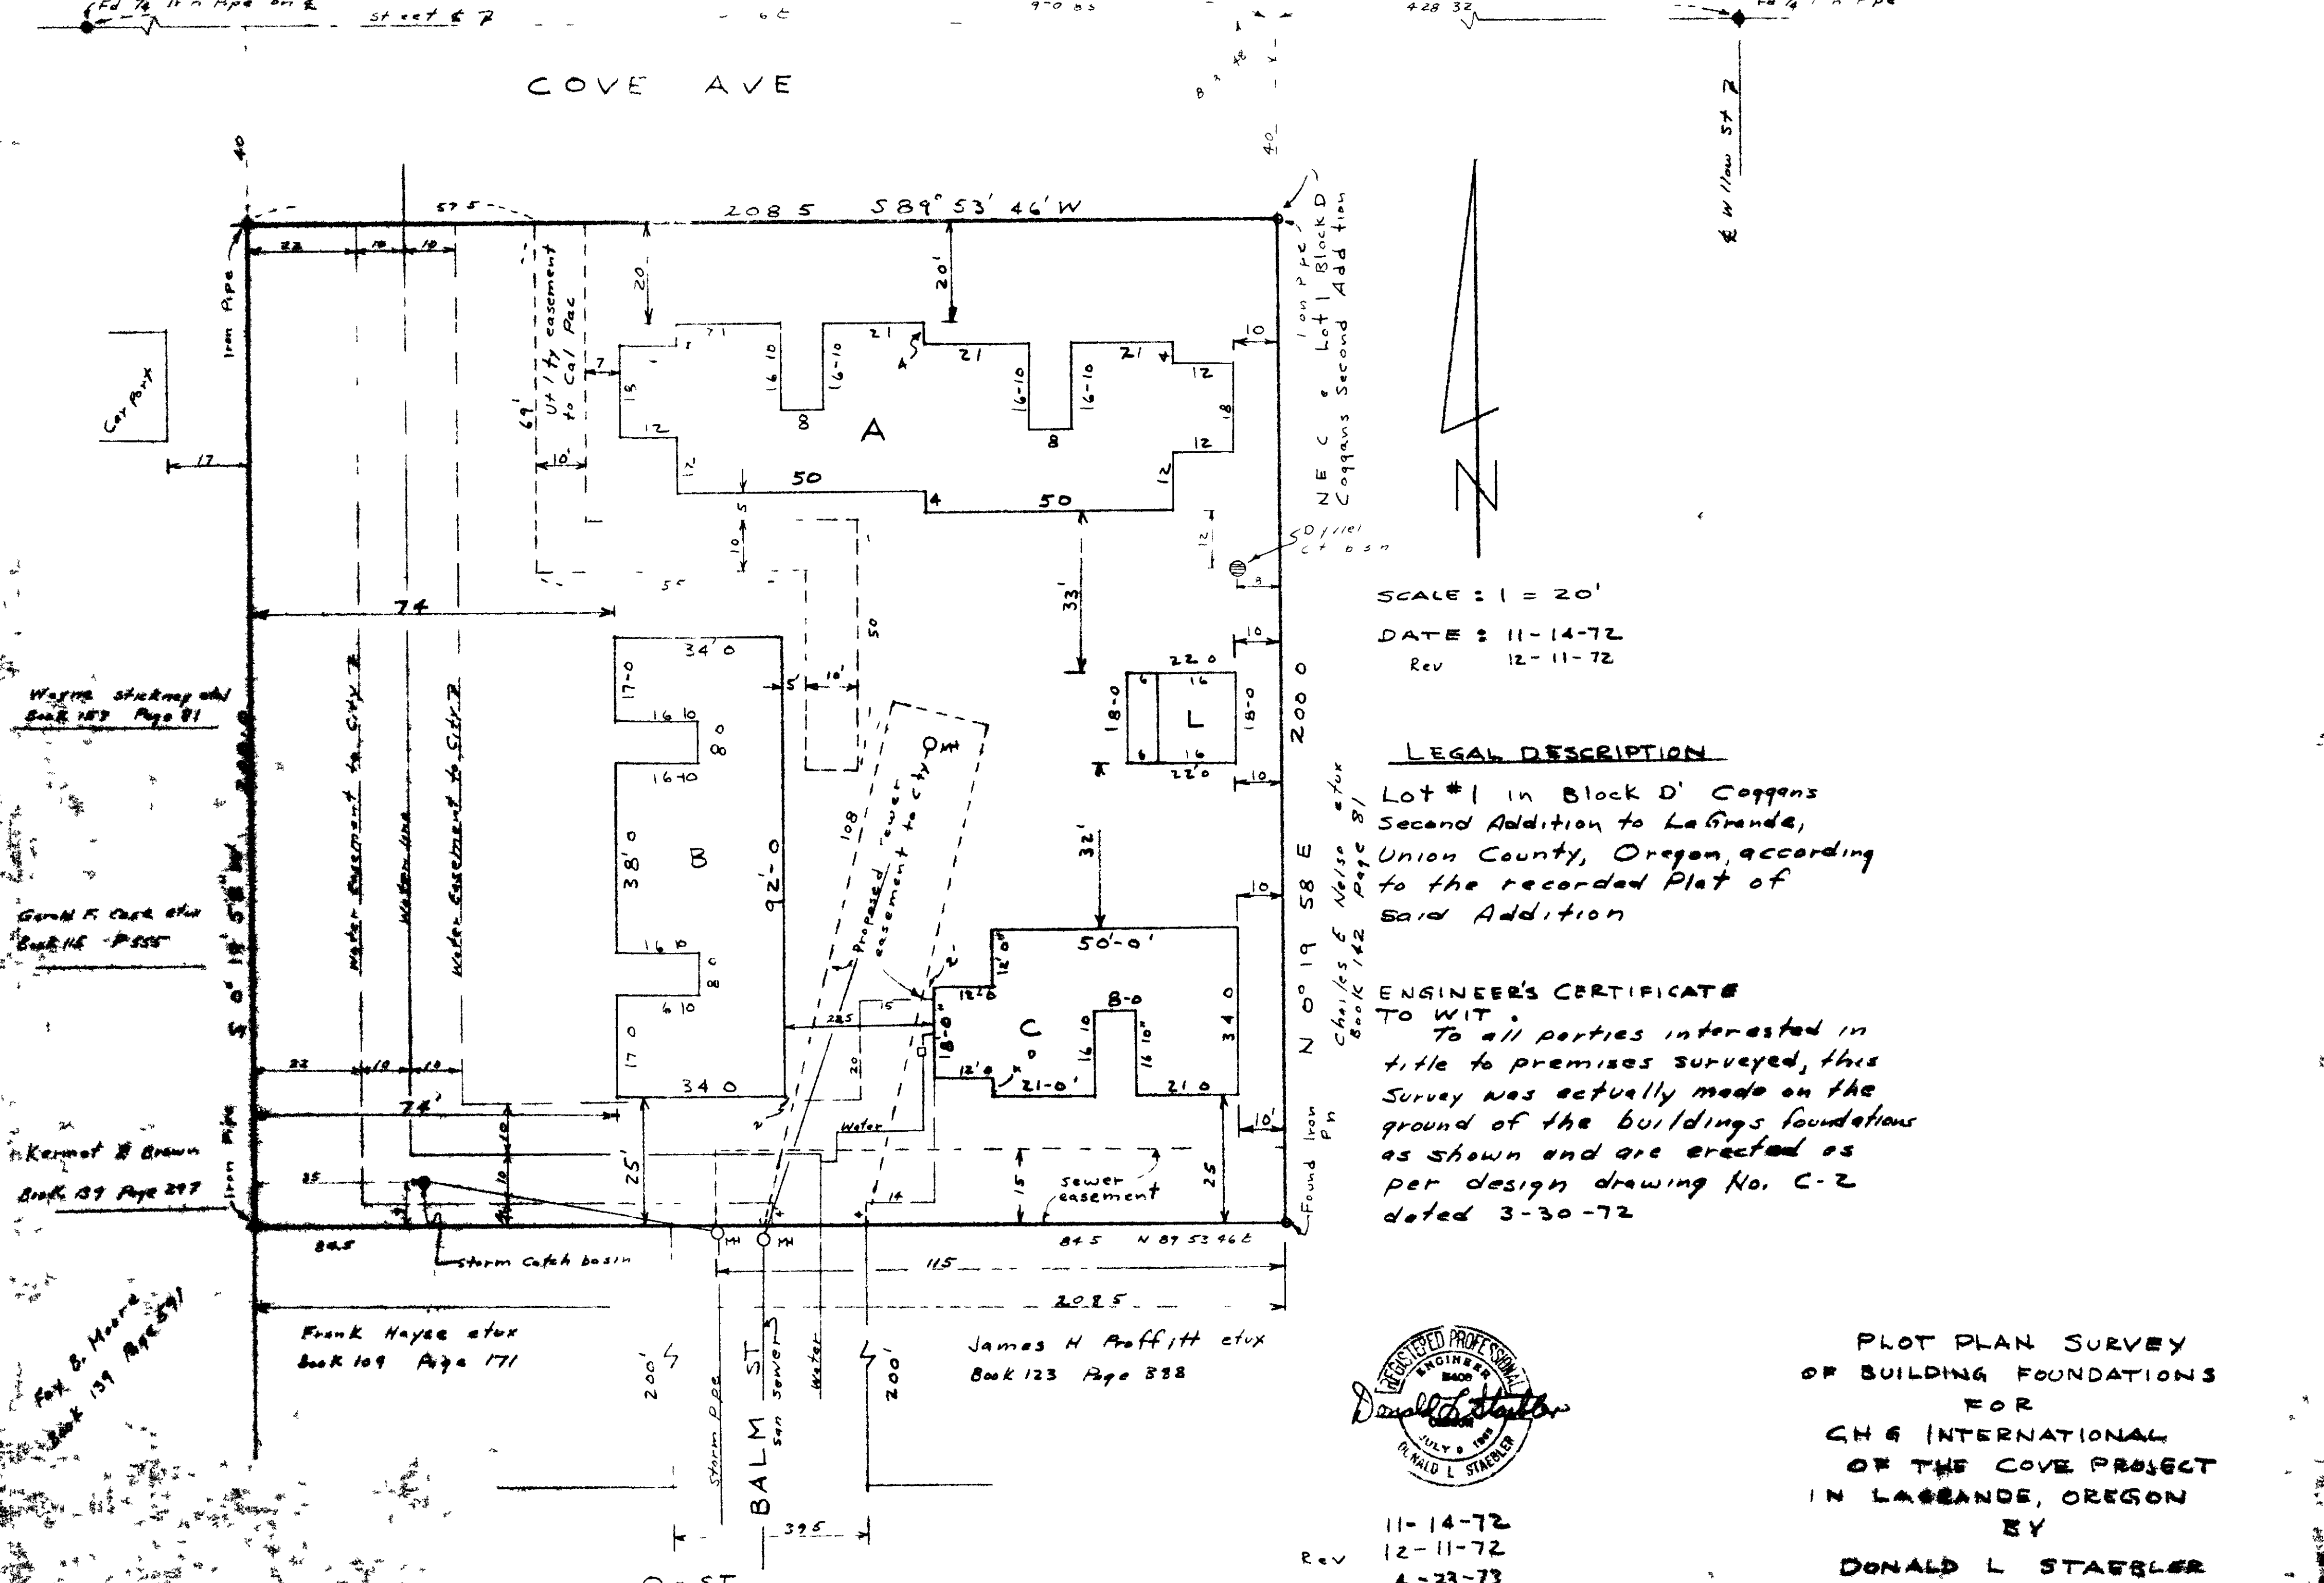

Wayne Stickney et al
Book 187 Page 81

Garth F. Clark et al
Book 116 Page 355

Kernot B. Brown
Book 137 Page 297

Fox & Moore
Book 139 Page 591

Frank Hayes et al
Book 109 Page 171

James H. Proffitt et al
Book 123 Page 388

1 on P.P.C.
N.E.C. & Lot 1 Block D
Coggans Second Addition

50' 11/2" c.t. b.s.n.


SCALE: 1" = 20'
DATE: 11-14-72
Rev 12-11-72

LEGAL DESCRIPTION

Lot #1 in Block D' Coggans
Second Addition to La Grande,
Union County, Oregon, according
to the recorded Plat of
said Addition

ENGINEER'S CERTIFICATE

TO WIT:
To all parties interested in
title to premises surveyed, this
Survey was actually made on the
ground of the buildings foundations
as shown and are erected as
per design drawing No. C-2
dated 3-30-72

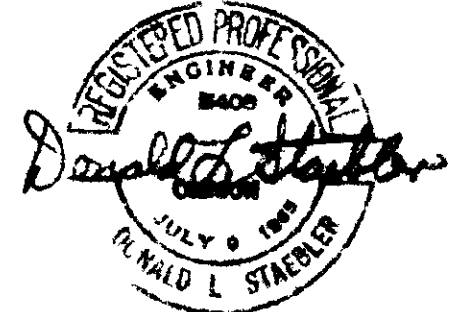

REV
11-14-72
12-11-72
4-23-73

PLOT PLAN SURVEY
OF BUILDING FOUNDATIONS
FOR
CHS INTERNATIONAL
OF THE COVE PROJECT
IN LA GRANDE, OREGON
BY

DONALD L. STAEBLER
CONSULTING ENGINEER
PO BOX 91
PENDLETON, OREGON 97801