



### BASIS OF BEARING

SOLAR OBSERVATIONS

### REFERENCE MATERIAL

#### SURVEY NUMBERS



64 - 75  
41 - 76  
101 - 77

#### DEED DESCRIPTIONS

BOOK	PAGE
132	- 050
140	- 185
112	- 275
142	- 428
142	- 469
100	- 415
143	- 491
142	- 343
133	- 505
143	- 356
107	- 142

### LEGEND

- FOUND MONUMENT OF RECORD
- SET 5/8" x 30" IRON PIN WITH PLASTIC CAP MARKED B-G-A SURVEY MARKER
- ( ) RECORD BEARING AND DISTANCE IF OTHER THAN TRUE
- - - EXISTING FENCE
- CENTERLINE STREET

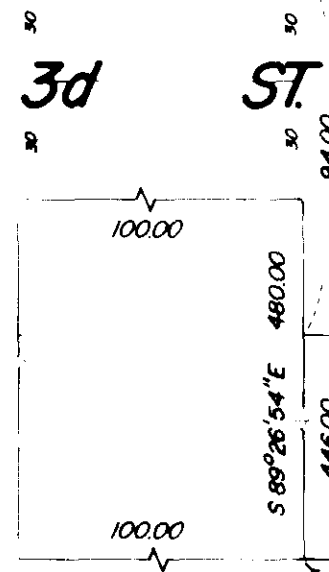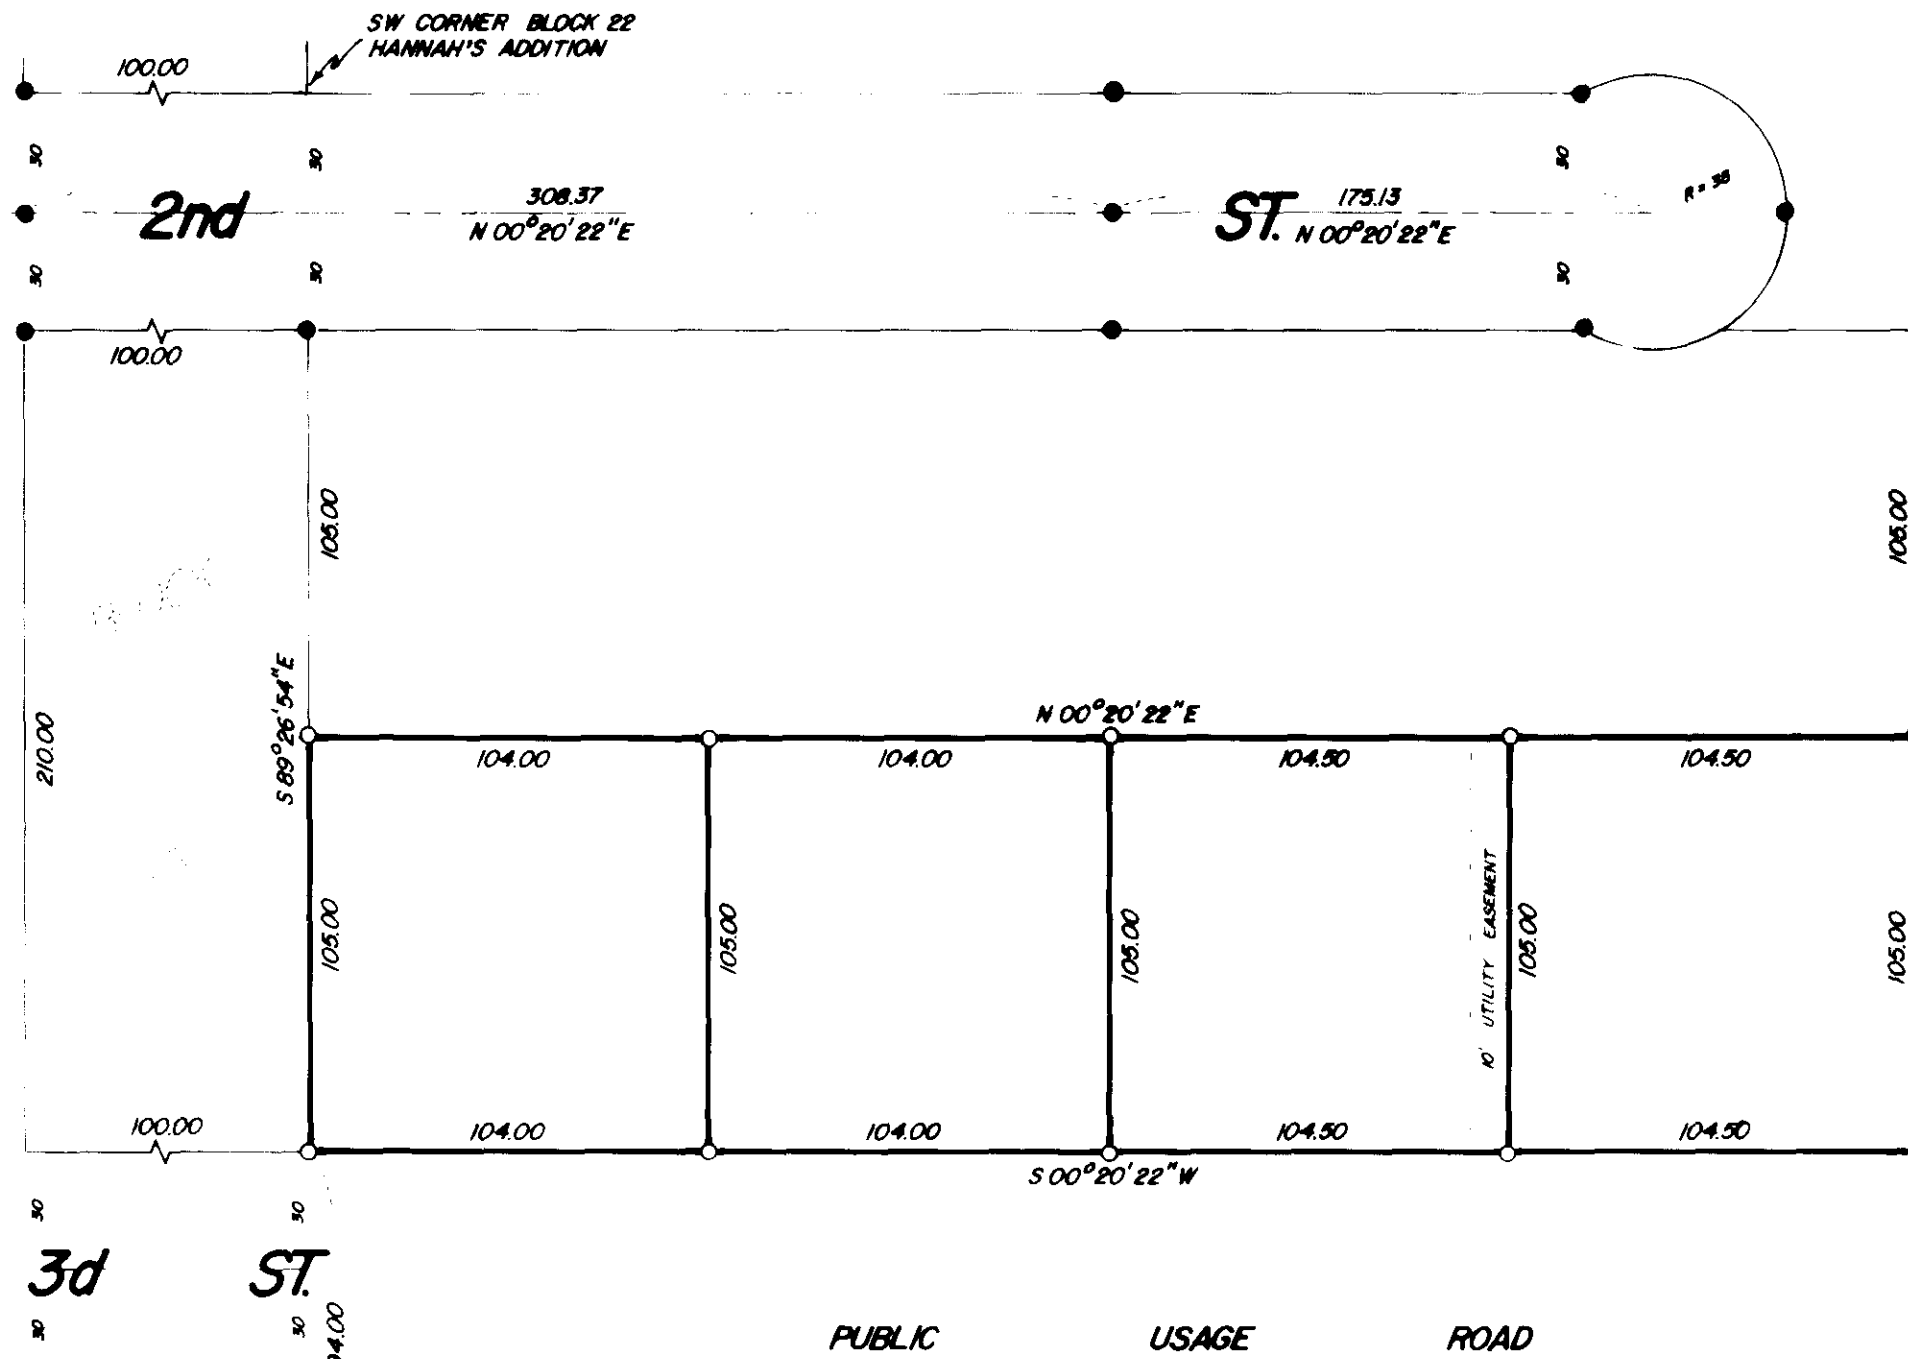

REGISTERED  
PROFESSIONAL  
LAND SURVEYOR

OREGON  
JULY 10, 1964  
DUANE I. GRIFFITH  
644

<b>BAGETT, GRIFFITH &amp; ASSOCIATES</b>	
La Grande, Oregon	
Map of Survey	
PARCELS IN THE NW 1/4 OF THE SW 1/4 OF SECTION 19	
T4S, R40E W.M.	
UNION	
UNION COUNTY, OREGON	
SURVEYED FOR	CHUCK MELTON
SURVEYED BY	dig 3 - 78
Scale 1" = 50'	Drawn by dig ssz 3 - 78

JEFFERSON STREET

JEFFERSON

2nd

3d

ST.

ST. N 00° 20' 22" E

PUBLIC USAGE ROAD

SW CORNER BLOCK 22 HANNAH'S ADDITION

SW CORNER BLOCK 25 HANNAH'S ADDITION