


MAP OF FIELD SURVEY  
LOCATED IN S.E. 1/4, SECTION 33, TWP. 2 S., R. 38 E., W.M. UNION CO., OREGON.

FOR: MITCHELL ASLA  
RT. 1, LA GRANDE, ORE. 97850

SCALE: 1" = 50'  
DATE: APRIL, 1978  
BASIS OF BEARINGS: SURVEYS: 56-73  
APA - 2573  
E.O.L.S. - 255

- SET 1" IRON PIPE.
- FOUND MONUMENT OF RECORD

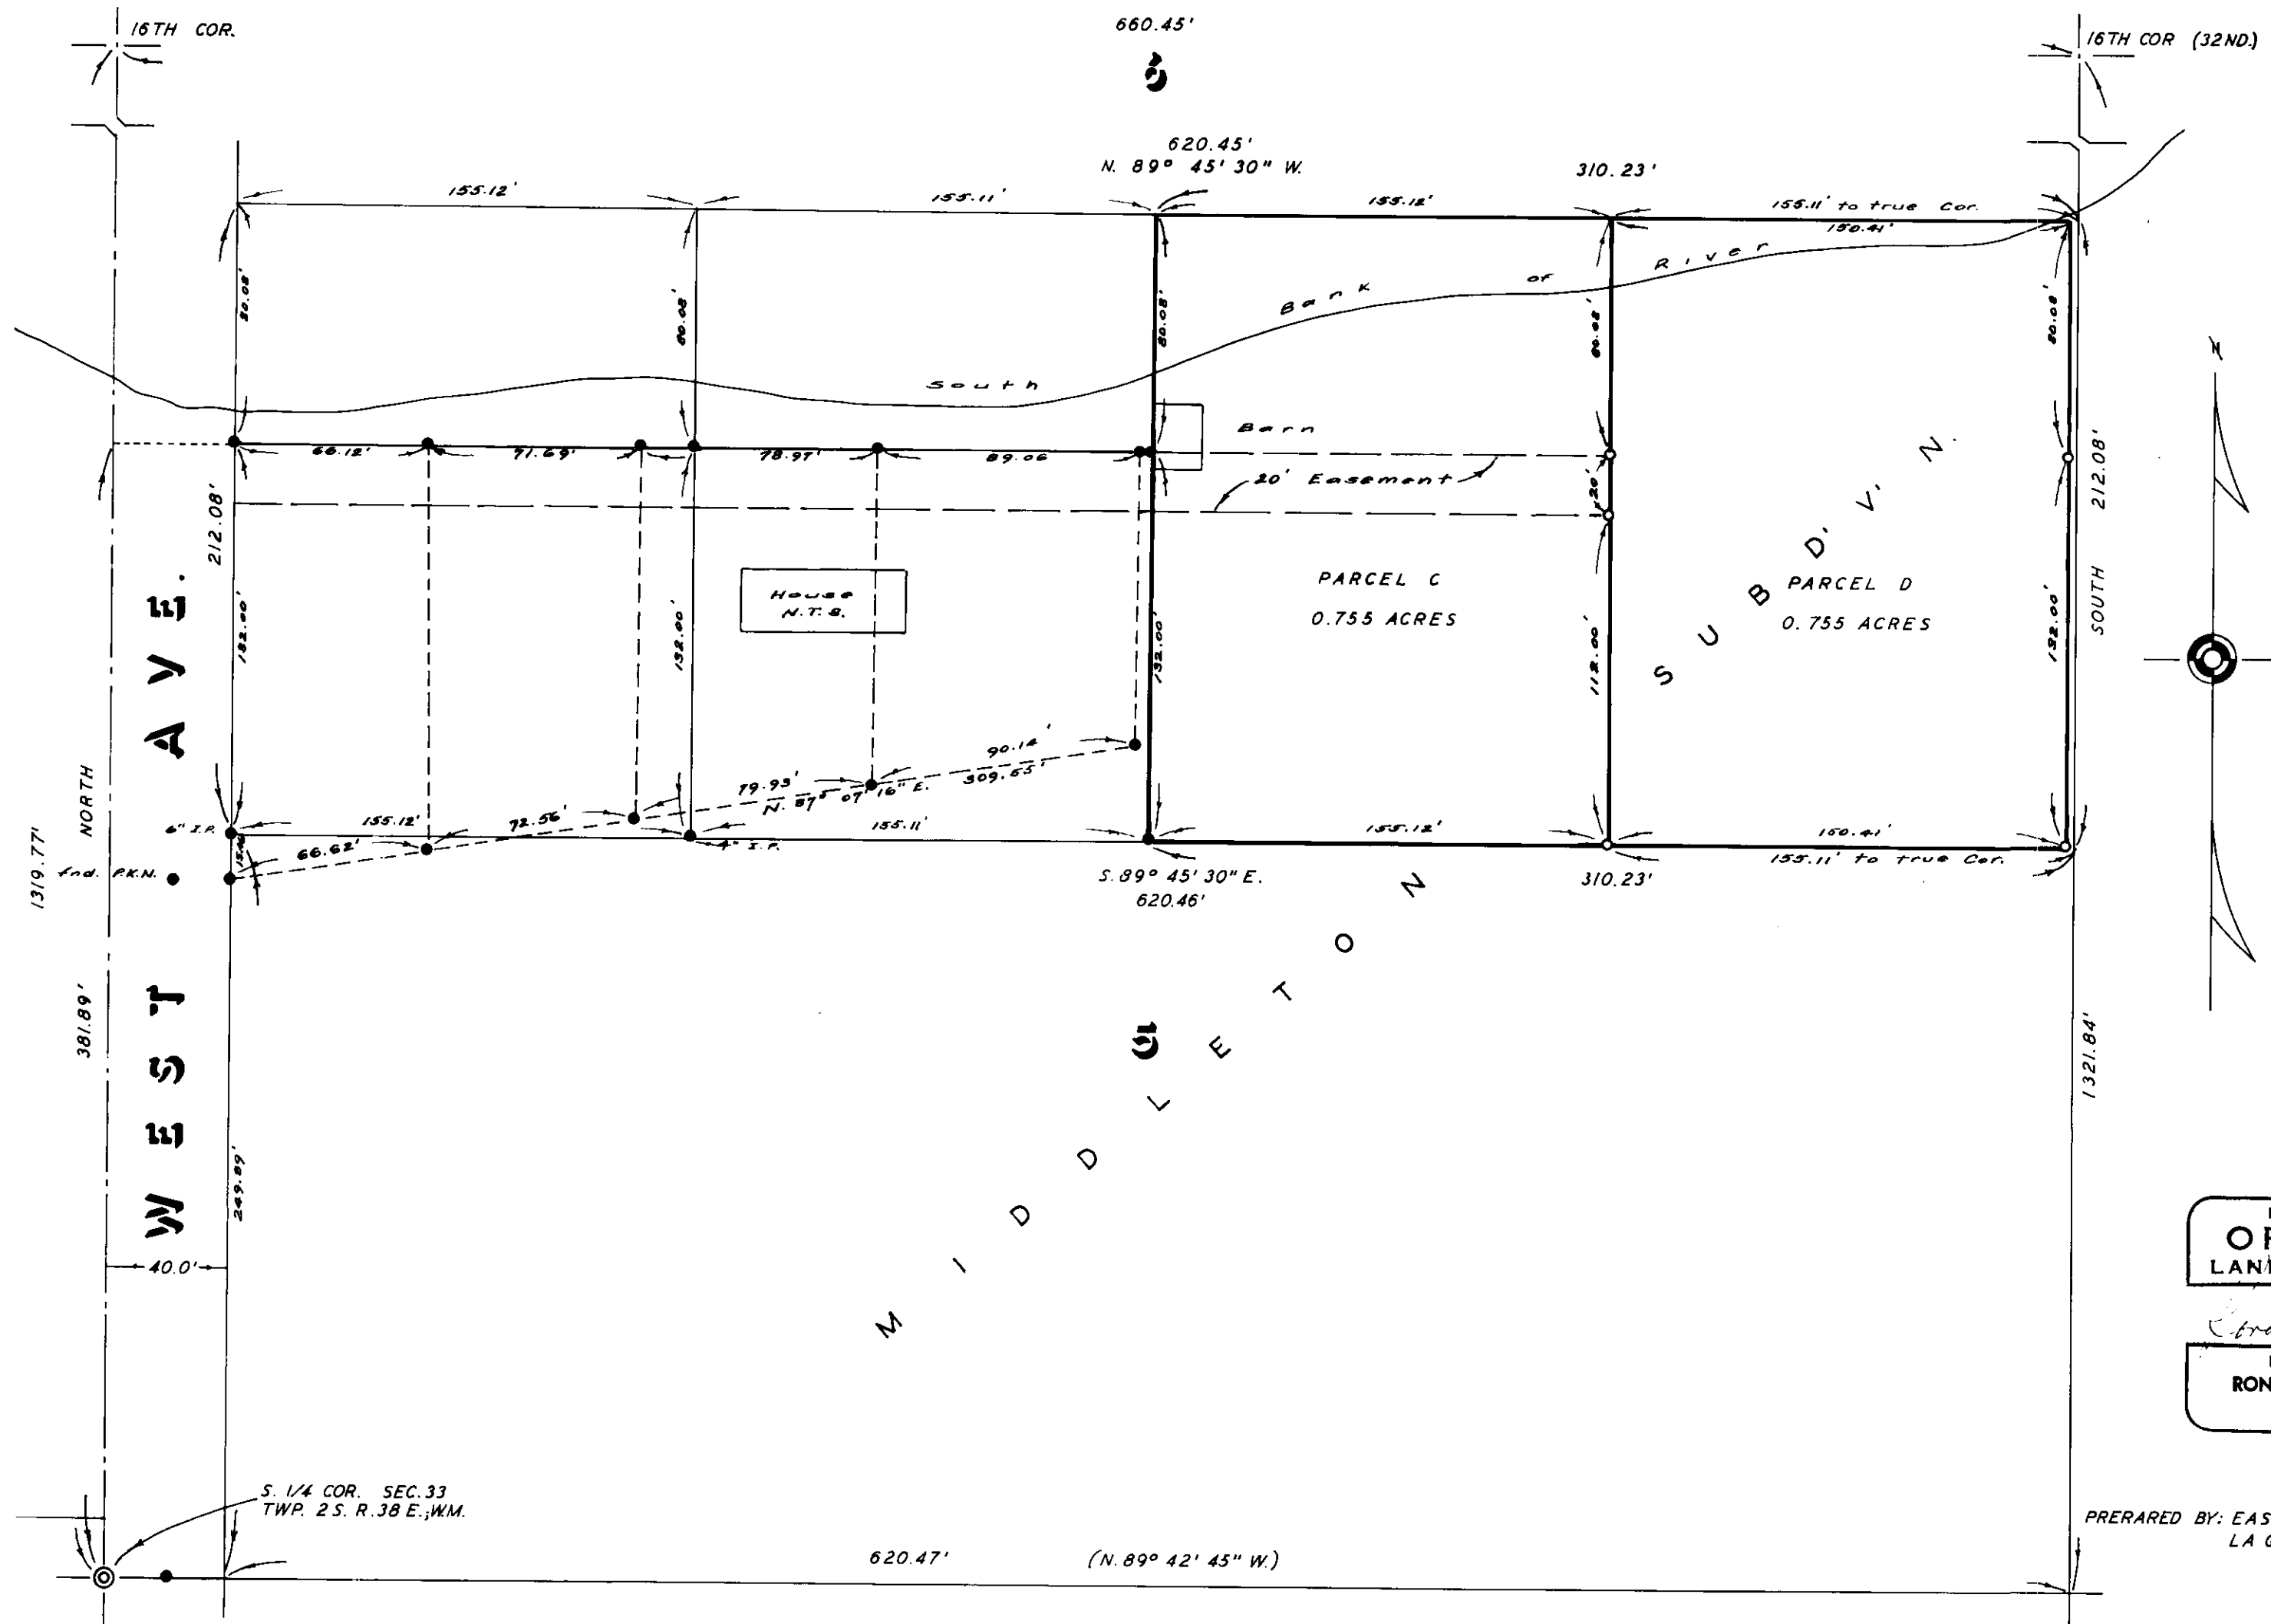

REGISTERED  
OREGON  
LAND SURVEYOR

*Ronald J. Brazeau*  
MAY 4, 1956  
RONALD J. BRAZEAU  
374

PREPARED BY: EASTERN OREGON LAND SURVEYS  
LA GRANDE ELGIN

41-78