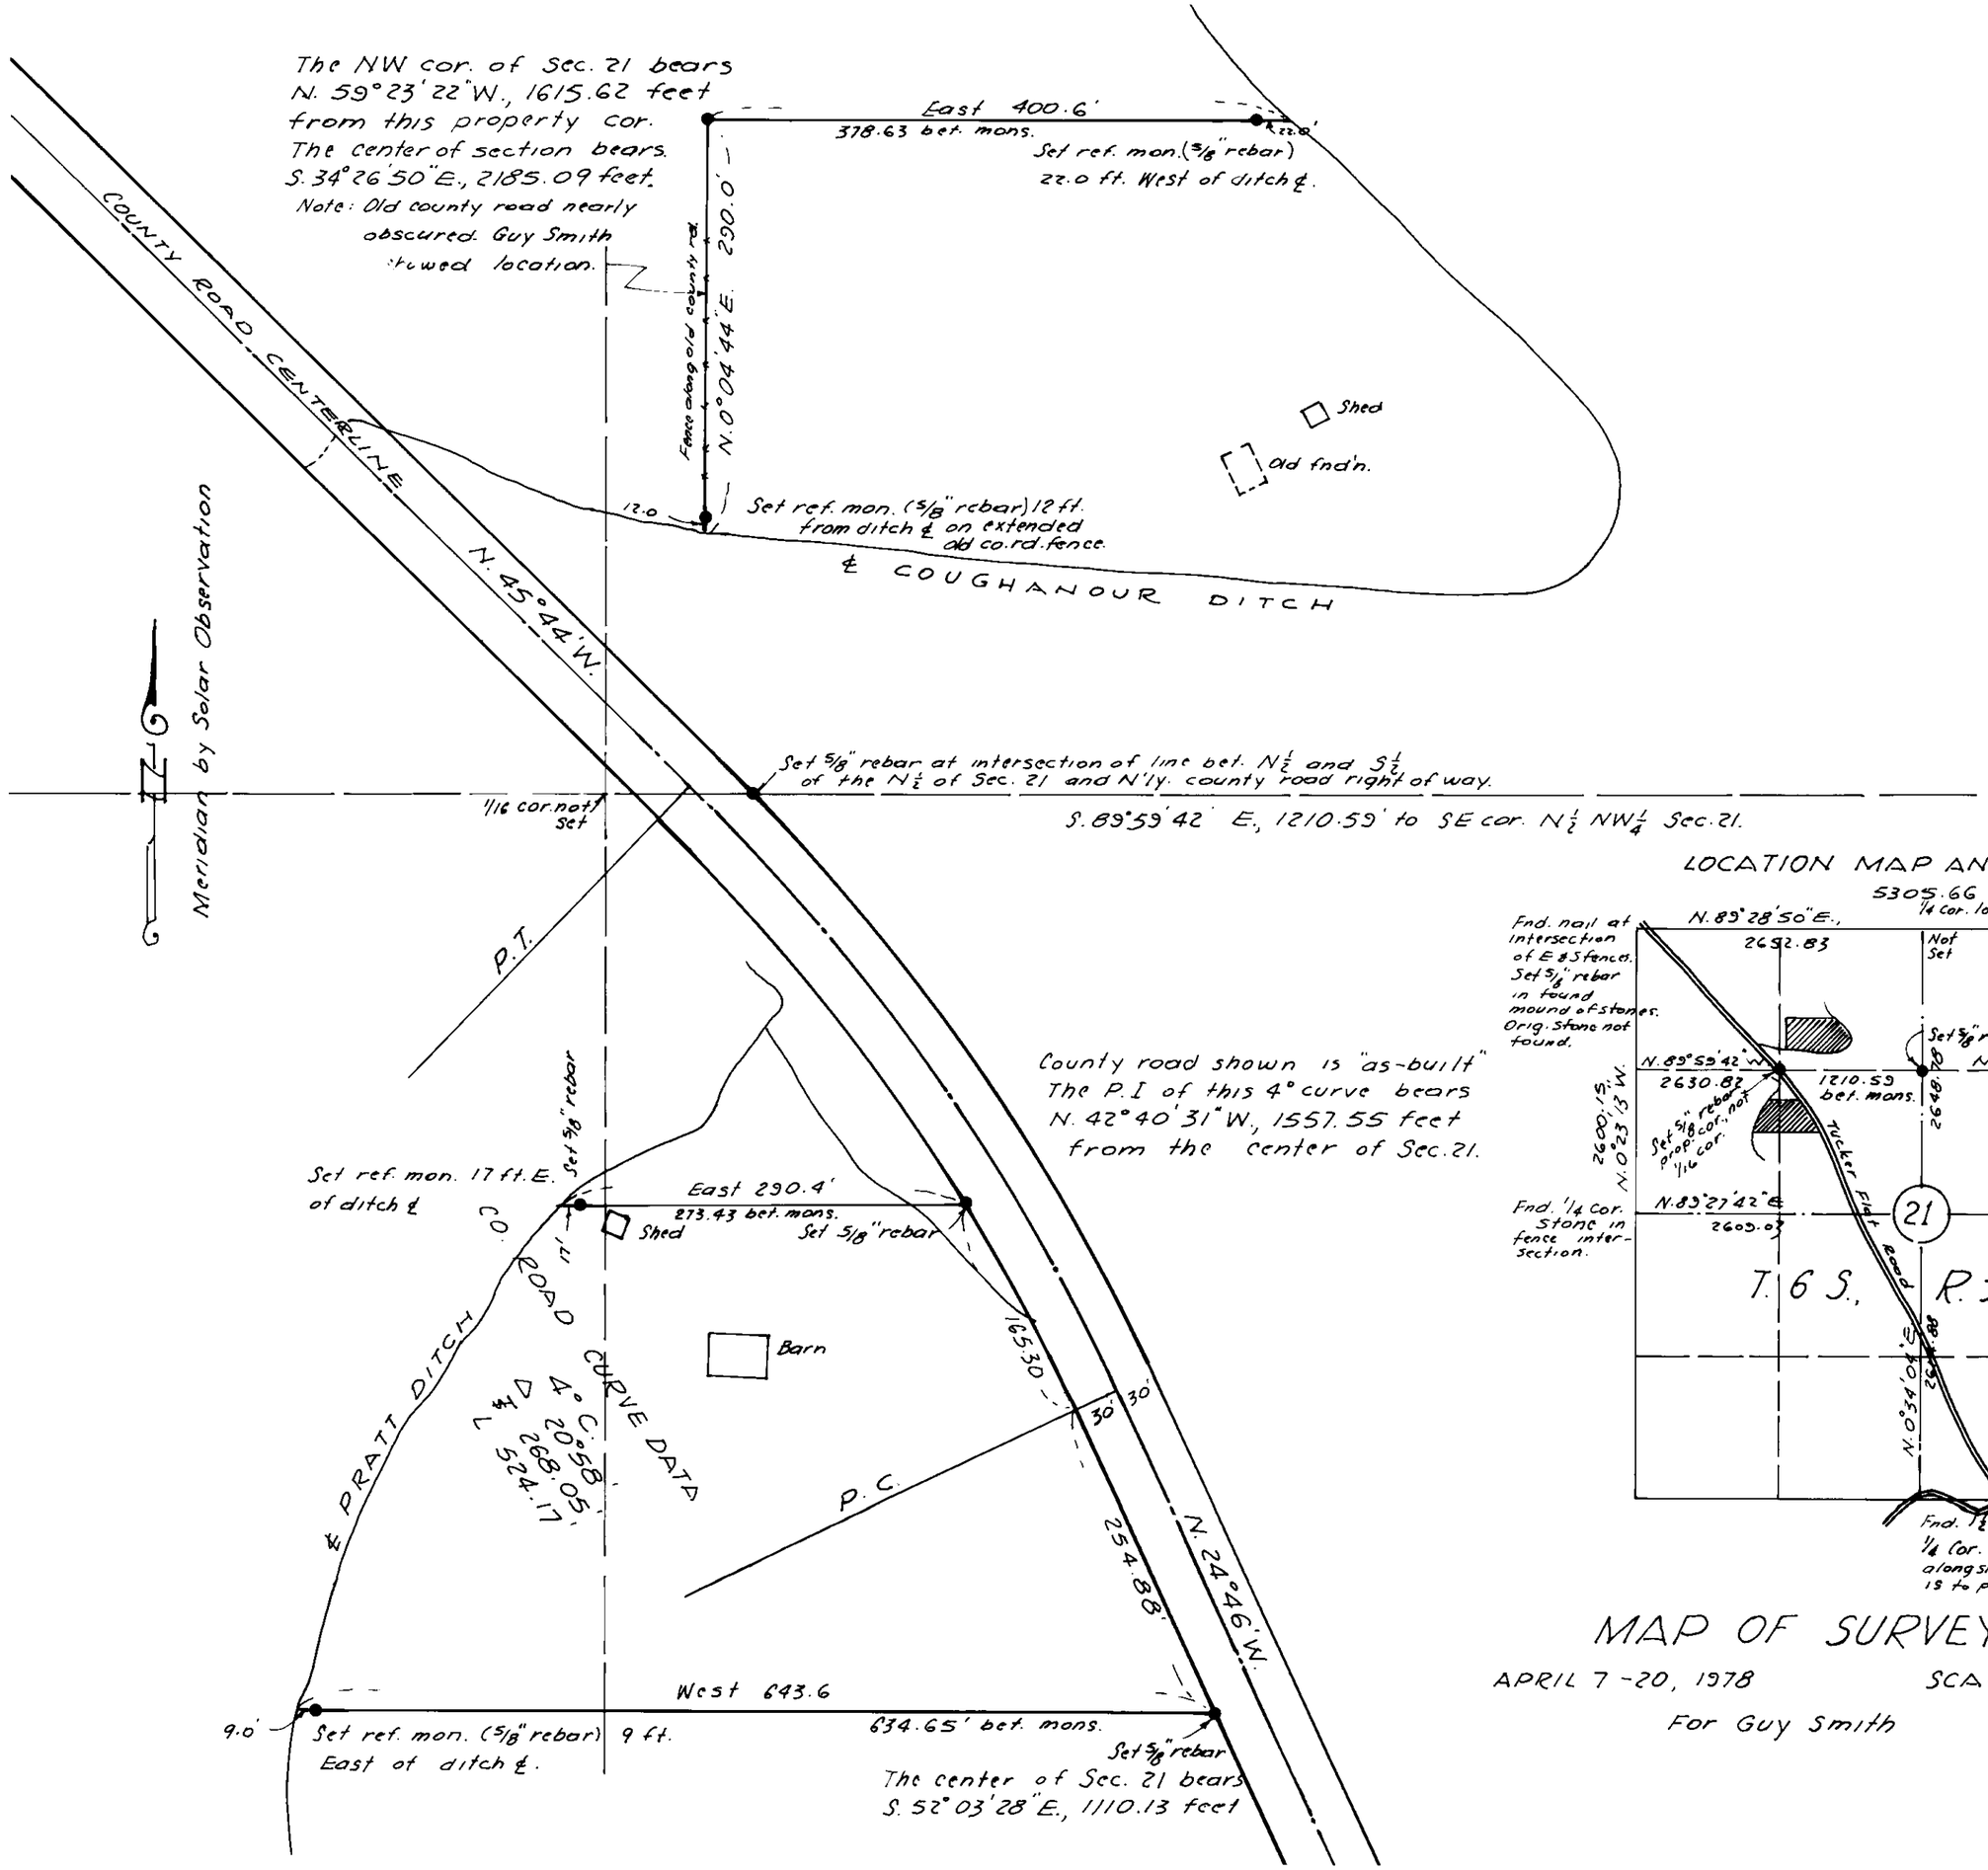

LOCATION MAP AND SEC. SUBDIV.

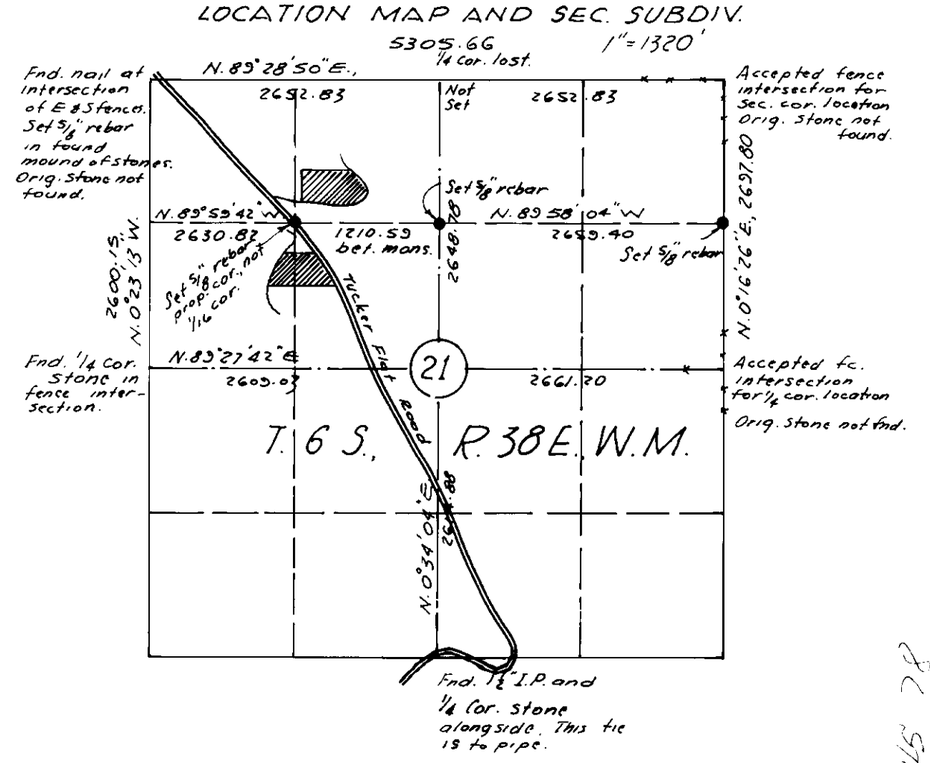

MAP OF SURVEY

APRIL 7-20, 1978 SCALE 1"=100

For Guy Smith

REGISTERED
PROFESSIONAL
LAND SURVEYOR

James D. Hanley

OREGON
SEPTEMBER
JAMES D. HANLEY
1206