


CORRECTED MAP OF SURVEY No. 41-76

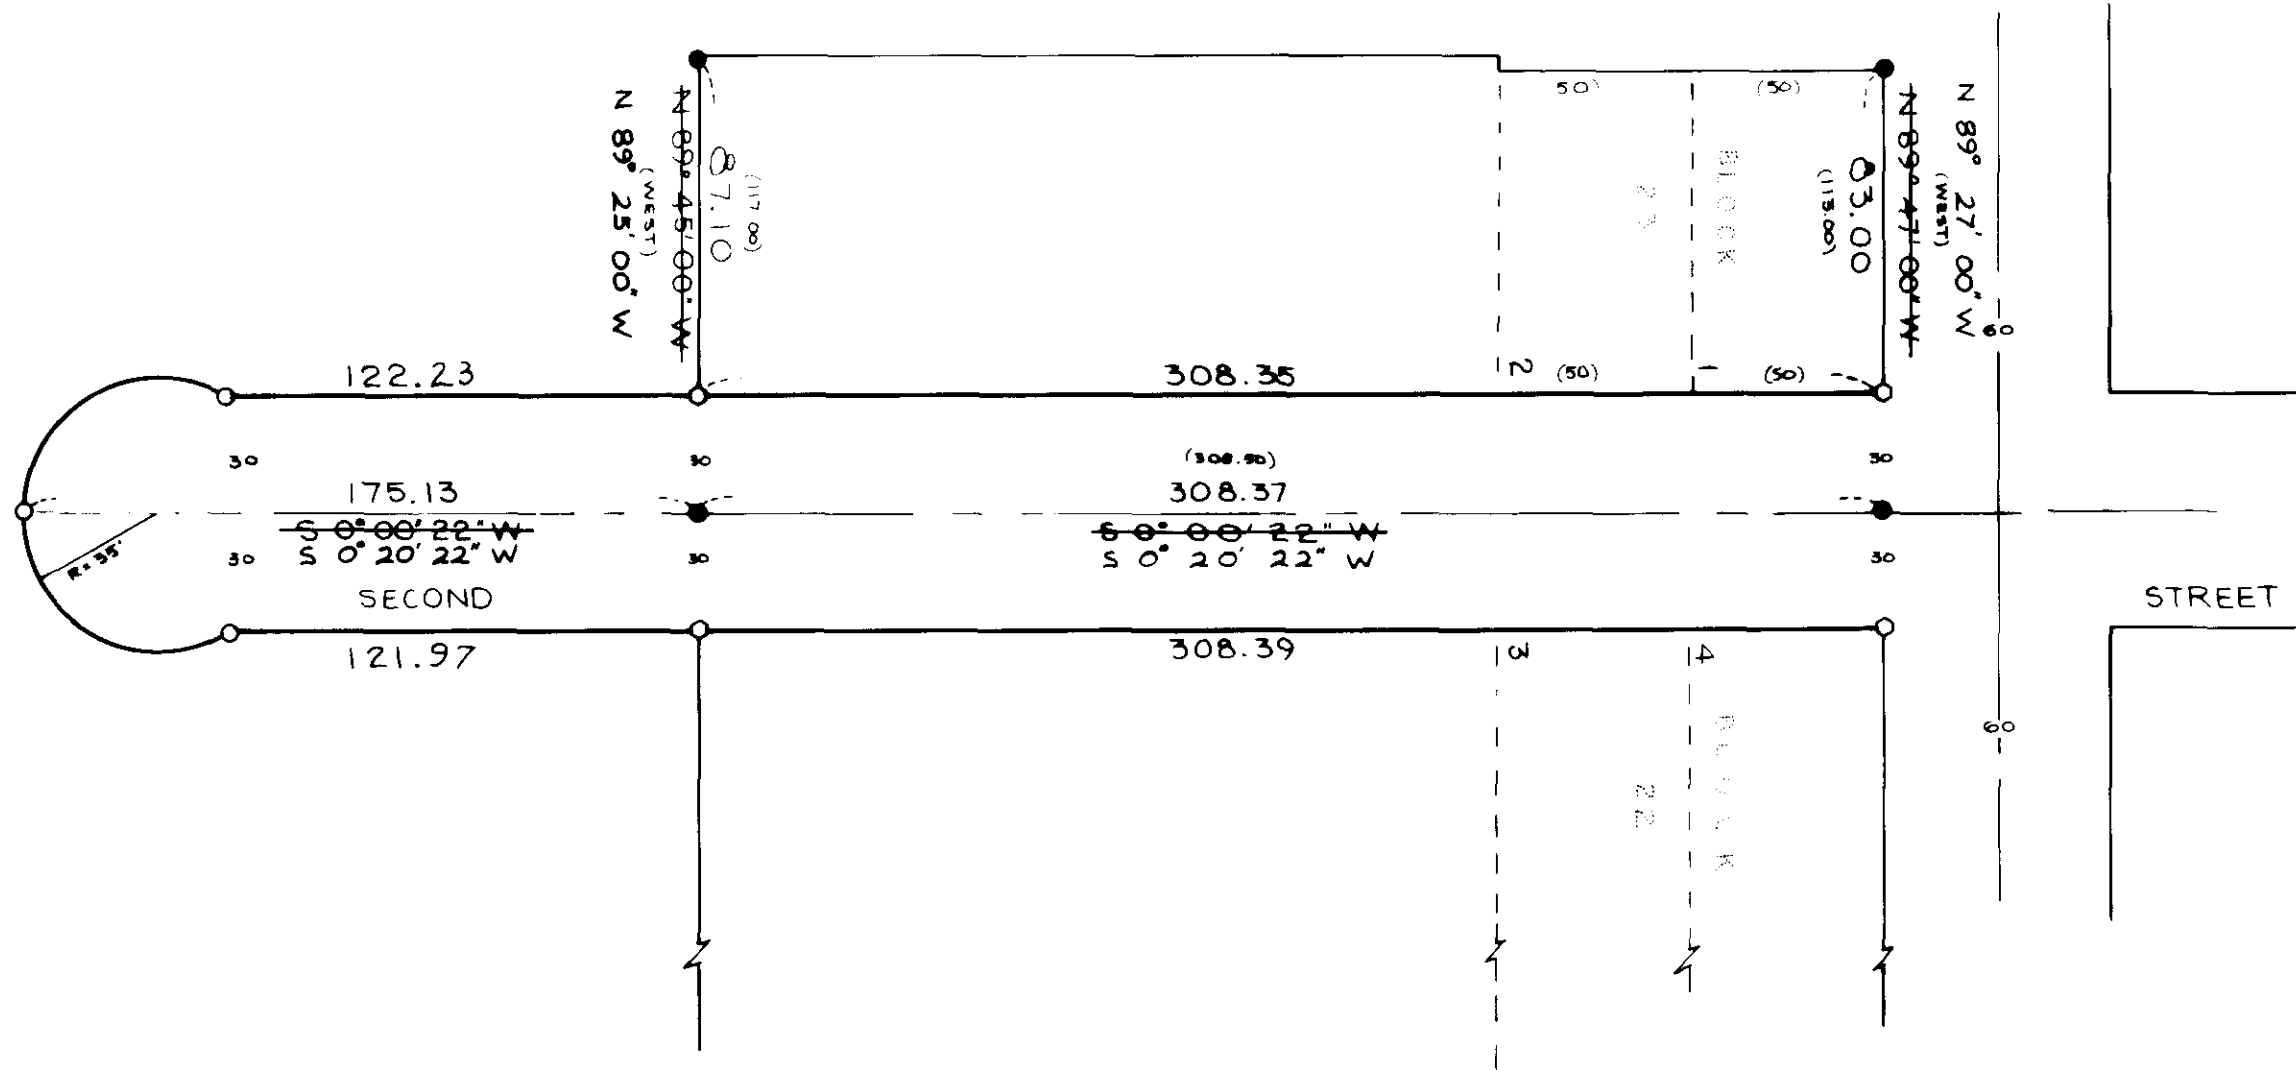

BASIS OF BEARING
SOLAR OBSERVATION



REFERENCE MATERIAL

MAP OF SURVEY FOR
REV. CLYDE DILLEY
DATED OCTOBER 23, 1975

LEGEND

- FOUND MONUMENT OF RECORD
 - SET 5/8" x 30" IRON PIN WITH PLASTIC CAP MARKED B.G.A SURVEY MARKER.
 - SET 1/2" x 24" IRON PIN
 - () RECORD BEARING AND DISTANCE
- ~~S 0° 20' 22" W~~ CORRECTED BEARING

REGISTERED
PROFESSIONAL
LAND SURVEYOR
Diane J. Griffith
OREGON
JULY 16, 1968
DUANE J. GRIFFITH
644

BAGETT, GRIFFITH & ASSOCIATES		
La Grande, Oregon		
Map of Survey		
SURVEYED FOR	RICHARD SOCHA	
SURVEYED BY	D. I. G.	
Scale: 1" = 50'	Drawn by: t.d.g.	APR. 1978

51-78