

CORRECTION MAP OF SURVEY NO. 40-77

REFERENCE MATERIAL

SURVEY NUMBERS

64-75
41-76
19-77

LEGEND

- FOUND MONUMENT OF RECORD
- SET 5/8" x 30" IRON PIN WITH PLASTIC CAP MK'D B.G.A. SURVEY MARKER
- * * * * * EXISTING FENCE
- () RECORD DISTANCE
- N 00° 03' 10" E -99.4 CORRECTED BEARING AND DISTANCE

REGISTERED
PROFESSIONAL
LAND SURVEYOR

Handwritten Signature

OREGON
JULY 10, 1964
DUANE I. GRIFFITH
644

BAGETT, GRIFFITH & ASSOCIATES

La Grande, Oregon

Map of Survey

LOTS 1,2,3,4,5,6,7,8 BLOCK 16

HANNAH'S TO ADDITION

UNION

UNION COUNTY, OREGON


SURVEYED FOR RON GABRIEL

SURVEYED BY D.I.G.

Scale: 1" =

Drawn by: S.S.Z.

APR 1978

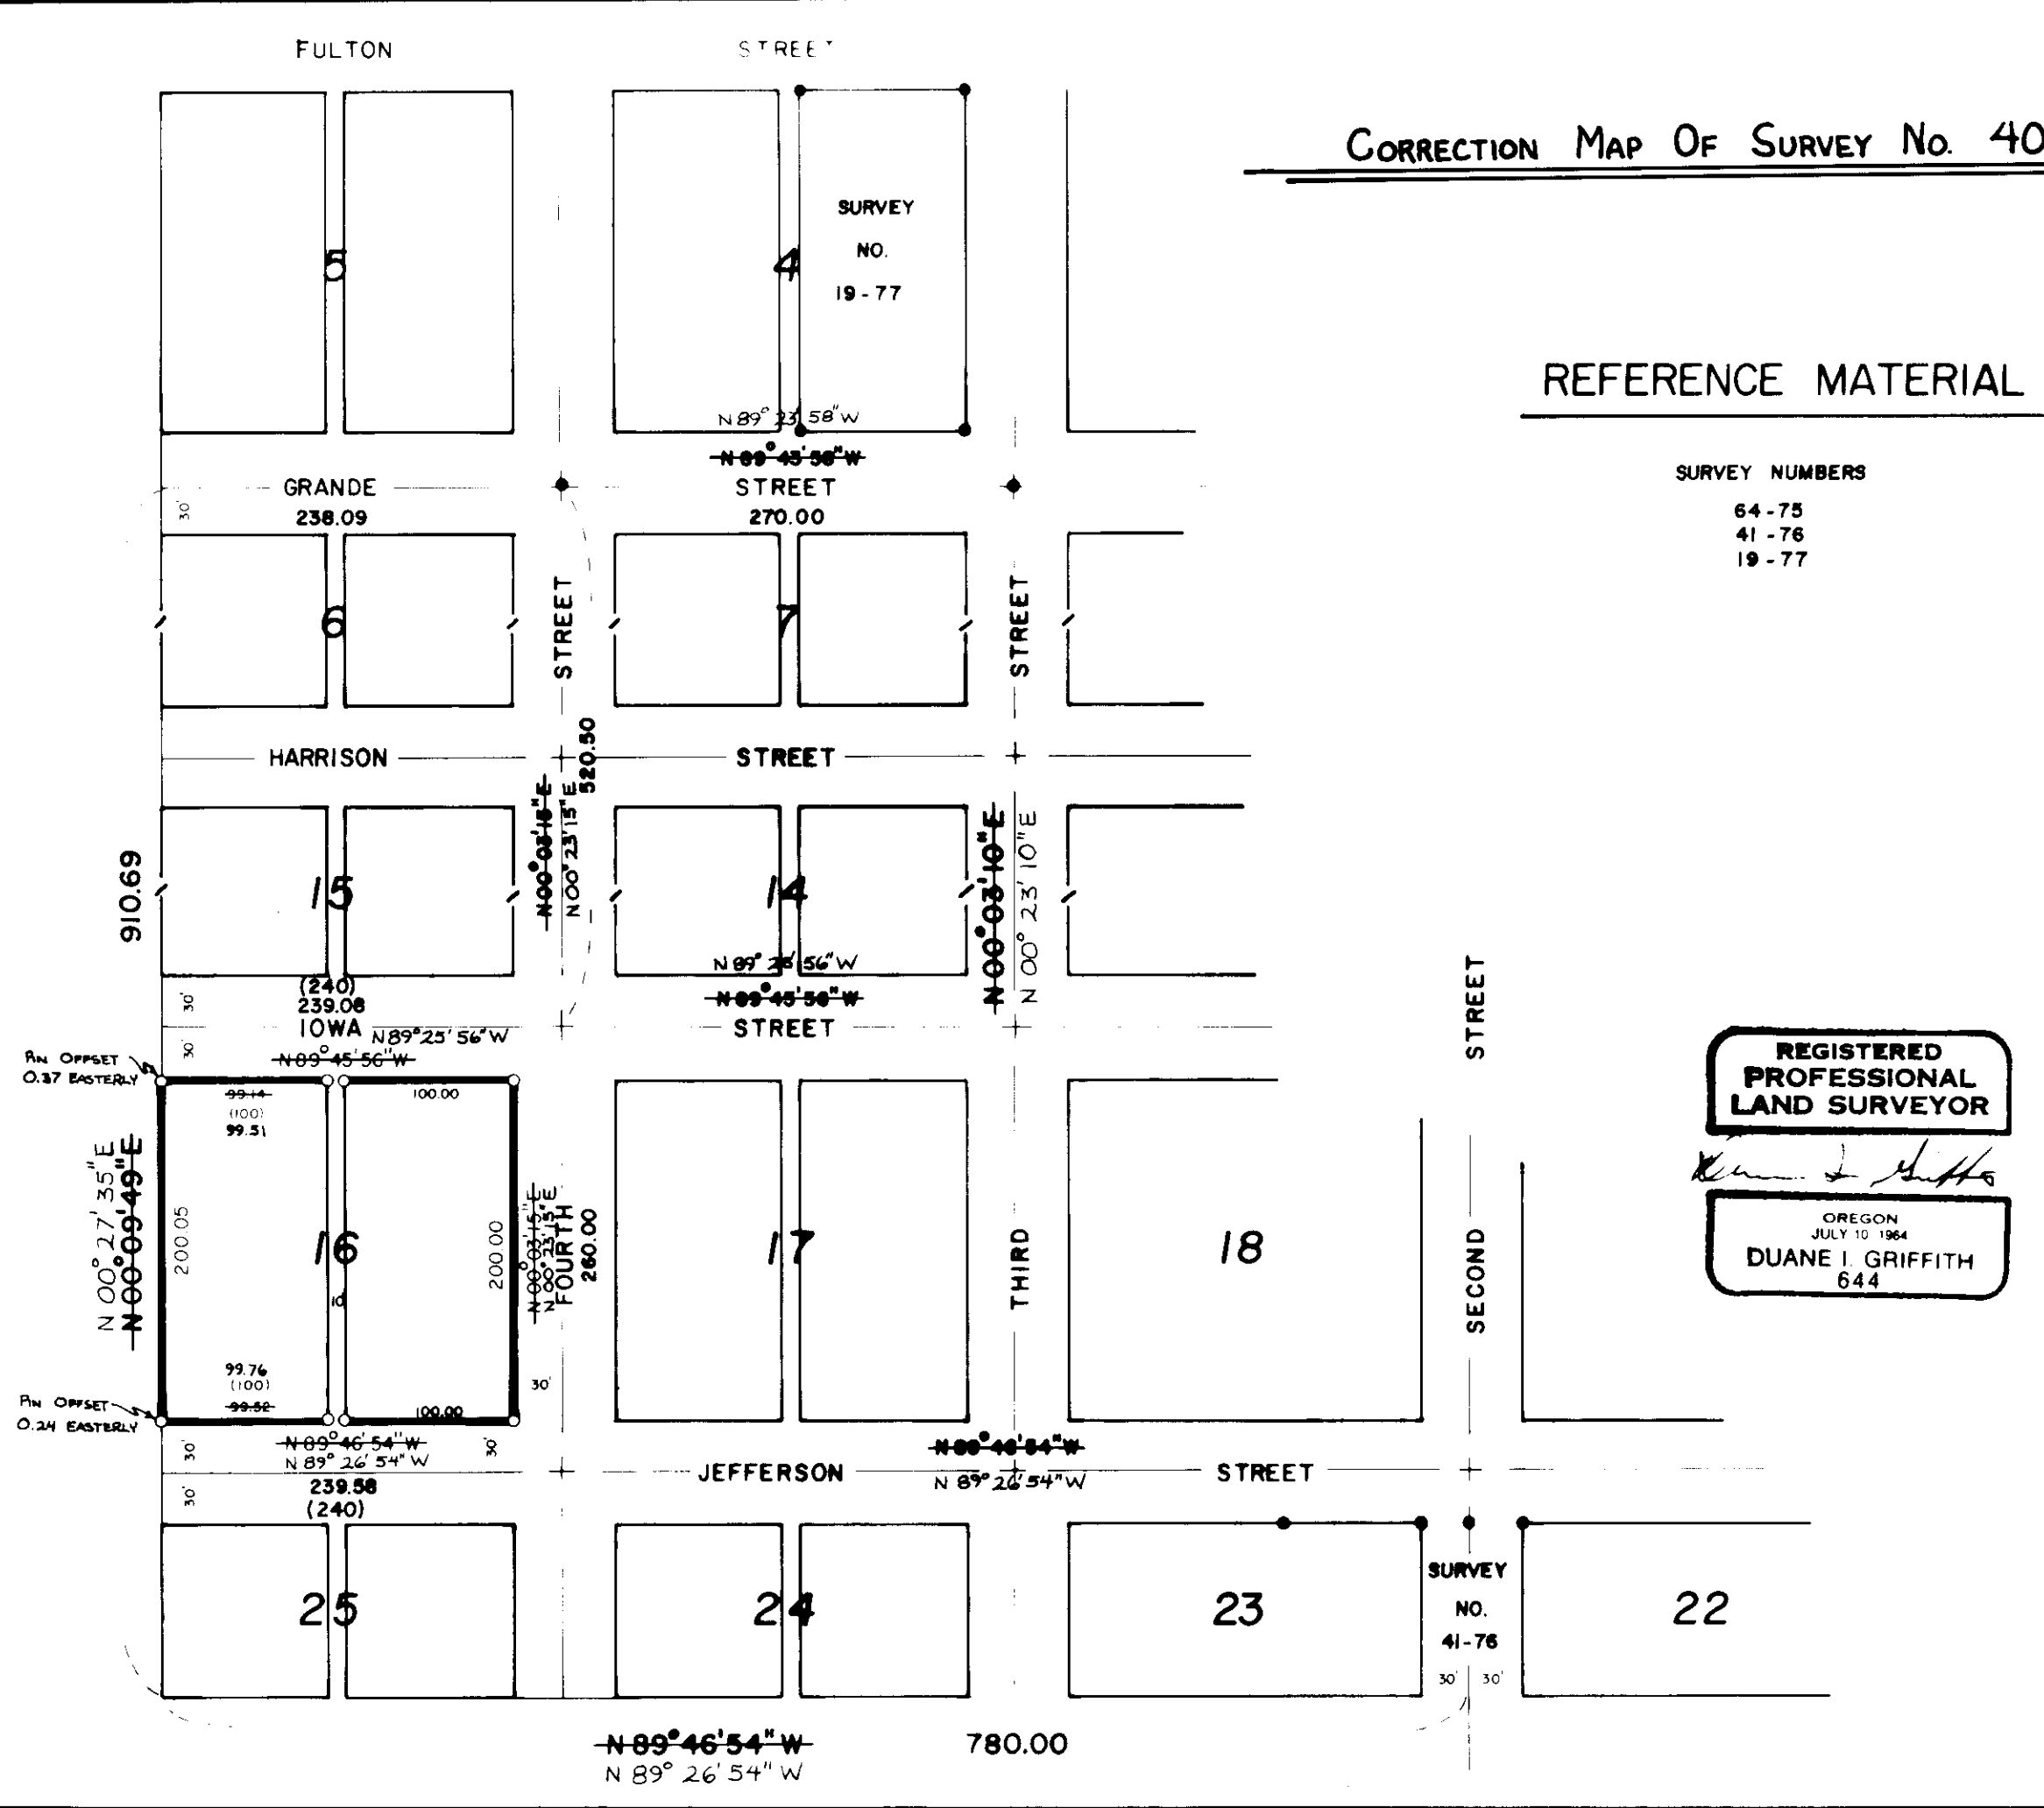

52-28