

**BASIS OF BEARING**

FORWARD BEARING AS PUBLISHED BY THE U.S.G. & G.S.  
FROM  $\Delta$  COLLEGE TO  $\Delta$  VALLEY

**LEGEND**


- FOUND MONUMENT OF RECORD
- SET 5/8" x 30" IRON PIN WITH PLASTIC CAP MARKED B G A SURVEY MARKER
- ( ) RECORD BEARING AND DISTANCE
- EXISTING FENCE

**REFERENCE MATERIAL**

SURVEY NUMBERS:  
44 - 76  
58 - 77  
37 - 78

REGISTERED  
PROFESSIONAL  
LAND SURVEYOR

*Duane I. Griffith*  
OREGON  
JULY 10, 1964  
DUANE I. GRIFFITH  
644

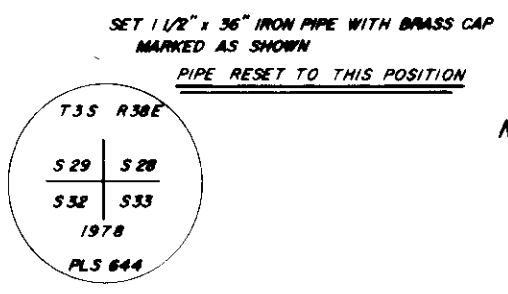

NOTE:  
MT. GLENN ROAD LOCATION BASED ON EXISTING ROAD CENTERLINE.  
S.W. CORNER OF SECTION 28 IS SET, ON THE BASIS OF PROPORTIONATE DISTANCE EAST & WEST, AND ON LINE POINTED OUT BY D.W. PHILLIPS WHO SAW A CORNER MONUMENT 50 ± YEARS AGO.

**CORRECTION SURVEY**  
of  
SURVEY NO. 36-78

<b>BAGETT, GRIFFITH &amp; ASSOCIATES</b> La Grande, Oregon		
Map of Survey PARCEL IN THE E 1/2 OF THE SW 1/4 OF SECTION 28 T2S, R38E W1M		
UNION COUNTY, OREGON		
SURVEYED FOR	RUSS LESTER	
SURVEYED BY	dig	5-78
Scale: 1" = 400'	Drawn by: S S Z	5-78