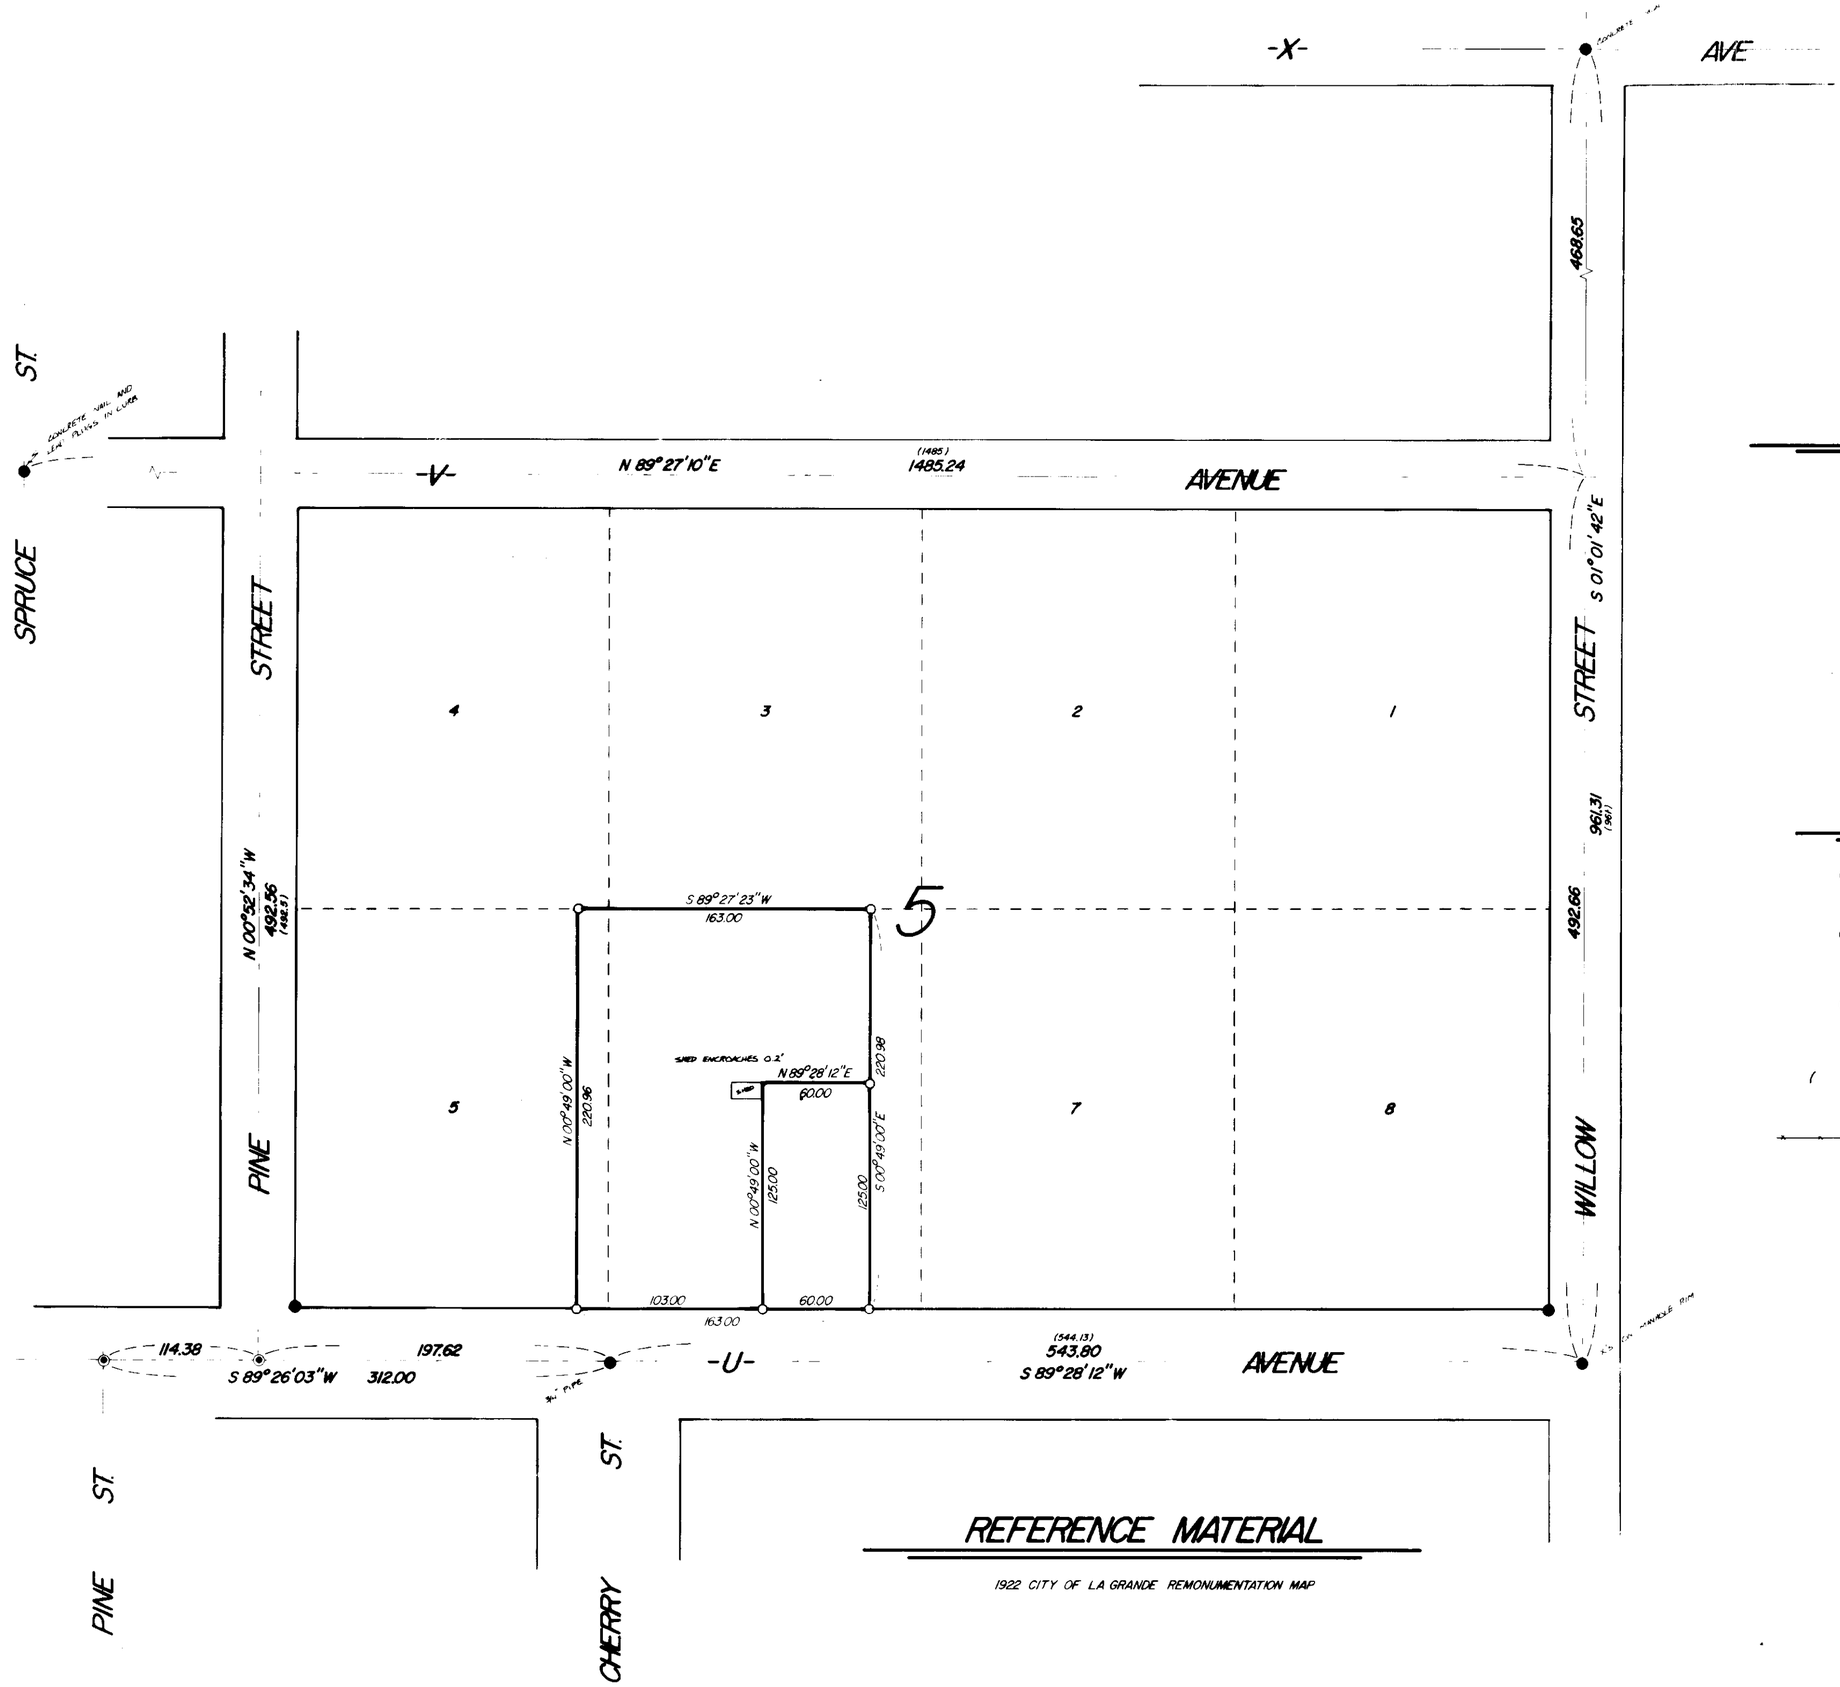

BASIS OF BEARING

FORWARD BEARING AS PUBLISHED BY THE U.S.C. AND G.S. FROM △ COLLEGE TO △ VALLEY.

LEGEND

- ● FOUND MONUMENT OF RECORD
- ◉ SET P-K NAIL FROM REFERENCE POINTS
- ○ SET 5/8" x 30" IRON PIN WITH PLASTIC CAP MARKED B·G·A SURVEY MARKER
- ( ) RECORD DISTANCE · IF OTHER THAN TRUE
- EXISTING FENCE

REGISTERED PROFESSIONAL LAND SURVEYOR
Gregory T. Blackman
OREGON
JULY 13, 1978
GREGORY T. BLACKMAN
991

REFERENCE MATERIAL

1922 CITY OF LA GRANDE REMONUMENTATION MAP

BAGETT, GRIFFITH & ASSOCIATES
La Grande, Oregon

Map of Survey

THE EAST 18' OF LOT 5 AND THE WEST 145' OF LOT 6, BLOCK 5
PLEASANT HOME ADDITION
LA GRANDE
UNION COUNTY, OREGON

SURVEYED FOR	PAUL SLANE	
SURVEYED BY	G T B	5-78
Scale: 1" = 60'	Drawn by: S S Z	5-78

6-7-78