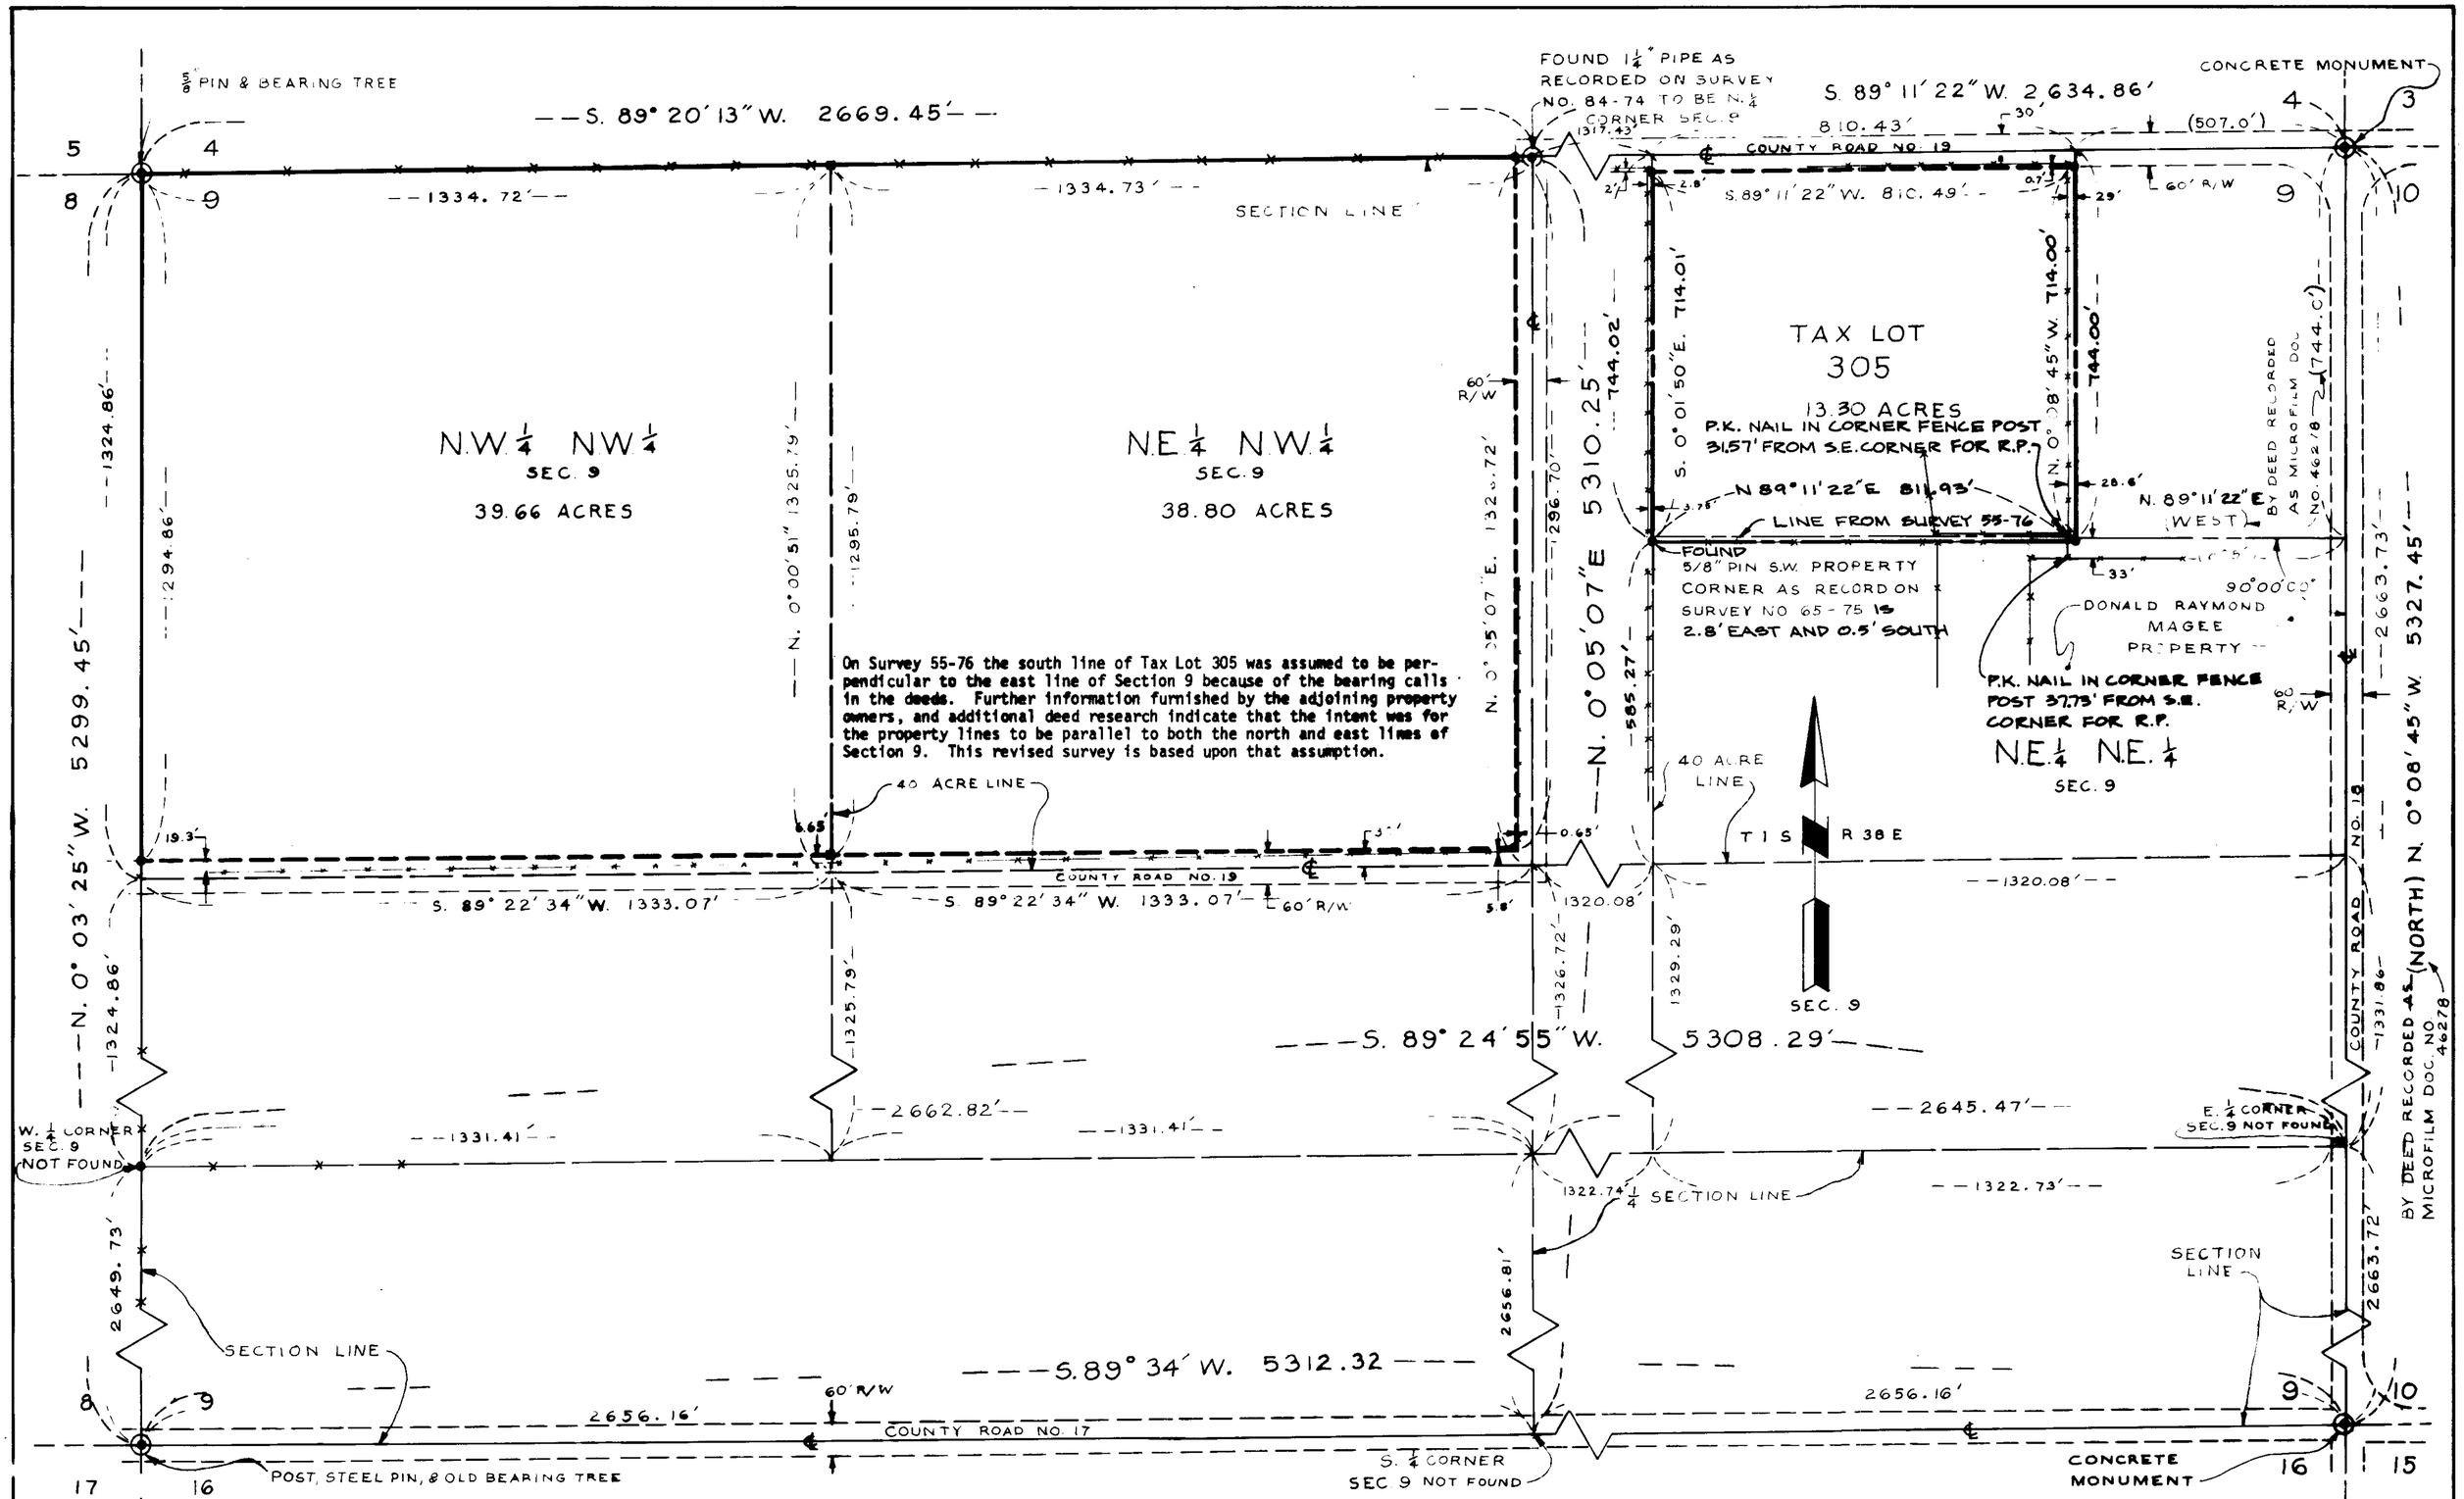

On Survey 55-76 the south line of Tax Lot 305 was assumed to be perpendicular to the east line of Section 9 because of the bearing calls in the deeds. Further information furnished by the adjoining property owners, and additional deed research indicate that the intent was for the property lines to be parallel to both the north and east lines of Section 9. This revised survey is based upon that assumption.

BASIS OF BEARING

SOUTH LINE OF SECTION BEING S. 89° 34' W ESTABLISHED BY G.L.O. AS RECORDED ON SURVEY NO. 111-73

REFERENCE MATERIAL

COUNTY SURVEYS
84-74
4-71
111-73
66-72
68-72
65-75

RECORD DEEDS
MICROFILM DOC. NO. 46278
44844
49408
48719

LEGEND

- ◉ FOUND MONUMENT OF RECORD
- ● SET 5/8" PIN
- □ SET 1/2" PIN
- ( ) RECORDED DATA

REVISED JUNE 13, 1978

REGISTERED PROFESSIONAL LAND SURVEYOR
OREGON
SEPTEMBER 23, 1977
HOWARD L. PERRY
1294

CORRECTION FOR MAP OF SURVEY 55-76
SECTION 9, T.1S., R.38E., W.M.
FOR: BILL BREAM

SCALE	ANDERSON · PERRY & ASSOCIATES, INC.	SHEET NO
1" = 200'	ENGINEERING, SURVEYING, AND MATERIALS TESTING	1
DATE NOV. 1976	LA GRANDE & ENTERPRISE, OREGON	

11-78

J/# 2552