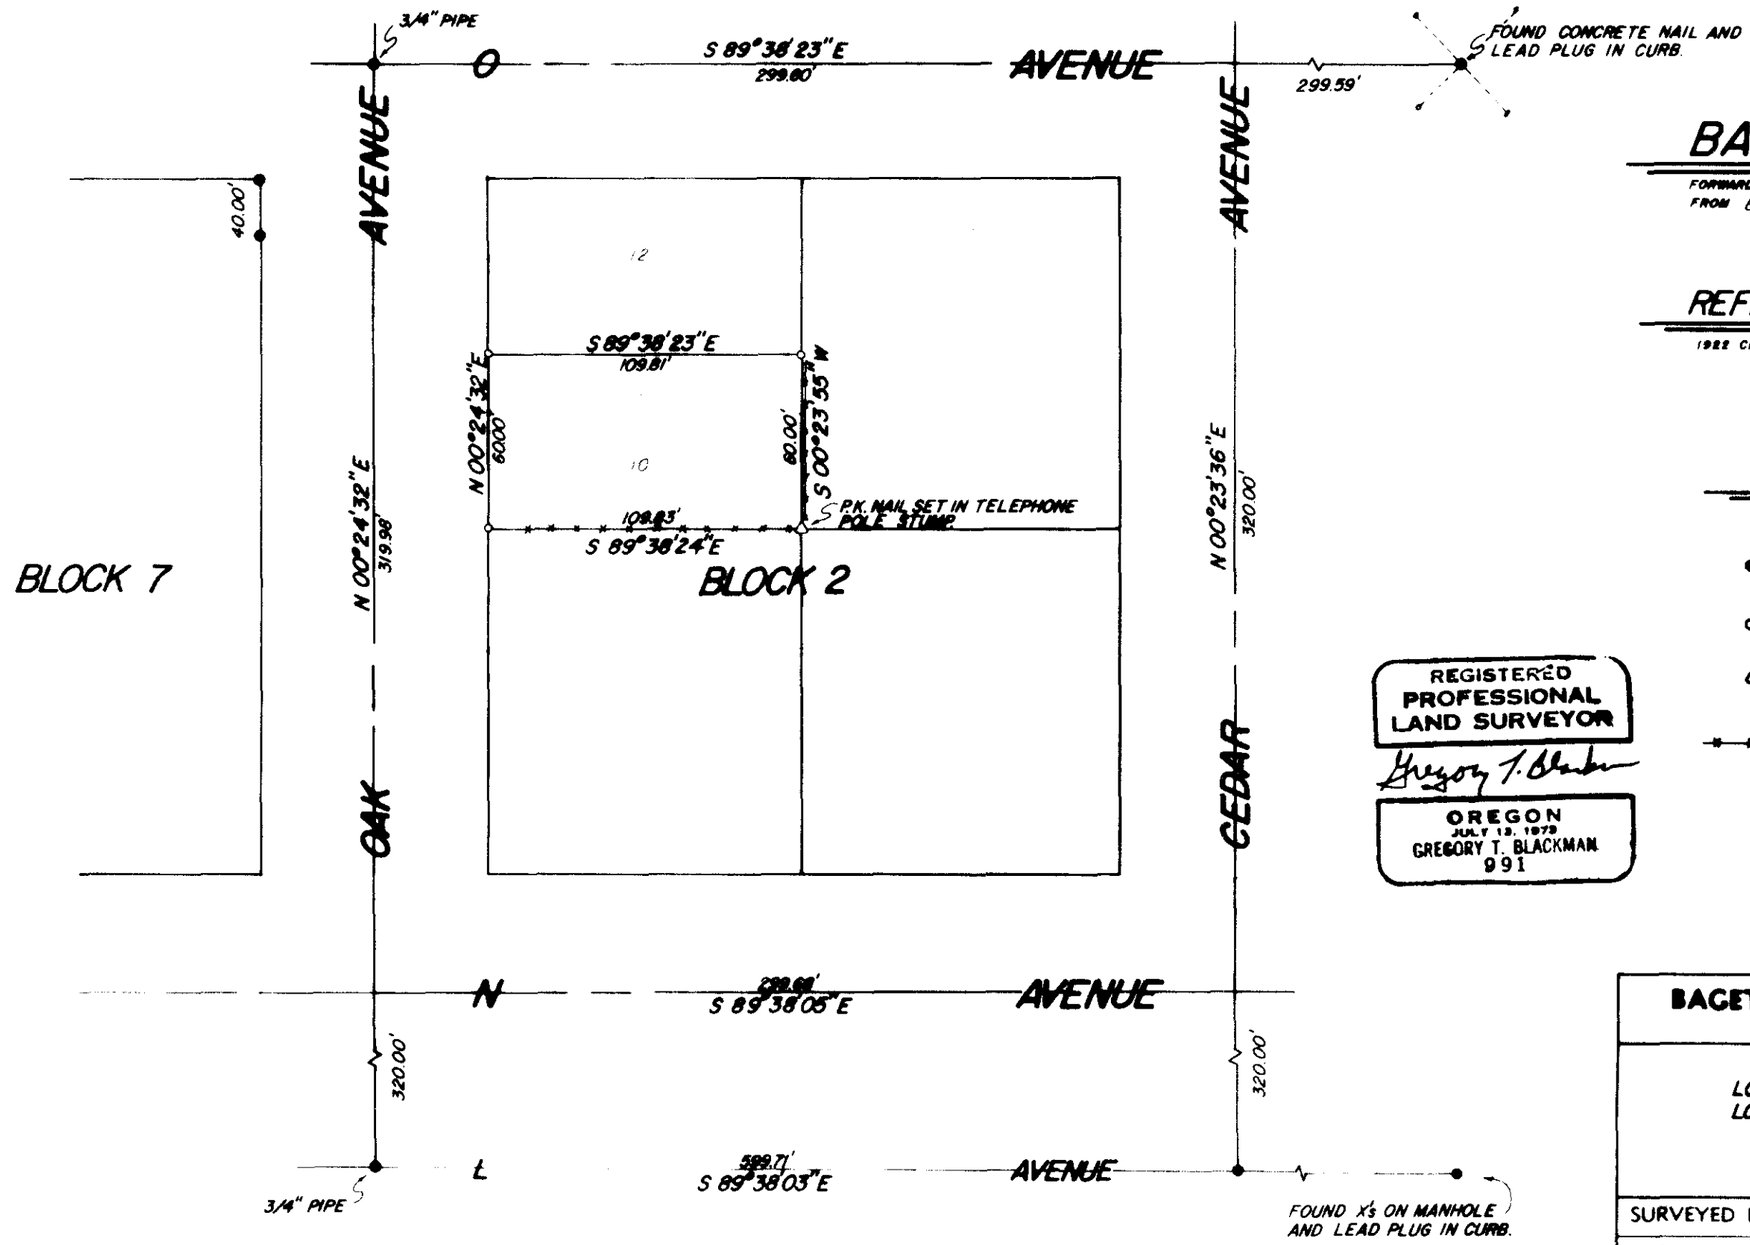

BASIS OF BEARING

FORWARD BEARING AS PUBLISHED BY THE U.S.C. AND G.S.
FROM △ COLLEGE TO △ VALLEY

REFERENCE MATERIAL

1922 CITY OF LAGRANDE REMONUMENTATION MAP
SURVEY NUMBER
5-66

LEGEND

- ● FOUND MONUMENT OF RECORD
- ○ SET 5/8" x 30" IRON PIN WITH PLASTIC CAP MARKED WITH B-G A SURVEY MARKER
- △ SET PK. NAIL IN TELEPHONE POLE STUMP
- —x—x— EXISTING FENCE

REGISTERED
PROFESSIONAL
LAND SURVEYOR
Gregory T. Blackman
OREGON
JULY 13, 1979
GREGORY T. BLACKMAN
991

BAGETT, GRIFFITH & ASSOCIATES
La Grande, Oregon

Map of Survey

LOT 10 AND THE SOUTH 1/2 OF
LOT 11, BLOCK 2 OF WISDOM'S ADDITION

LAGRANDE
UNION COUNTY, OREGON

SURVEYED FOR	KENNETH BRUCE
SURVEYED BY	GTB
Scale: 1" = 50'	Drawn by JJA