


**LEGEND**

- FOUND MONUMENT OF RECORD
- SET 5/8" x 30" IRON PIN WITH PLASTIC CAP MARKED B-G-A SURVEY MARKER.
- △ SET 1/2" x 24" IRON PIN
- ( ) RECORD BEARING AND DISTANCE

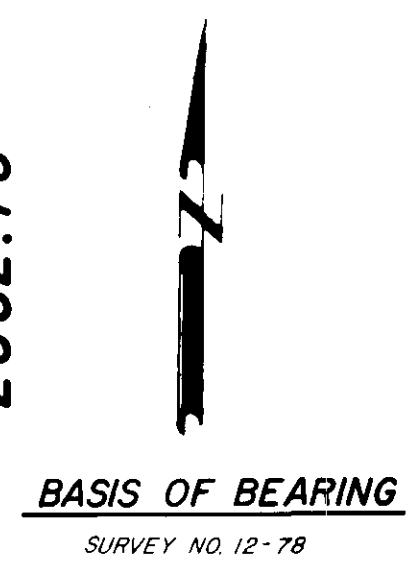

**REFERENCE MATERIAL**

PLAT OF MC DANIELS ADDITION  
 PLAT OF MC DANIELS 2ND ADD.  
 PLAT OF MC DANIELS 3RD ADD.  
 ORE. STATE HWY. DEPT. MAPS  
 MAP OF SURVEY NO. 94-74  
 MAP OF SURVEY NO. 24-76  
 MAP OF SURVEY NO. 27-76

**SURVEYOR'S STATEMENT**

I PLACE THESE ADDITIONS ON THE BASIS OF INFORMATION ON ORE. STATE HWY. DEPT. MAPS, SURVEYS AS SHOWN, EXISTING SURVEYED CORNERS, EXISTING LINES OF OCCUPANCY, AND THE GENERAL OVER ALL LOCATION OF EXISTING STREETS.

REGISTERED  
 PROFESSIONAL  
 LAND SURVEYOR

*Duane I. Griffith*

OREGON  
 JULY 10, 1964  
 DUANE I. GRIFFITH  
 644

BAGETT, GRIFFITH & ASSOCIATES La Grande, Oregon		
Map of Survey		
LOTS IN BLOCK M OF Mc DANIEL'S 2nd ADDITION TO COVE UNION COUNTY, OREGON		
SURVEYED FOR	JIM OVER	
SURVEYED BY	D. I. G.	July 1978
Scale: 1" = 60'	Drawn by: tdg	July 1978

94-78