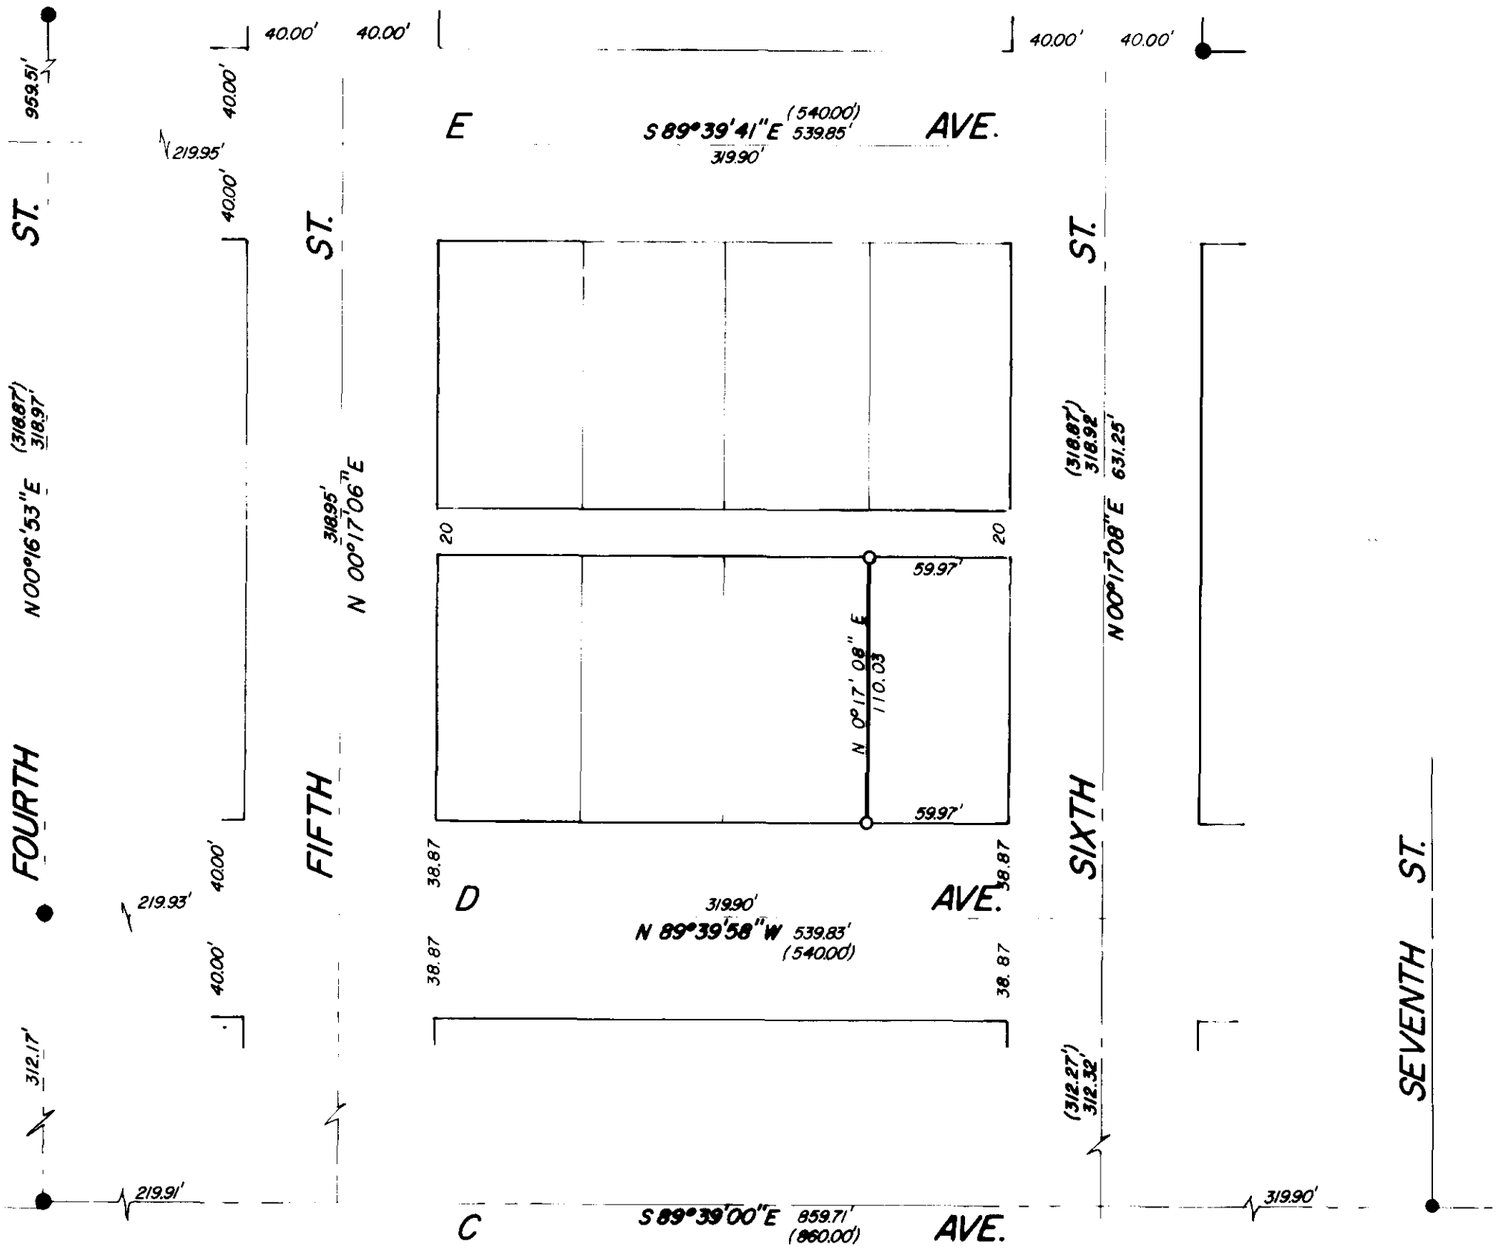

BASIS OF BEARING

FORWARD BEARING AS PUBLISHED BY THE U.S.C. AND G.S. FROM △ COLLEGE TO △ VALLEY.

LEGEND

- ● FOUND MONUMENT OF RECORD
- ○ SET 5/8" x 30" IRON PIN WITH PLASTIC CAP MARKED B·G·A SURVEY MARKER
- ( ) RECORD BEARING AND DISTANCE

REGISTERED PROFESSIONAL LAND SURVEYOR

OREGON JULY 10, 1984 DUANE I. GRIFFITH 644

REFERENCE MATERIAL

1922 CITY OF LAGRANDE REMONUMENTATION MAP

SURVEY NO. 44

SURVEY NO. 128

BAGETT, GRIFFITH & ASSOCIATES
La Grande, Oregon

Map of Survey

LINE BETWEEN LOTS 5 & 6 BLK. 12
CHAPLIN'S ADDITION

LAGRANDE
UNION COUNTY, OREGON

SURVEYED FOR	JOHN SHANNON & SCOTT BOHNENKAMP	
SURVEYED BY	DIG	6-78
Scale: 1"= 60'	Drawn by: GTB	7-78

96-78