NOTE: IN THE FALL OF 1977 MOST OF THE MONUMENTS IN THE INTERSECTION OF THE STREET CENTERLINES WERE DESTROYED WHEN SEWER LINES WHERE INSTALLED. AT THE TIME OF THIS SURVEY THE REMONUMENTATION OF RIVERSIDE ADDITION HAD NOT BEEN COMPLETED BY BAGETT, GRIFFITH & ASSOCIATES. THIS SURVEY IS BASED ON THE RECORD SURVEYS OF BAGETT, GRIFFITH & ASSOCIATES WHICH THEY SAID WOULD CONTROL THE REMONUMENTATION IN THIS AREA OF RIVERSIDE ADDITION.

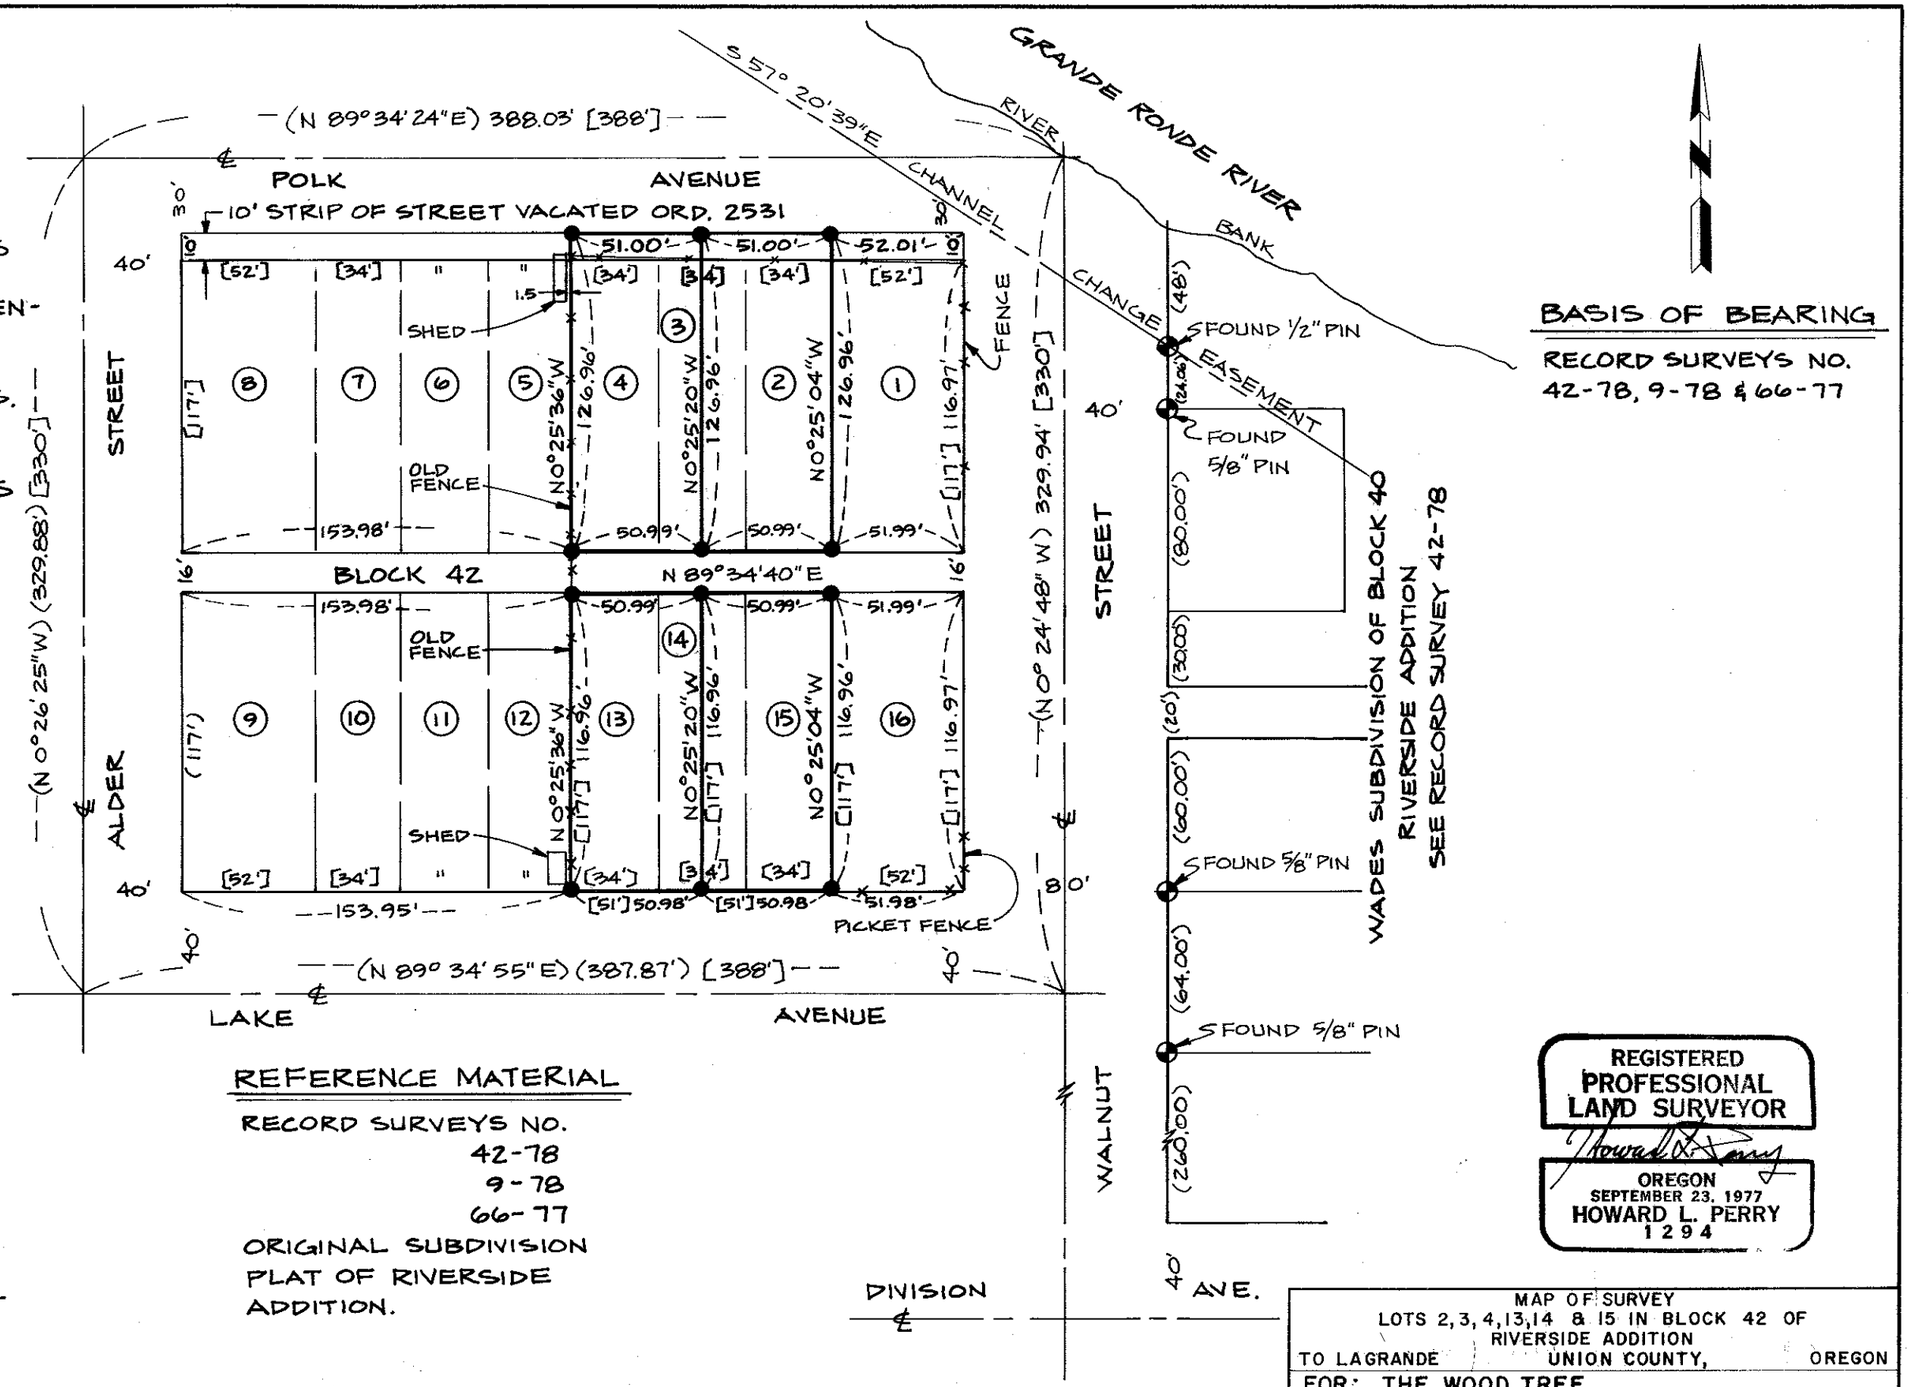

BASIS OF BEARING

RECORD SURVEYS NO. 42-78, 9-78 & 66-77

LEGEND

- ◒ MONUMENT OF RECORD
- ● SET 5/8" x 30" STEEL PIN W/ CAP MARKED AP&A.
- ( ) RECORD SURVEY DATA
- [ ] RECORD DATA FROM ORIGINAL SUBDIVISION PLAT
- (1) LOT NUMBER

REFERENCE MATERIAL

RECORD SURVEYS NO.
42-78
9-78
66-77
ORIGINAL SUBDIVISION PLAT OF RIVERSIDE ADDITION.

REGISTERED PROFESSIONAL LAND SURVEYOR
OREGON
SEPTEMBER 23, 1977
HOWARD L. PERRY
1294

MAP OF SURVEY
LOTS 2, 3, 4, 13, 14 & 15 IN BLOCK 42 OF RIVERSIDE ADDITION
TO LAGRANDE UNION COUNTY, OREGON
FOR: THE WOOD TREE

SCALE: 1" = 60'
DATE: JULY, 78

anderson perry & associates, inc.
engineering · surveying · materials testing
LA GRANDE & ENTERPRISE, OREGON

SHEET NO. 1 / 1

42-28

J# 2639