



BASIS OF BEARING
SOLAR OBSERVATIONS,
at the N.E. corner sect 21.

LEGEND

- FOUND MONUMENT OF RECORD
- SET 5.8" X 30" IRON PIN
- () RECORD BEARING & DISTANCE

REFERENCE MATERIAL

MAP OF SURVEY NO'S.
85-71
69-73
32-78
OSHW MAP NO'S.
4B-26-11
8B-31-25
G.L.O. NOTES


REGISTERED
PROFESSIONAL
LAND SURVEYOR

OREGON
JULY 10, 1964
DUANE I. GRIFFITH
644

BAGETT, GRIFFITH & ASSOCIATES
La Grande, Oregon

Map of Survey
The W 1/2 of the E 1/2 of the
SW 1/4 of the NW 1/4 of
Section 20, T 1 N, R 39 E, WM
UNION COUNTY, OREGON

SURVEYED FOR	DELMAN McCALLISTER
SURVEYED BY	d.i.g.
Scale: 1" = 500'	Drawn by: d.i.g. Aug. 1978

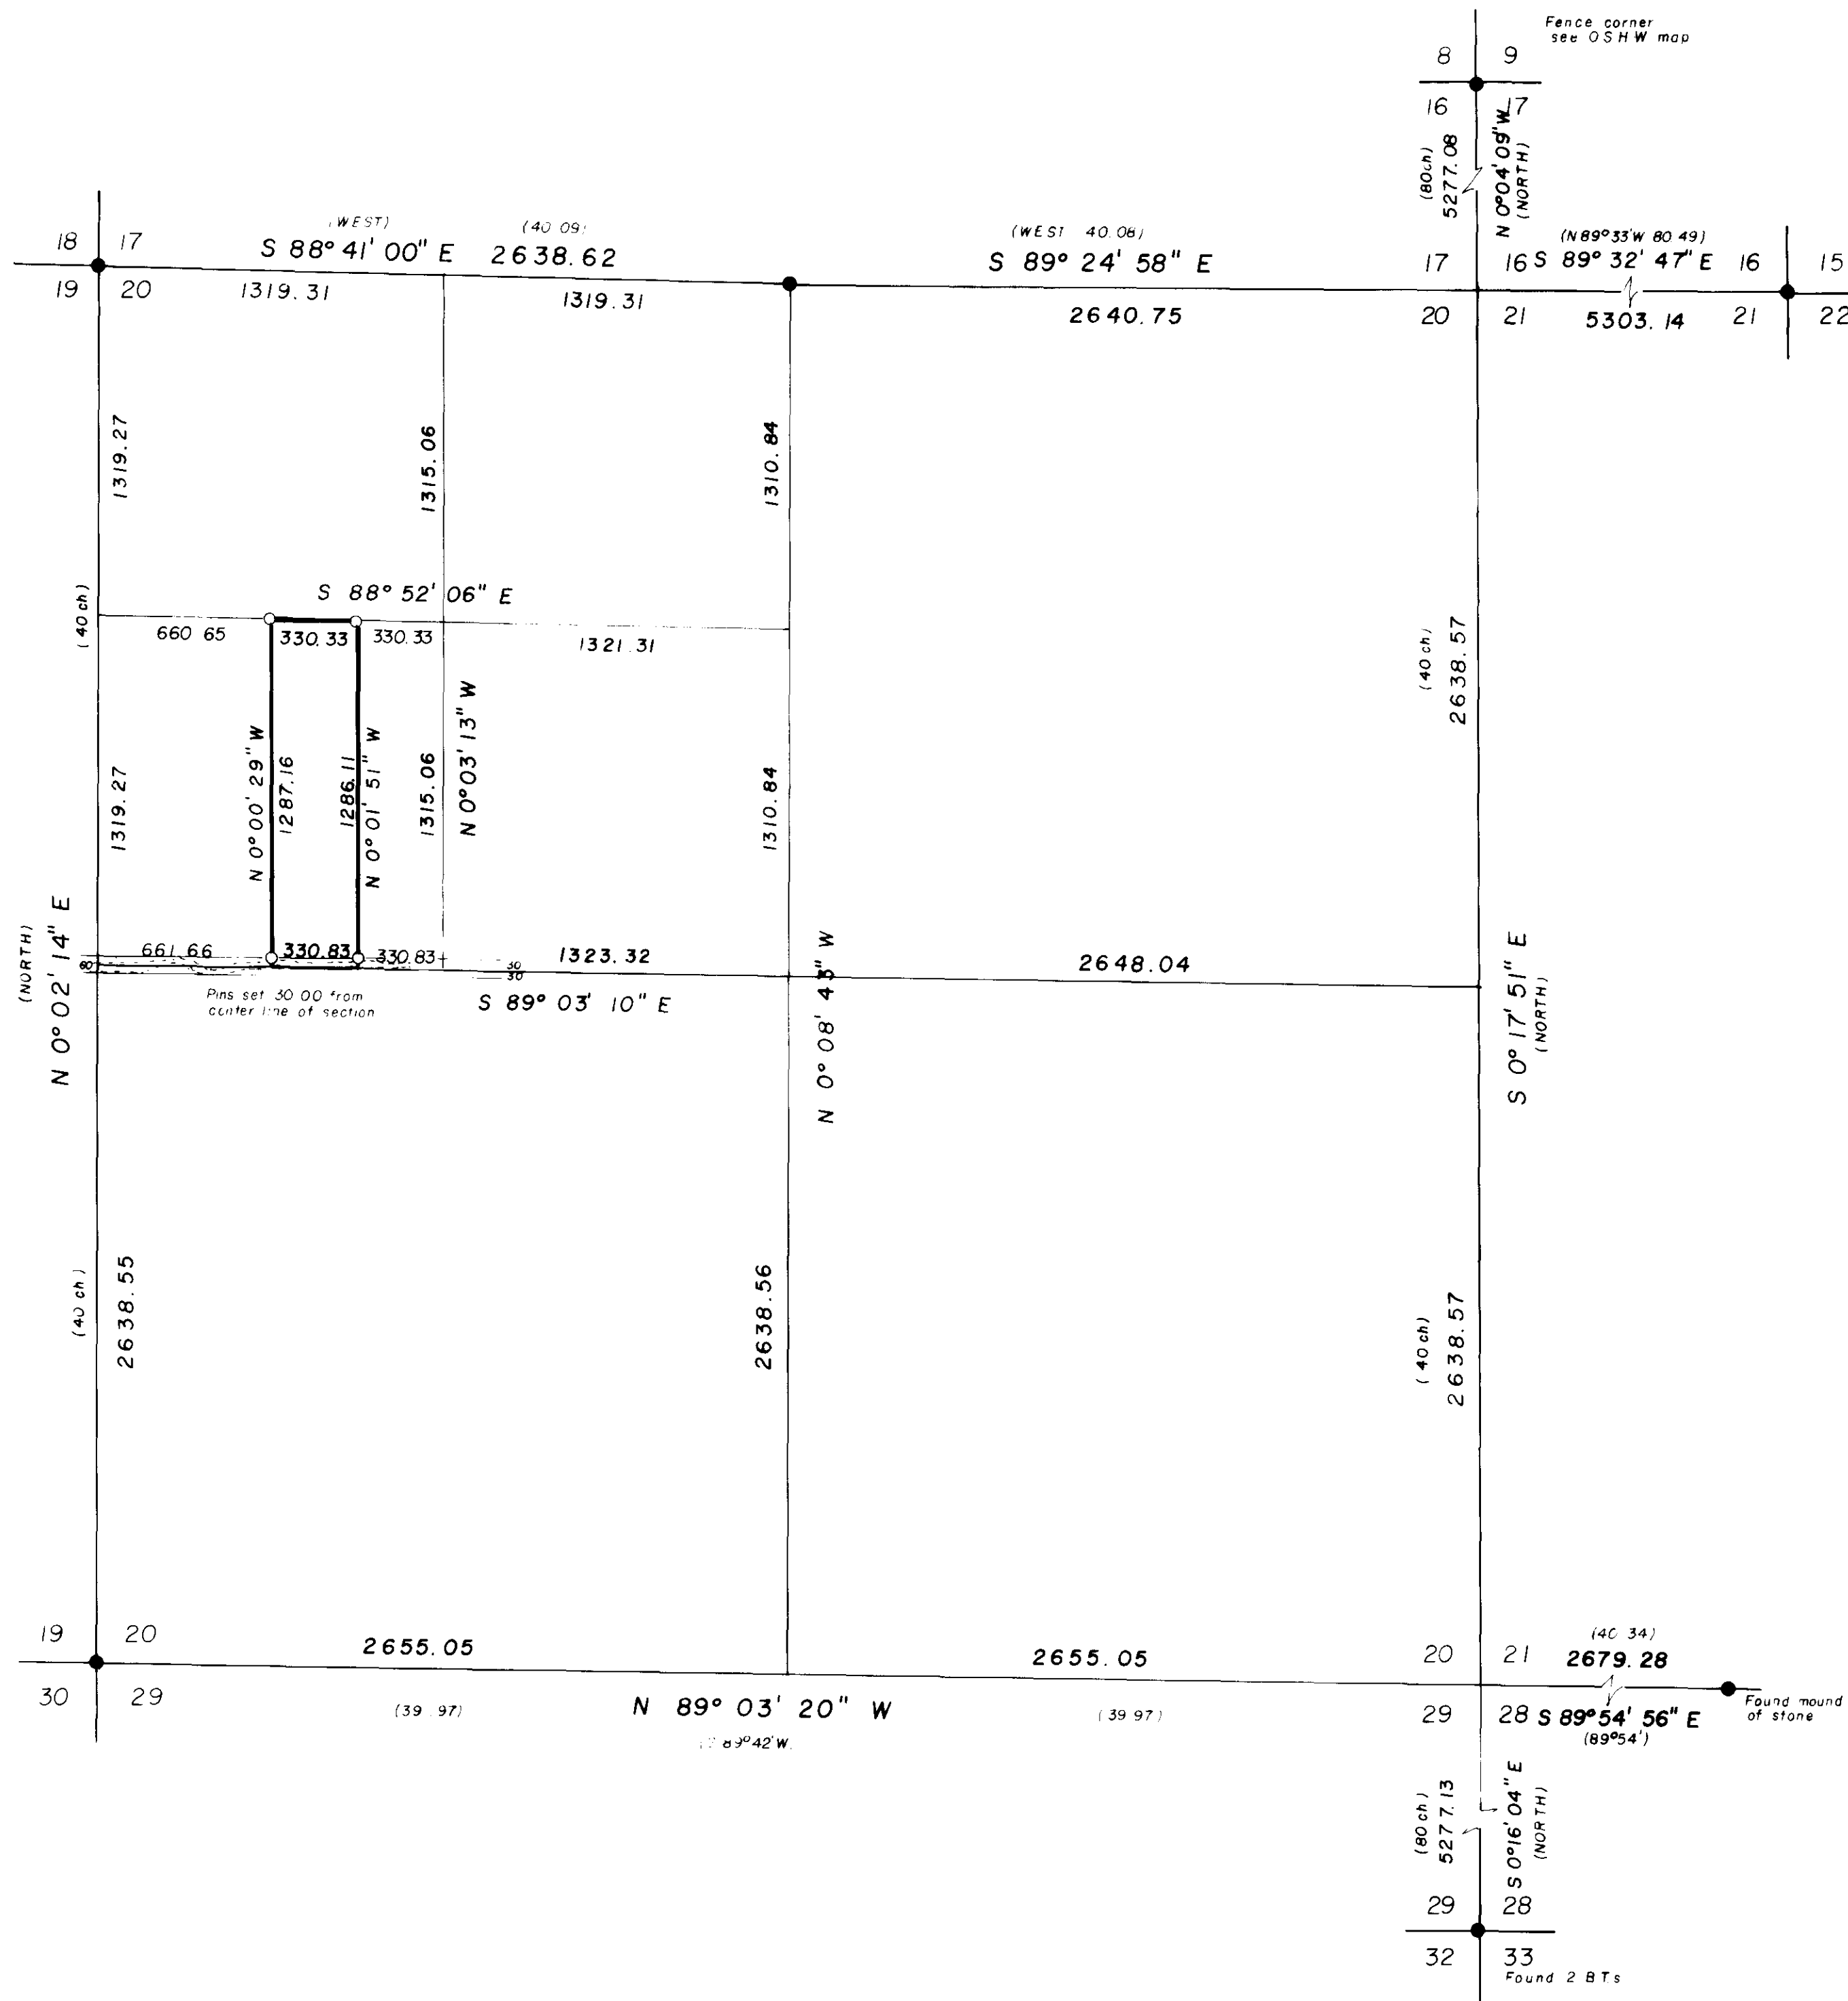

111-78