


REFERENCE MATERIAL

SURVEY NUMBERS
32-71
22-72
49-78
79-78

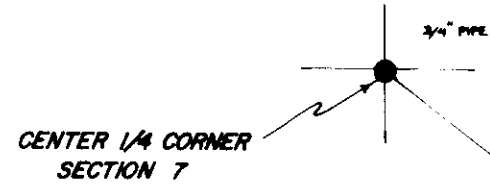

BASIS OF BEARING

SURVEY NUMBERS
32-71
49-78

LEGEND

- FOUND MONUMENT OF RECORD
- SET 5/8" x 30" IRON PIN WITH PLASTIC CAP MARKED B G A SURVEY MARKER
- CENTERLINE STREET
- () RECORD BEARING AND DISTANCE

REGISTERED
PROFESSIONAL
LAND SURVEYOR

OREGON
JULY 13, 1978
GREGORY T. BLACKMAN
991

BAGETT, GRIFFITH & ASSOCIATES


La Grande, Oregon

Map of Survey

PARCEL IN THE NW 1/4 OF THE SE 1/4
SECTION 7 T 3 S, R 30 E WM

LA GRANDE
UNION COUNTY, OREGON

SURVEYED FOR	DICK STAAB	
SURVEYED BY	G T B	7-78
Scale: 1" = 30'	Drawn by: S S Z	7-78

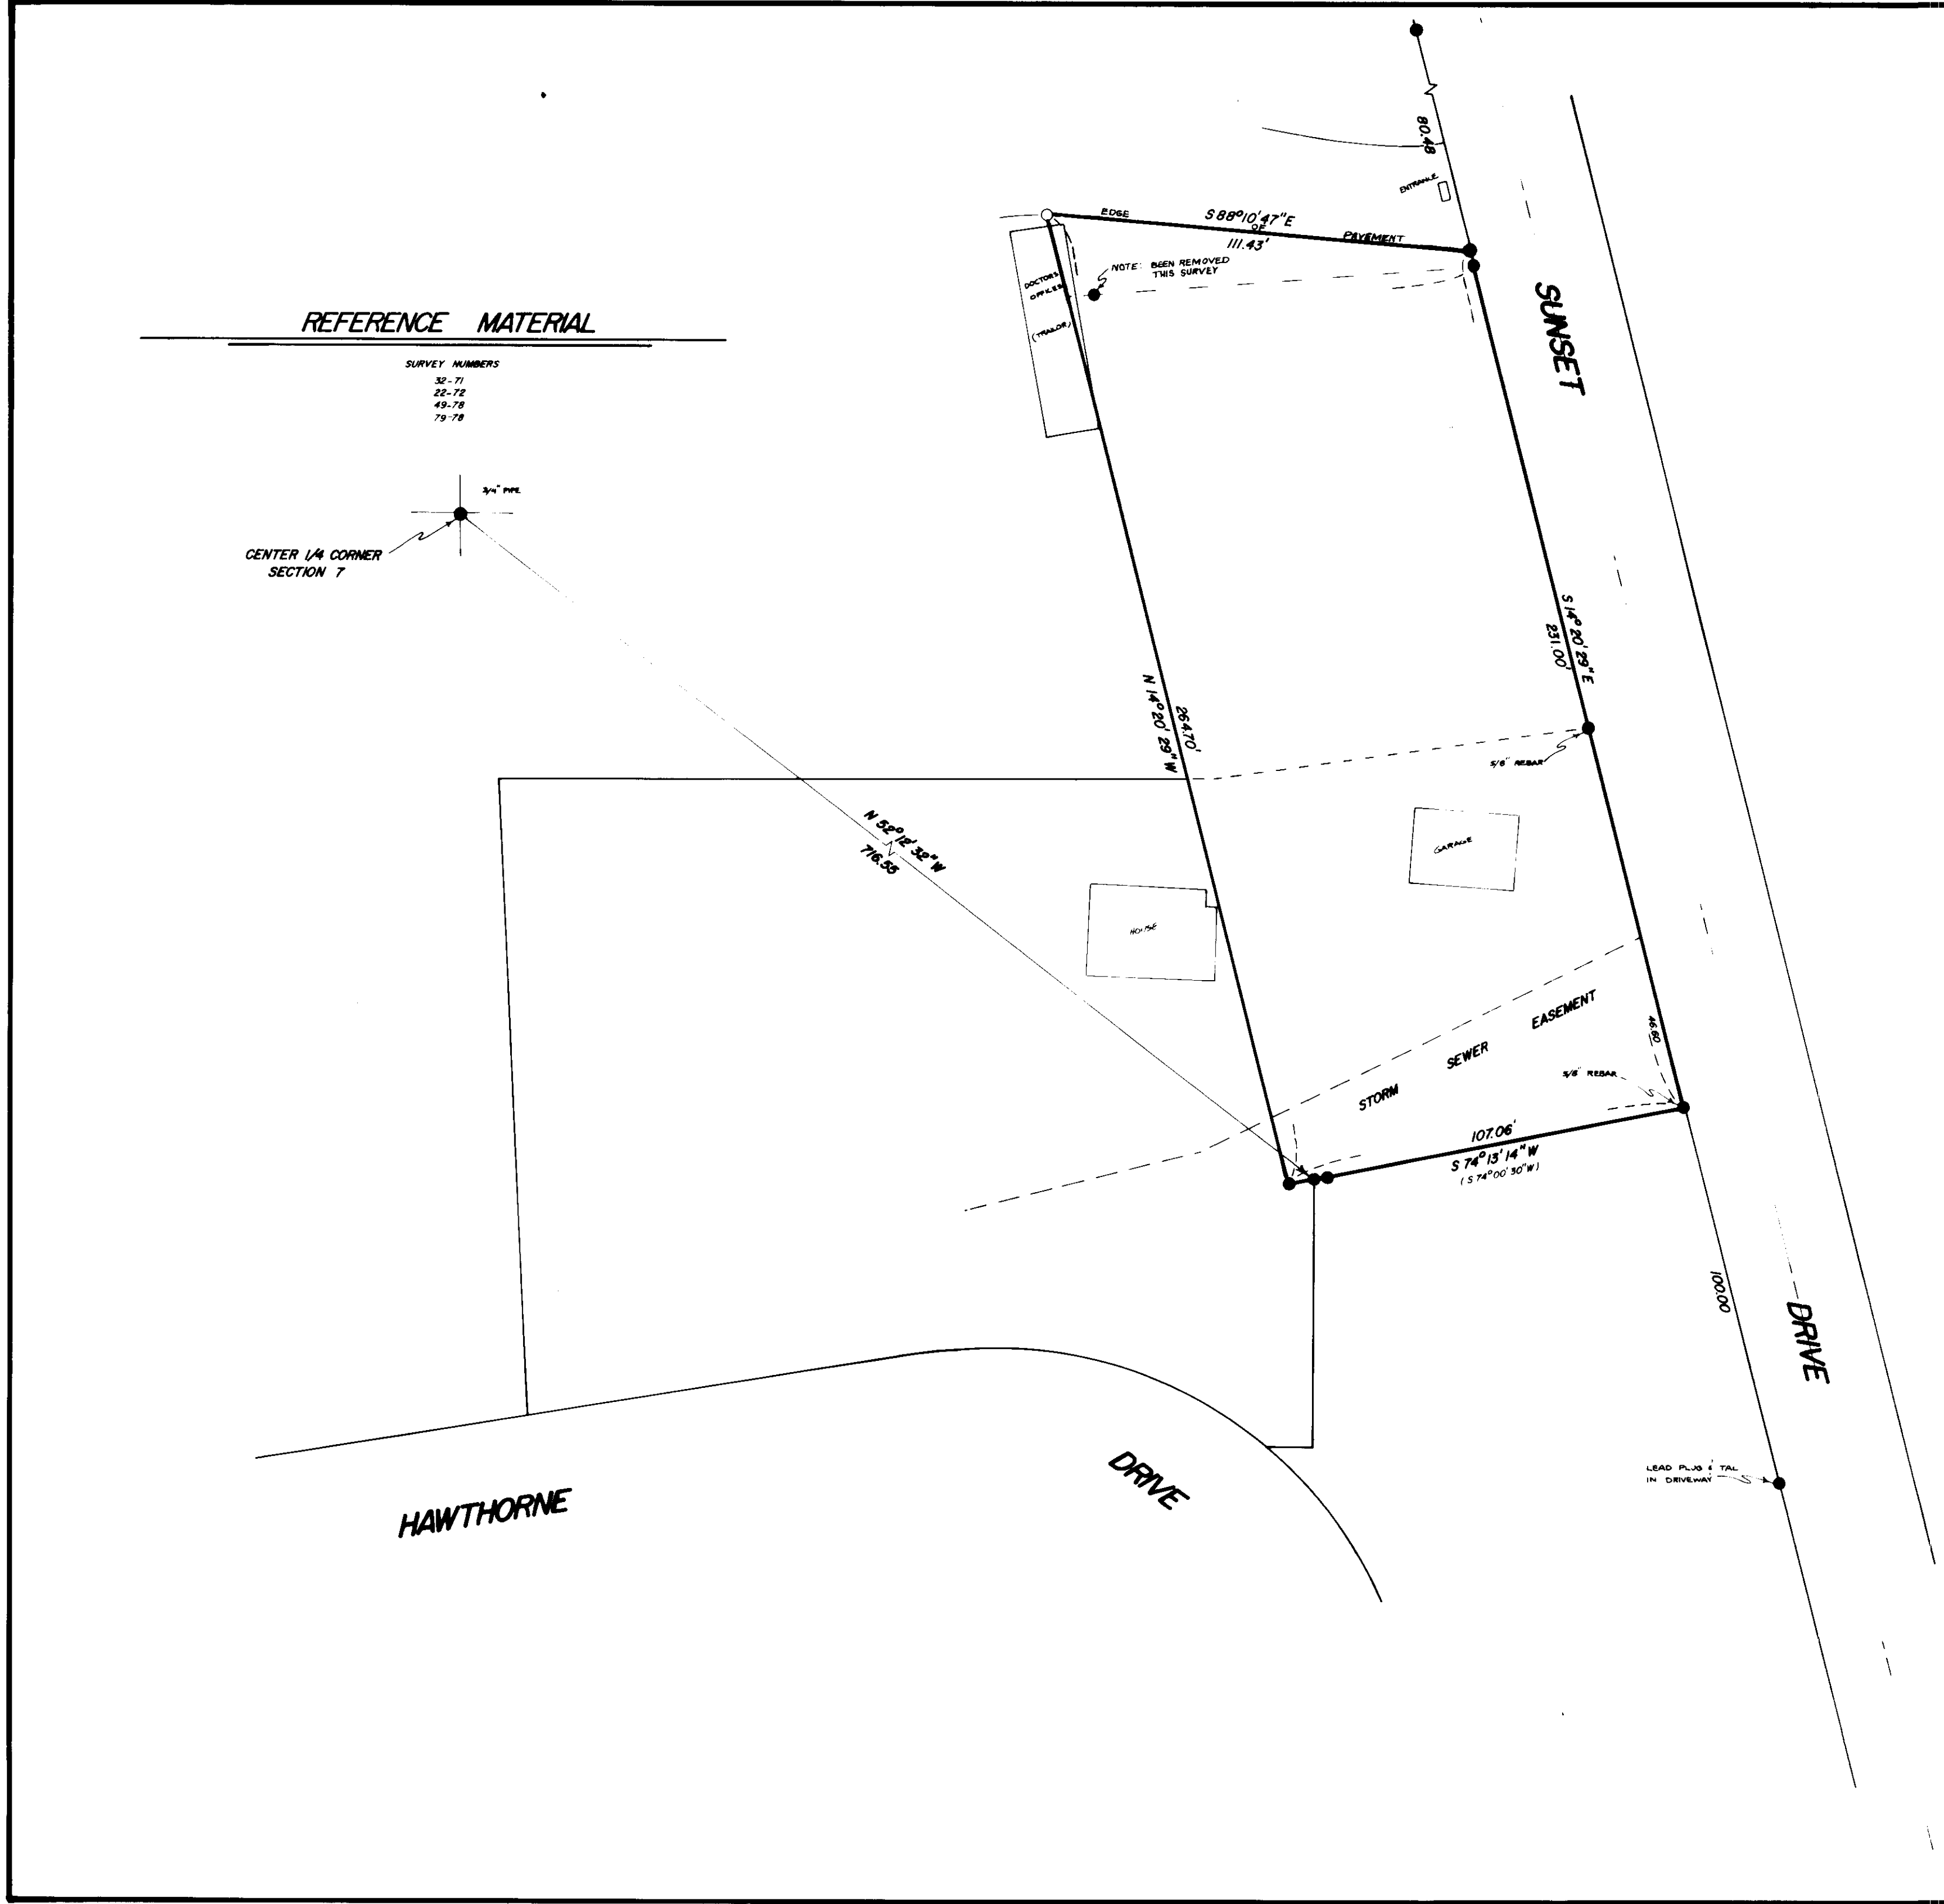

82-711