

LEGEND


- ⊕ FOUND OLD 3/4" STEEL PIN
- SEARCHED FOR BUT COULD NOT FIND ANY OLD PINS.
- SET 5/8" x 30" STEEL PIN W/ CAP MARKED AP&A.
- ① BLOCK NUMBERS
- *** FENCE

REFERENCE MATERIAL

ORIGINAL PLAT OF THE TOWN OF IMBLER

NARRATIVE

THE BEARINGS OF THE STREETS ARE BASED ON THE OLD MONUMENTS FOUND. THERE IS NO RECORD ON THE ORIGINAL PLAT OF THE TOWN OF IMBLER THAT ANY MONUMENTS WERE ORIGINALLY SET. THE PINS FOUND ARE OLD SOLID STEEL PINS WHICH ARE ASSUMED TO HAVE BEEN SET AROUND THE TIME THE TOWN WAS ESTABLISHED. PAROLE EVIDENCE THROUGHOUT THE TOWN OF IMBLER VERIFY THE VALIDITY OF THE OLD PINS FOUND.

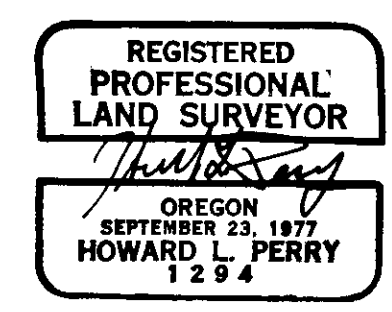

MAP OF SURVEY PROPERTY LOCATED ON UNION PACIFIC RAILROAD PROPERTY IN THE TOWN OF IMBLER, OREGON		
FOR: GRANDE RONDE GRAIN COMPANY		
SCALE		SHEET NO
DATE		1 / 1
AUG. 1978	LA GRANDE & ENTERPRISE OREGON	

117-78