


BASIS OF BEARING

Survey No. 63-73

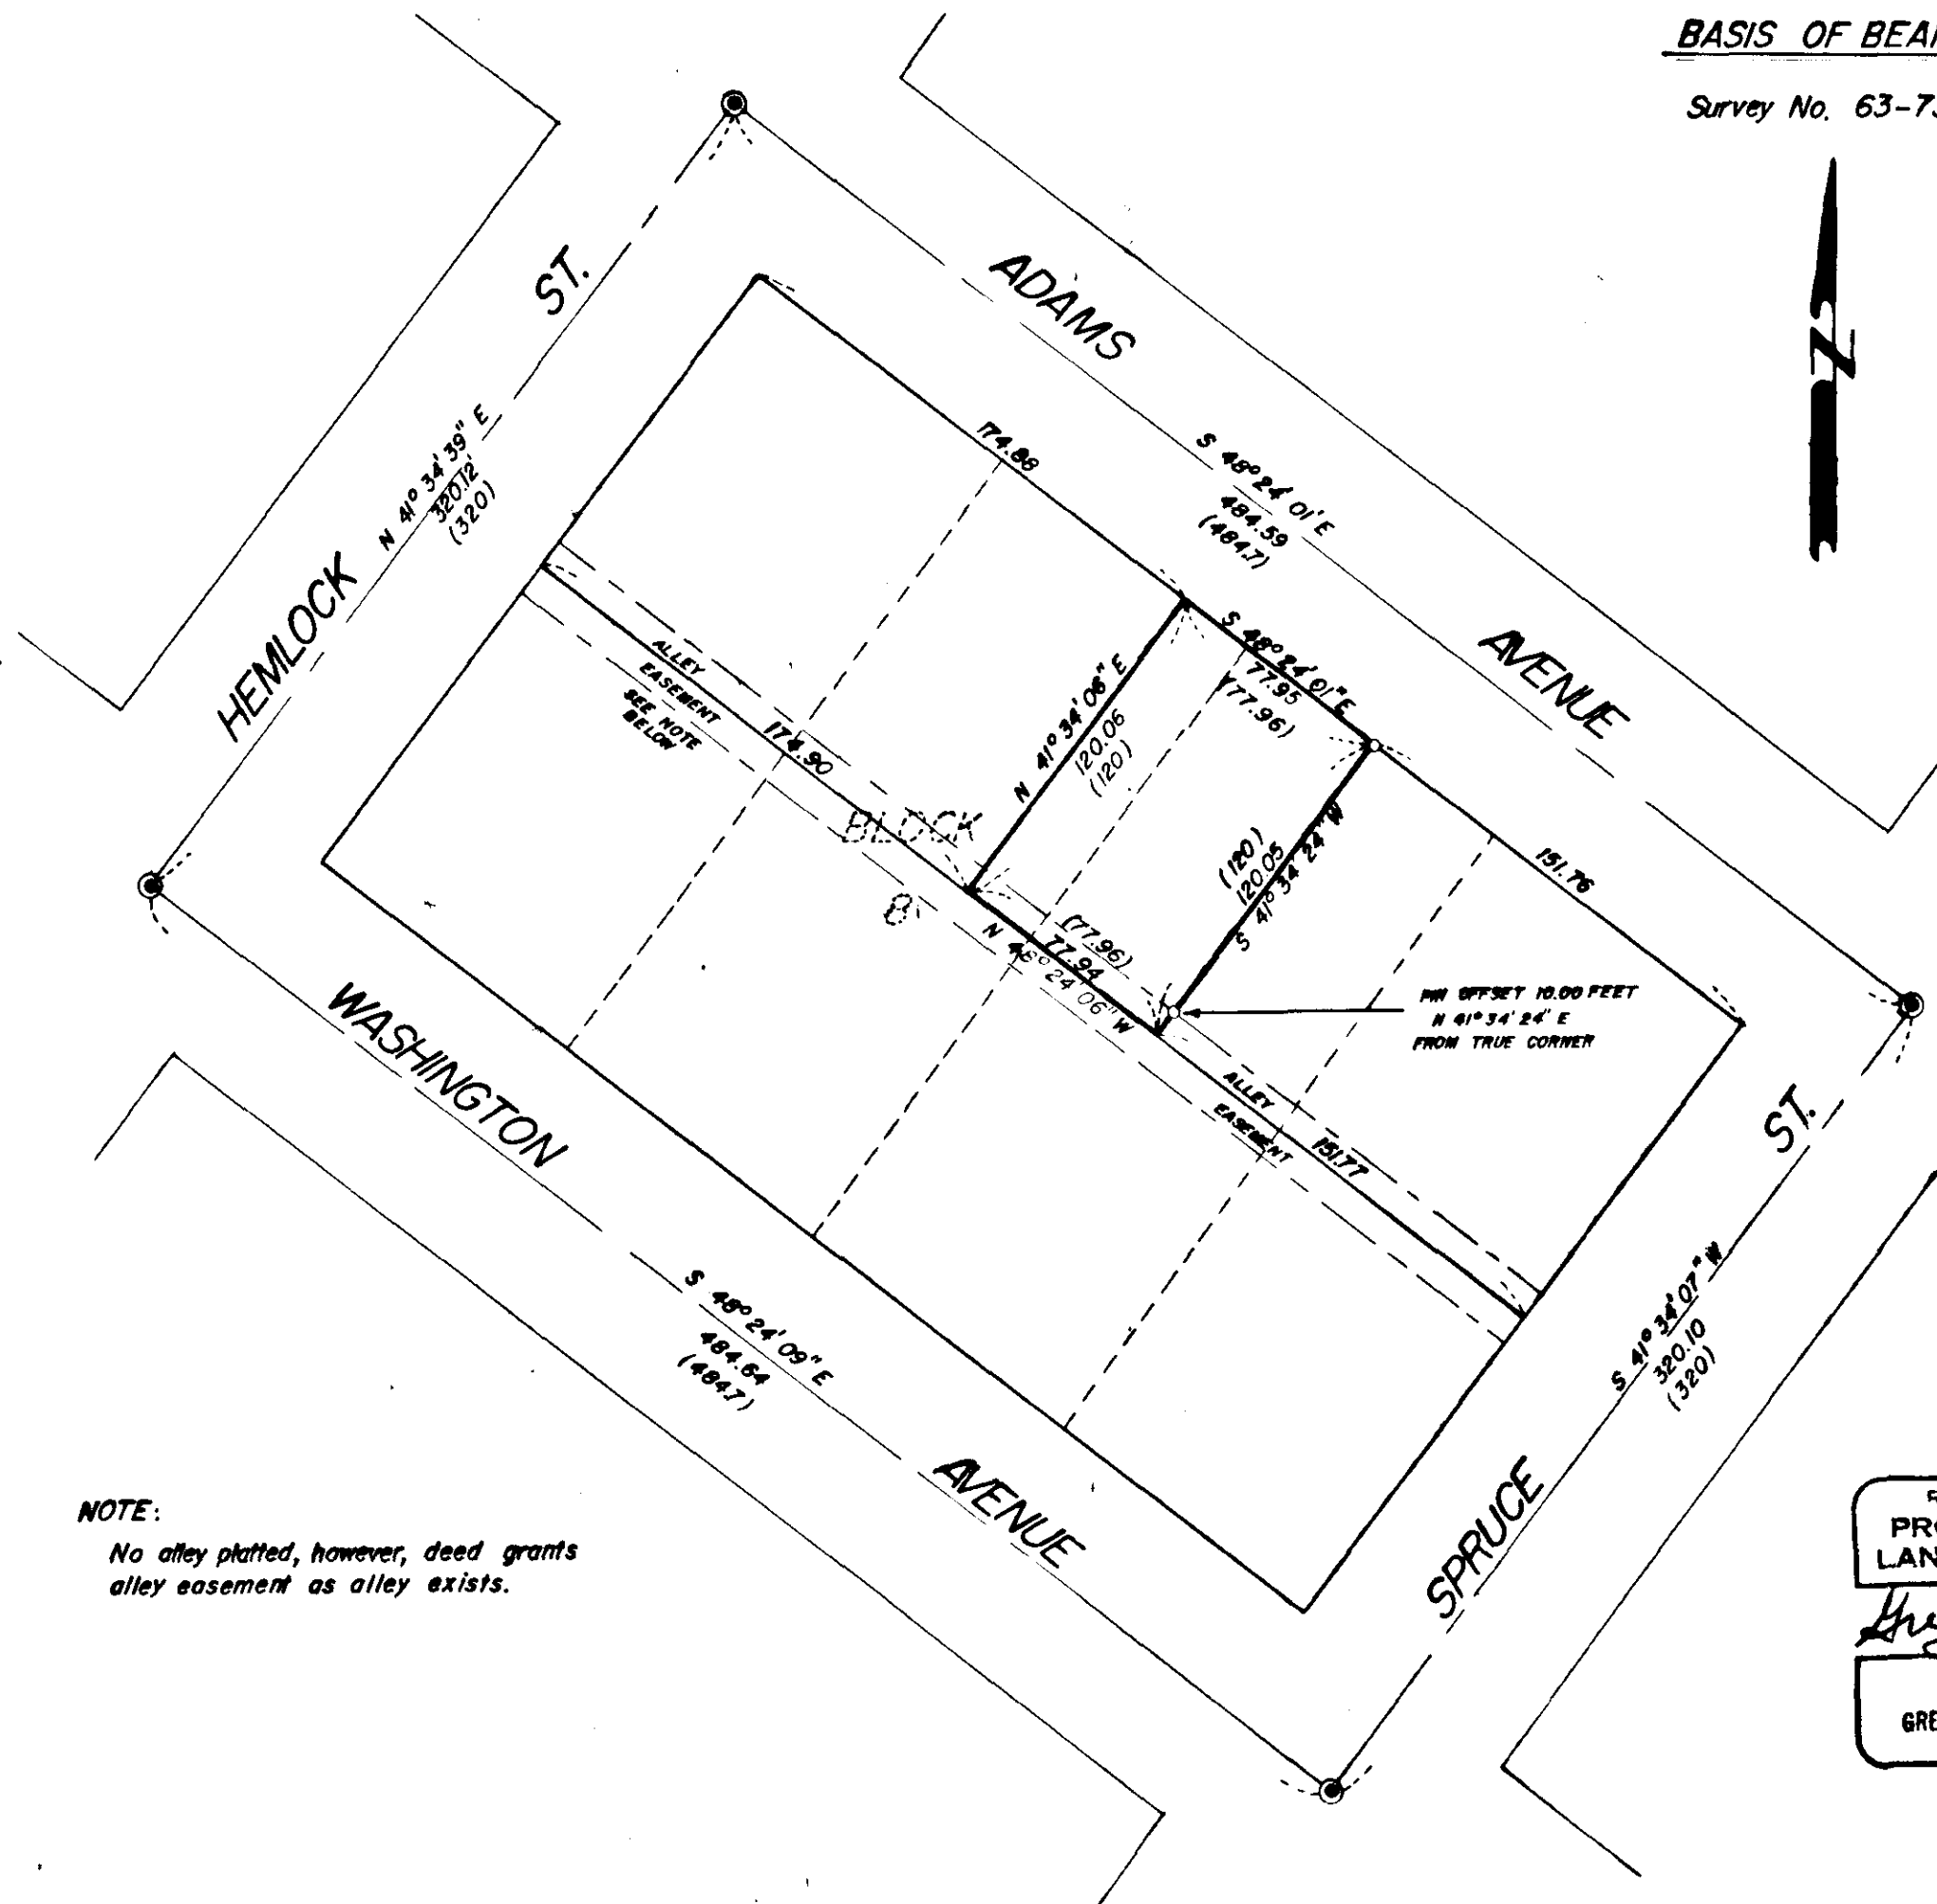

LEGEND

- FOUND MONUMENT OF RECORD
- SET 5/8" x 30" IRON PIN WITH PLASTIC CAP STAMPED B G A SURVEY MARKER
- () RECORD DISTANCE

Reference Material

SURVEY NO. 63-73

NOTE:
No alley platted, however, deed grants alley easement as alley exists.

REGISTERED
PROFESSIONAL
LAND SURVEYOR

Gregory T. Blackman

OREGON
JUL 3 1973
GREGORY T. BLACKMAN
991

BAGETT, GRIFFITH & ASSOCIATES		
La Grande, Oregon		
Map of Survey		
NW HALF OF LOT 2 & SE 27.36 FEET OF LOT 3, BLOCK 8		
COGGIN'S ADDITION		
LA GRANDE		
UNION COUNTY, OREGON		
SURVEYED FOR	LYNCH MOTOR COMPANY	
SURVEYED BY	GTB	9/78
Scale: 1" = 60'	Drawn by: RGR	9/78

123-78