


HIGHWAY ACRES

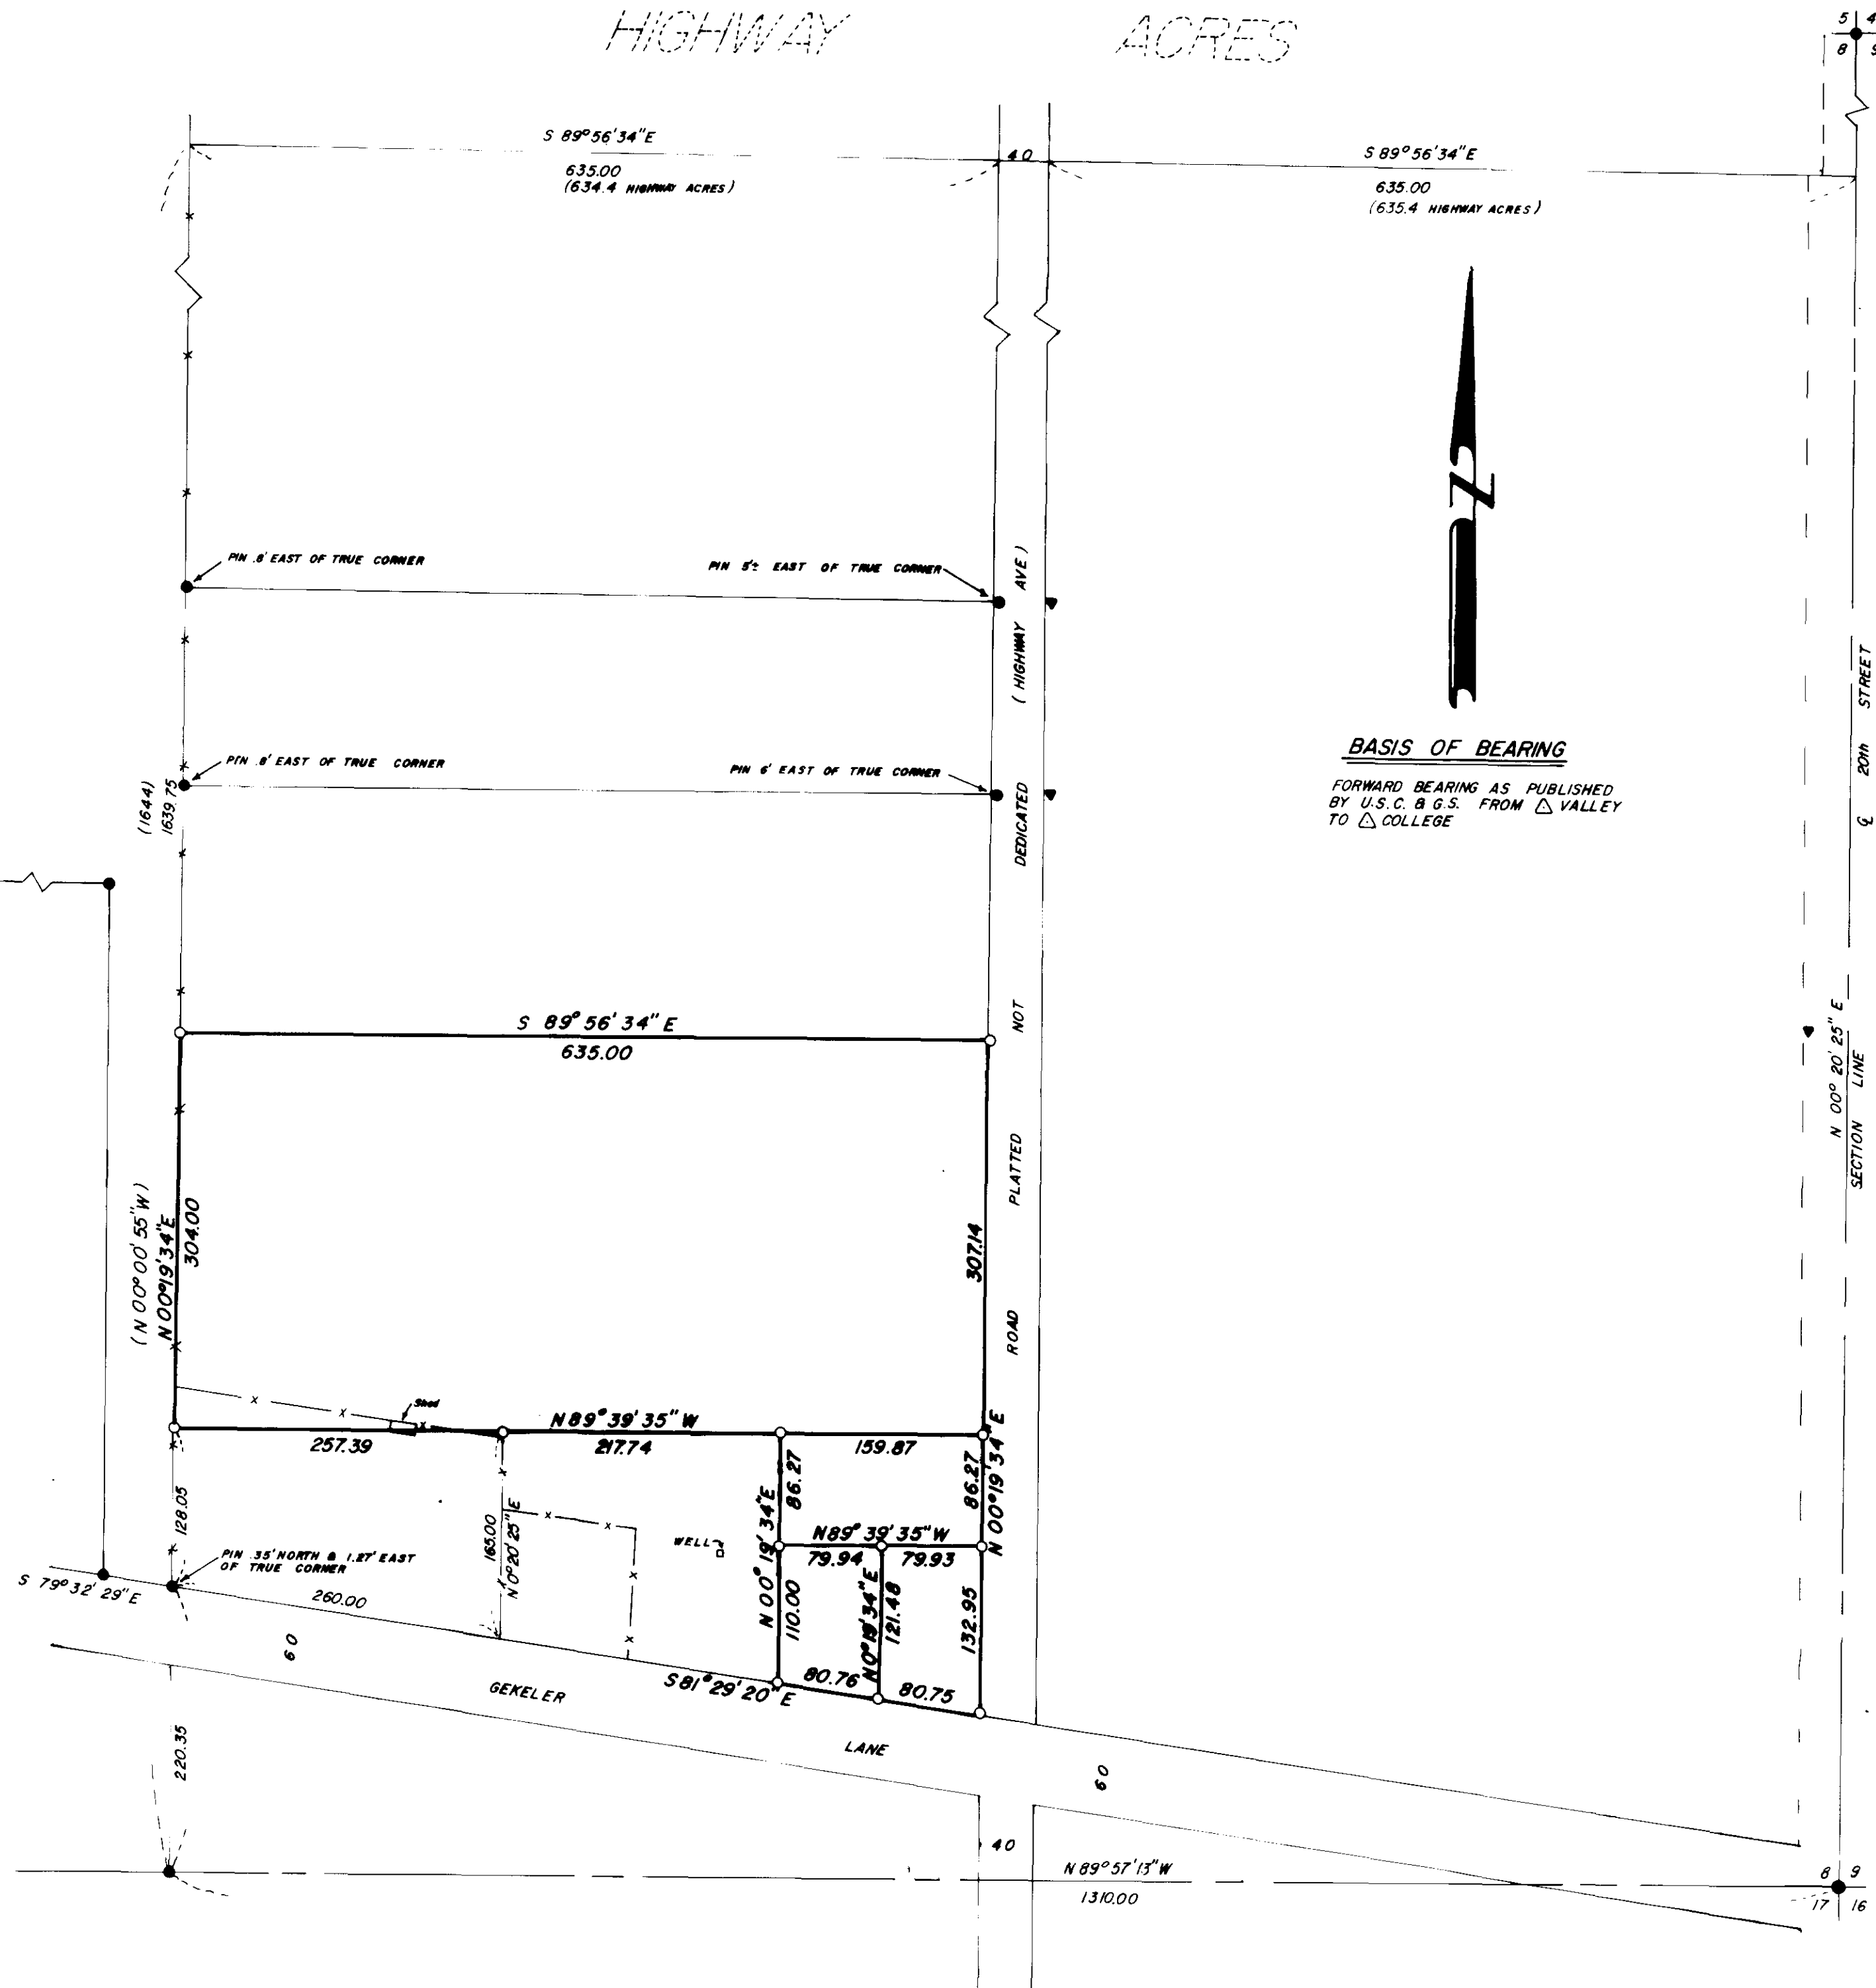

NOTE:  
HIGHWAY ACRES PLAT SHOWS 20th STREET AS BEING 25 FEET WEST OF SECTION LINE WHILE RUSSELL TRACTS SHOW 35 FEET WEST OF SECTION LINE

LEGEND

- SET 5/8" x 30" IRON PIN WITH PLASTIC CAP MARKED B G A SURVEY MARKER
- FOUND MONUMENT OF RECORD
- ▼ FOUND UNRECORDED PIN
- ( ) RECORD DISTANCE OR BEARING
- x - FENCELINE

REFERENCE MATERIAL

HIGHWAY ACRES PLAT  
UNRECORDED PLAT OF RUSSELLS TRACTS  
1922 CITY OF LA GRANDE REMONUMENTATION MAP  
SURVEY NO. 22-71  
SURVEY NO. 7-75  
SURVEY NO. 23-75

REGISTERED  
PROFESSIONAL  
LAND SURVEYOR

*Gregory T. Blackman*

OREGON  
JUL 1 1973  
GREGORY T. BLACKMAN  
971

**BAGETT, GRIFFITH & ASSOCIATES**  
La Grande, Oregon

Map of Survey  
A PORTION OF THE  
SE 1/4 OF THE SE 1/4 OF SECTION 8  
T3S R38 E W.M.  
LA GRANDE  
UNION COUNTY, OREGON

SURVEYED FOR	CRAFT WALL INC.	
SURVEYED BY	GTB	9/78
Scale: 1" = 100'	Drawn by: RGR	9/78

124-78