


FOUND 1/2" IRON ROD IN CONC.

ORIG. 1/4 COR. NOT FOUND

FOUND 1" IRON PIPE

NOTE: PROPERTY CORNERS WERE NOT SET ON THE SOUTH PROPERTY LINE OF THE PARCEL. THIS LINE IS CONTROLLED BY THE EAST-WEST 1/16 LINE OF THE NE 1/4 OF SEC. 22. DUE TO THE EXPENSE OF REESTABLISHING THIS 1/16 LINE, THE PROPERTY OWNER DECIDED NOT TO HAVE THE SOUTH PROPERTY LINE LOCATED. HUBS & TACKS WERE SET ON THE EAST & WEST PROPERTY LINES NEAR THE EXISTING SOUTH FENCE FOR THE EAST & WEST PROPERTY LINE ALIGNMENT.

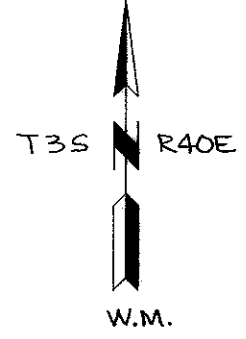

LEGEND

- ⊕ FOUND MONUMENT OF RECORD
- SET 5/8" x 30" IRON ROD WITH CAP MARKED A & A
- ⊠ SET HUB & TACK AS NOTED
- () RECORD DATA

FOUND 2" IRON PIPE FOR C 1/4 COR. AS PER R.S. # 64-78

REFERENCE MATERIAL

RECORD SURVEY # 64-78

BASIS OF BEARING

RECORD SURVEY # 64-78

REGISTERED PROFESSIONAL LAND SURVEYOR

OREGON SEPTEMBER 23, 1977 HOWARD L. PERRY 1294

MAP OF SURVEY		
PARCEL IN THE NW 1/4, NW 1/4, NE 1/4 SEC. 22, T3S, R40E, W.M.		
FOR: JOHN HUGGINS		
SCALE: 1" = 100'		SHEET NO. 1/1
DATE: 1978		LA GRANDE & ENTERPRISE, OREGON

J# 2659


153-78