

LEGEND

- FOUND MONUMENT OF RECORD
- FOUND UNRECORDED MONUMENT AS SHOWN
- SET 5/8" x 30" IRON PIN WITH PLASTIC CAP MARKED BGA SURVEY MARKER
- () RECORD DISTANCE AND BEARING

REFERENCE MATERIAL

SURVEY NO. 7-64
SURVEY NO. 20-76

ATTENTION

THIS MAP MUST BE KEPT UNDER REVISION

DUANE GRIFFITH L.S.

SIGNATURE

SURVEY NO. 9-83

Lang Langley
Union County Surveyor
DEPUTY
3-3-83




BASIS OF BEARING

FORWARD BEARING AS PUBLISHED BY U.S.C. & G.S.
FROM \triangle VALLEY TO \triangle COLLEGE

REGISTERED
PROFESSIONAL
LAND SURVEYOR

Duane I. Griffith
OREGON
JULY 29, 1964
DUANE I. GRIFFITH
644

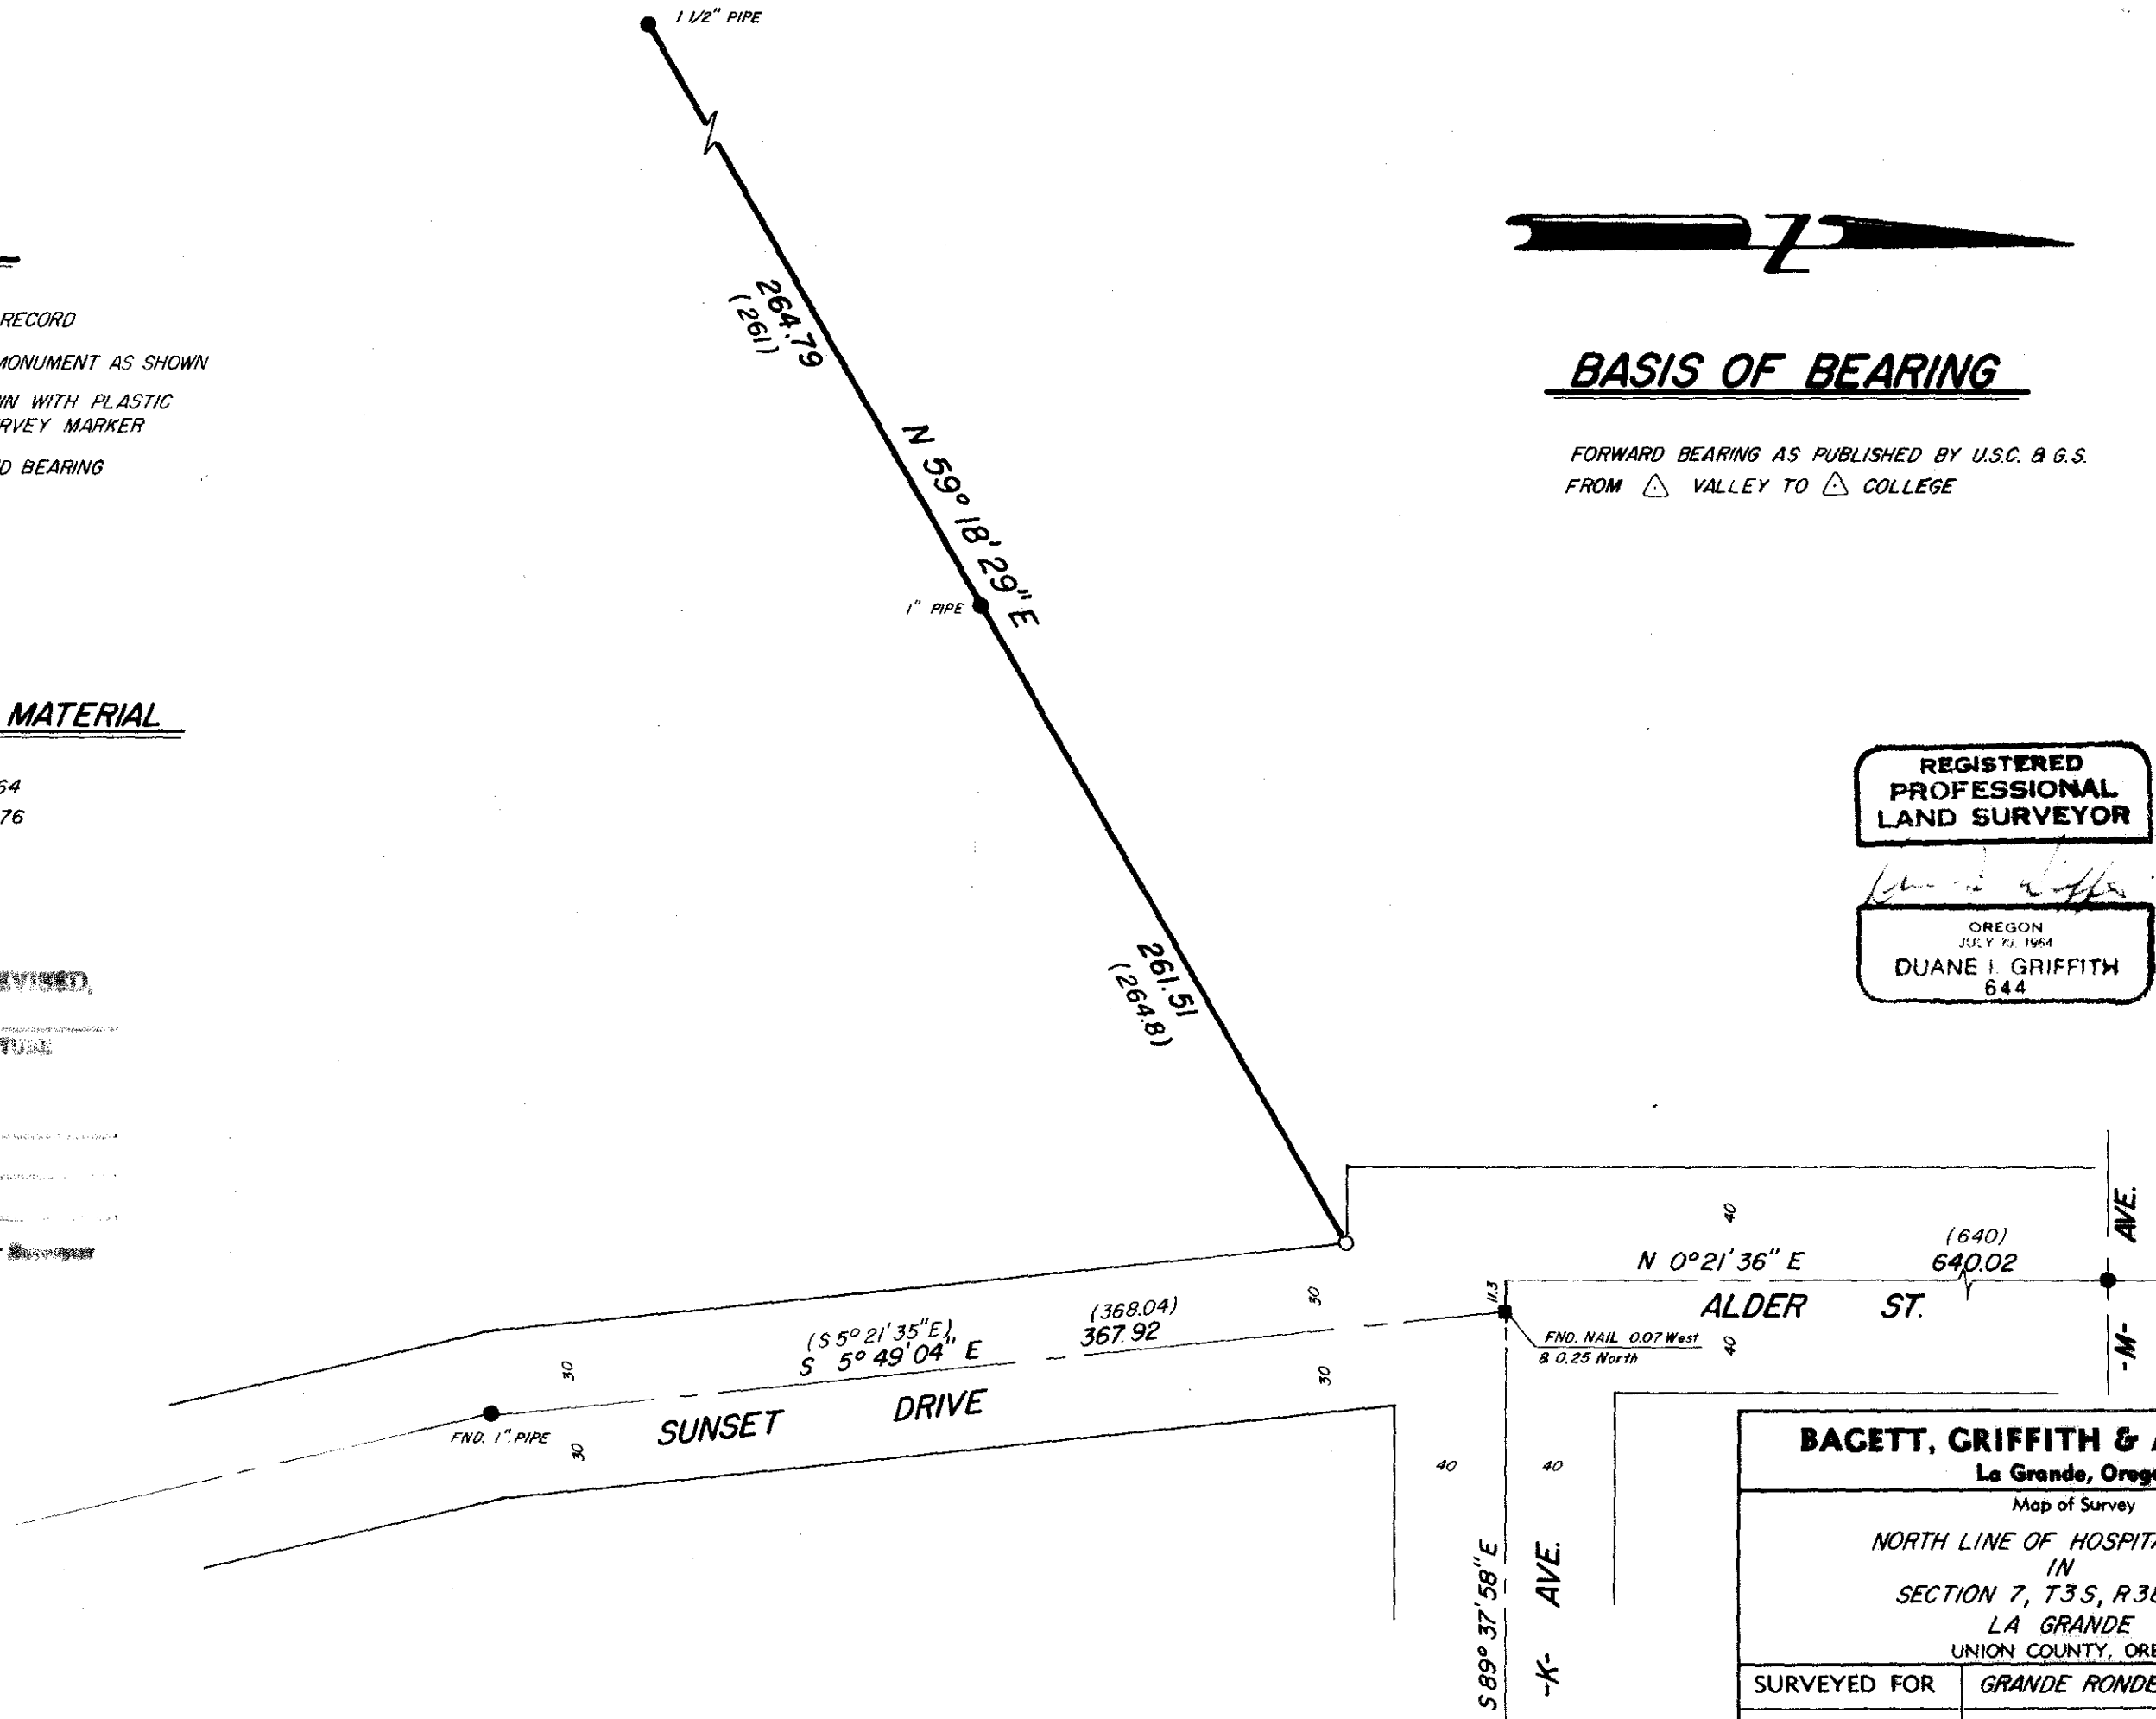

BAGETT, GRIFFITH & ASSOCIATES La Grande, Oregon		
Map of Survey NORTH LINE OF HOSPITAL PROPERTY IN SECTION 7, T3S, R38 E, W.M. LA GRANDE UNION COUNTY, OREGON		
SURVEYED FOR	GRANDE RONDE HOSPITAL	
SURVEYED BY	dig	3/79
Scale: 1" = 60'	Drawn by: RGR	3/79