


BASIS OF BEARING

FORWARD BEARING AS PUBLISHED BY U.S.C. & G.S.
FROM \triangle COLLEGE TO \triangle VALLEY

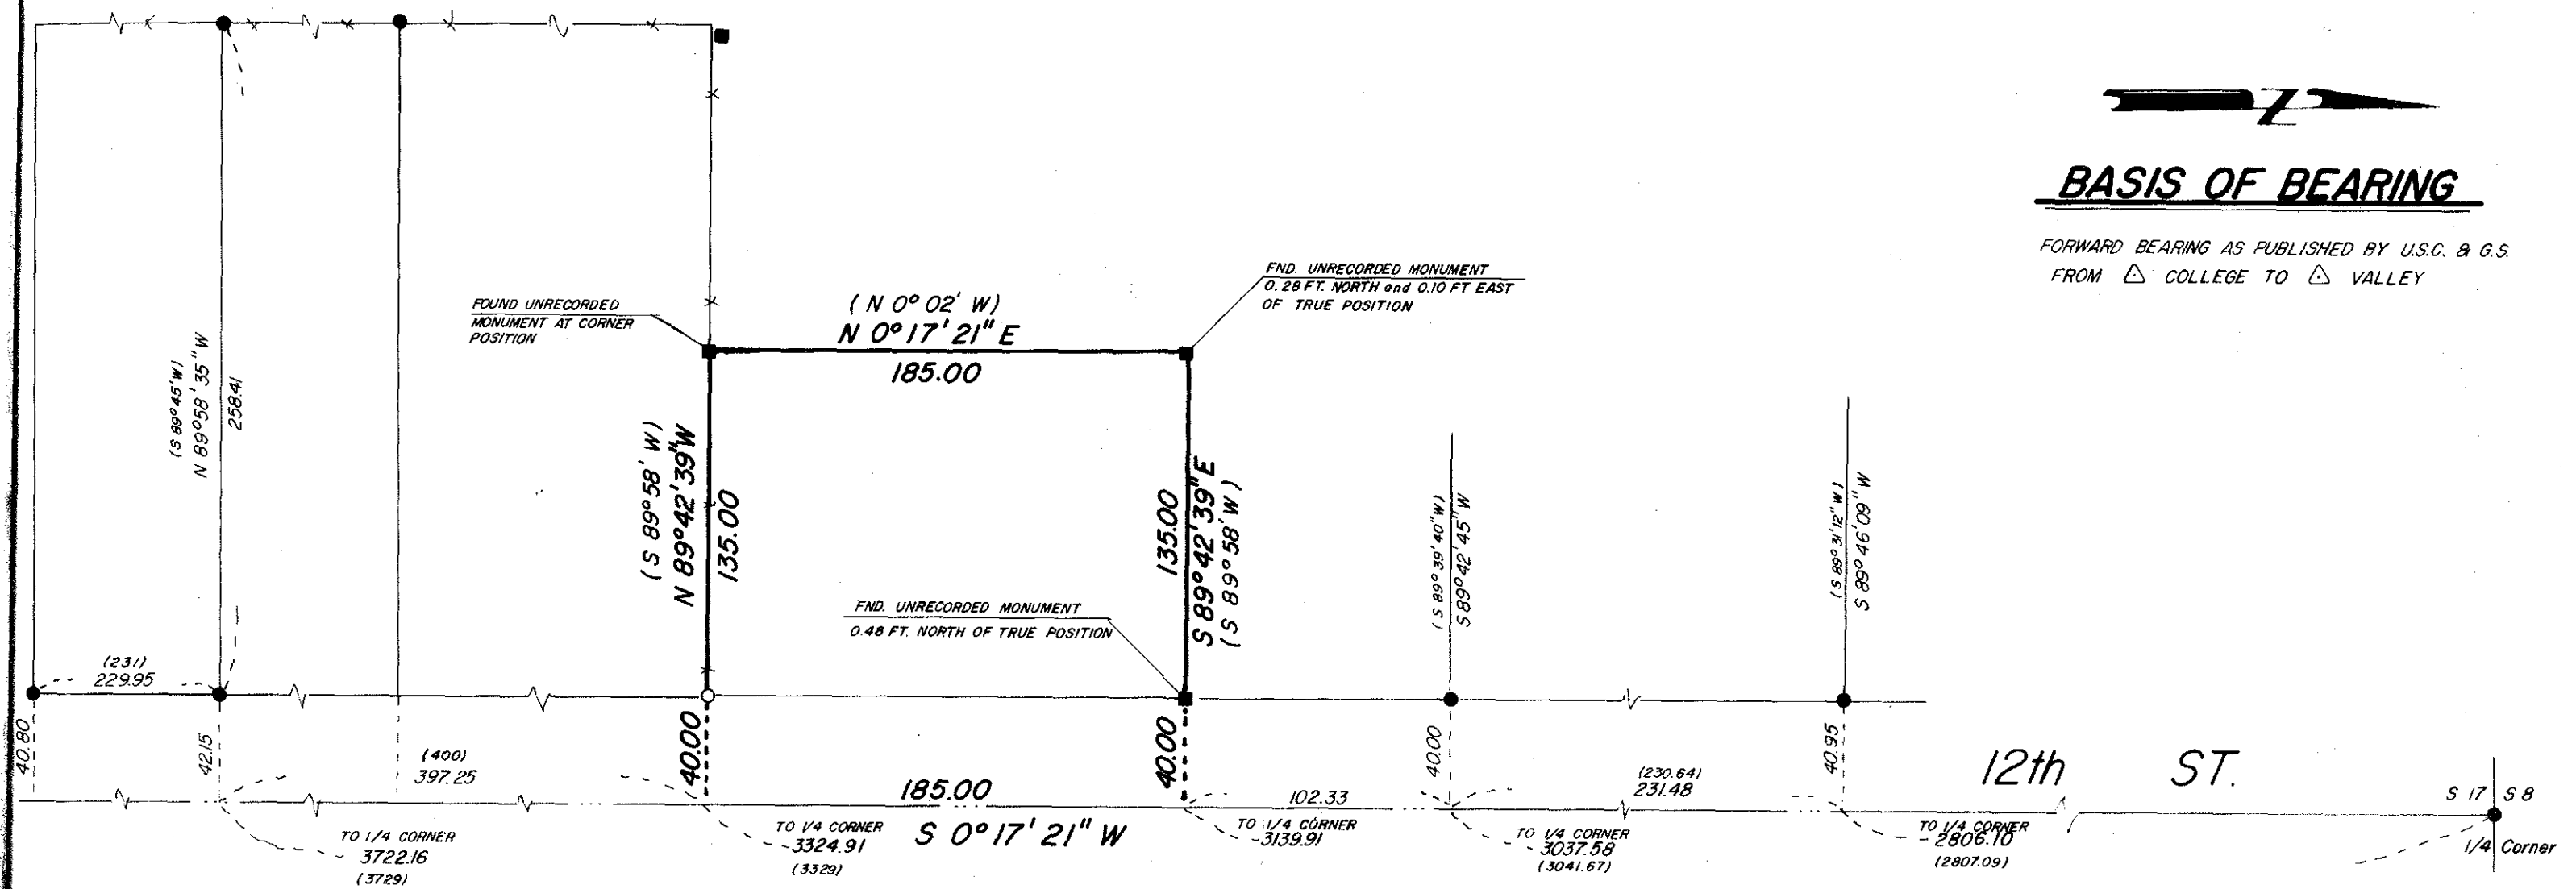

REFERENCE MATERIAL

SURVEY NUMBERS

15-65
12-69
22-71
6-73
34-74
26-75

DEED DESCRIPTIONS

MICROFILM NUMBERS

28374
36287
50370
61793
65111
68266
75345

LEGEND

- FOUND MONUMENT OF RECORD
- FOUND UNRECORDED MONUMENT
- SET 5/8" x 30" IRON PIN WITH PLASTIC CAP MARKED B-G-A SURVEY MARKER
- () RECORD BEARING AND DISTANCE
- EXISTING FENCELINE
- CENTERLINE OF SECTION 17 AS PER SURVEYS OF RECORD

JOHN COLLINS
 PLATONIAN
 SURVEYOR

BAGETT, GRIFFITH & ASSOCIATES

La Grande, Oregon

Map of Survey

PARCEL IN THE SW 1/4
OF SECTION 17

T3S, R38E, W.M.

UNION COUNTY, OREGON

SURVEYED FOR	JOHN COLLINS	
SURVEYED BY	dig	3/79
Scale: 1" = 60'	Drawn by: RGR	3/79