



BASIS OF BEARING


SURVEY NO. 124-78

LEGEND

- FOUND MONUMENT OF RECORD
- FOUND 1/2" SQUARE REBAR—UNRECORDED
- SET 5/8" x 30" IRON PIN WITH PLASTIC CAP MARKED B.G.A. SURVEY MARKER
- () RECORD BEARING AND DISTANCE
- * * * * * EXISTING FENCELINE

REFERENCE MATERIAL

SURVEY NO. 11-66
 SURVEY NO. 94-71
 SURVEY NO. 124-78

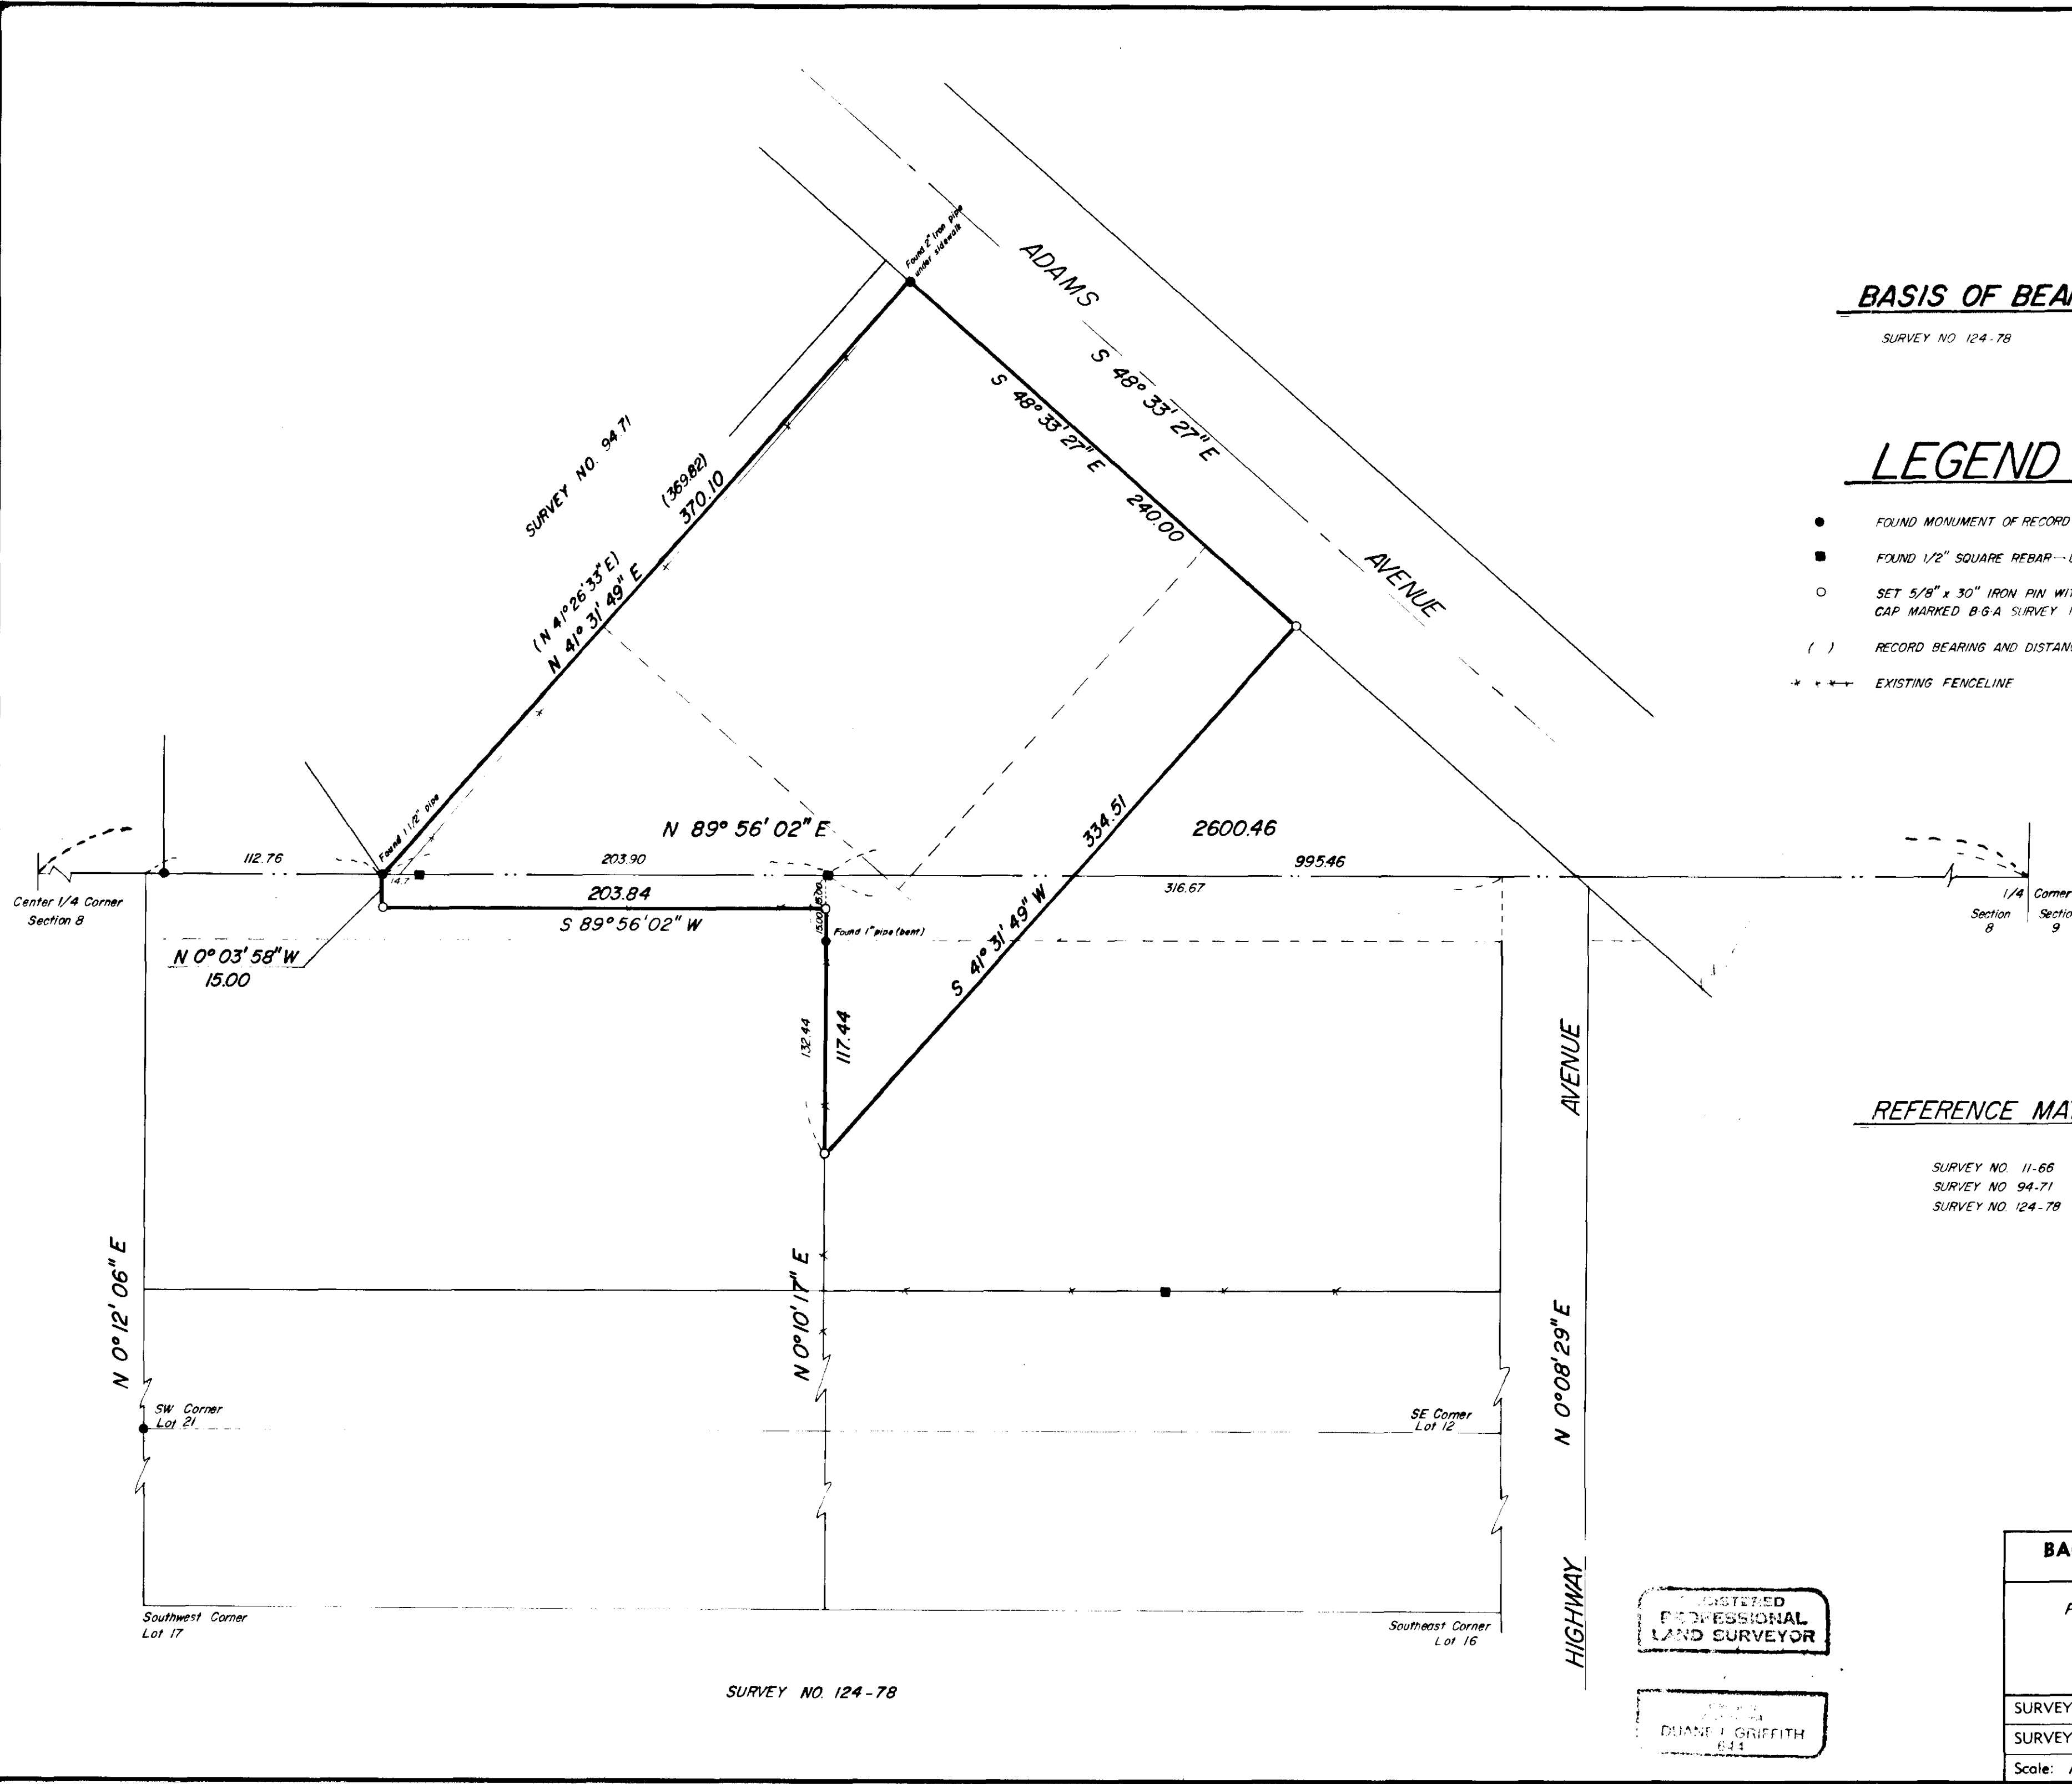

REGISTERED
 PROFESSIONAL
 LAND SURVEYOR

DUANE J. GRIFFITH
 611

BAGETT, GRIFFITH & ASSOCIATES La Grande, Oregon		
Map of Survey PARCEL IN LOTS 1, 2, & 8 OF BLOCK 15 HONAN'S ADDITION AND IN LOTS 10 & 29 OF HIGHWAY ACRES LA GRANDE UNION COUNTY, OREGON		
SURVEYED FOR	JAY LOUDERMILK	
SURVEYED BY	dig	3/79
Scale: 1" = 50'	Drawn by: RGR	3/79