

SURVEY SHOWS LOT SIZE AFTER RE-DEDICATION OF A PART OF EACH LOT TO THE CITY.

LEGEND

- 2 1/2" x 30" GALVANIZED PIPE W/ MARKED BRASS CAP SET BY PRIOR SURVEYS.
- CORNER SET BY SURVEY. 2 1/2" x 30" GALVANIZED PIPE W/ MARKED BRASS CAP.
- 3/8" x 30" REBAR SET TO MARK LOT CORNERS CORNERS AFTER RE-DEDICATION.
- ③ LOT NUMBERS

BASIS OF BEARING

POLARIS OBSERVATION AT EASTERN ELONGATION 8-10-77.

REFERENCE MATERIAL

ORIGINAL PLAT OF NORTH POWDER. SURVEY 65-77 & 129-78.

KNOW ALL MEN BY THESE PRESENTS : That we Terry L. McQuisten and Samuel E. Orr, being the fee owners of block 43, of the City of North Powder, Union County Oregon, do hereby dedicate to the City of North Powder for public use the following strips of land. The south 7.5 feet of lots 1-8 and the north 7.5 feet of lots 9-16, BLOCK 43, NORTH POWDER, OREGON. This survey shows lots sizes and alley width resulting from this dedication


Terry L. McQuisten
TERRY L. MCQUISTEN

Samuel E. Orr
SAMUEL E. ORR

STATE OF OREGON }
COUNTY OF UNION } SS

BE IT REMEMBERED, that on June 21 1979, before me did personally appear the within named Terry L. McQuisten and Samuel E. Orr and acknowledged to me that they executed the same freely and voluntarily

Alene Willis
NOTARY PUBLIC FOR OREGON
My Commission expires Sept. 10-80

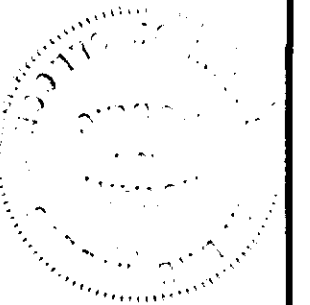


ACCEPTANCE

Approved by the City Council of North Powder this 4th day of June, 1979

ACCEPTED BY:

James Brockway
JAMES BROCKWAY
MAYOR, CITY OF NORTH POWDER
JUNE 4, 1979

Janet L. Jordan
JANET JORDAN
RECORDER
JUNE 4, 1979

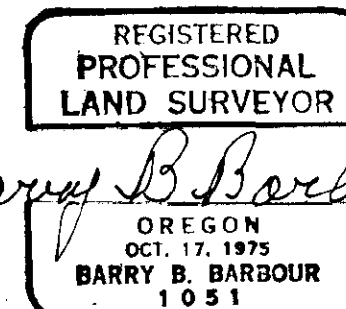

Barry B. Barbour

DEPENDENT RESURVEY BLOCK 43 OF THE CITY OF NORTH POWDER UNION COUNTY, OREGON		
FOR TERRY MCQUISTEN & SAMUEL ORR		
SCALE 1" = 100'	BARRY B. BARBOUR LAND SURVEYOR	SHEET NO. 1 / 1
DATE JUNE, 1979		

51-79