TOWNSHIP 3 SOUTH, RANGE 33 EAST, W. M. UNION COUNTY, OREGON

TOWNSHIP 2 SOUTH, RANGE 33 EAST, W. M. UNION COUNTY, OREGON

TOWNSHIP 3 SOUTH, RANGE 33 1/2 EAST, W. M. UNION COUNTY, OREGON

DEPENDENT RESURVEY & CORNER MONUMENTATION FROM EXISTING EVIDENCE

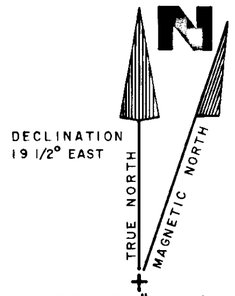

SCALE 4" = 1 Mile

BASIS of BEARINGS for CORNERS ESTABLISHED by TRAVERSE SURVEY: SOLAR OBSERVATION

SURVEYORS CERTIFICATION:

I, WILLIAM R. WELLS, A REGISTERED PROFESSIONAL LAND SURVEYOR IN THE STATE OF OREGON, HEREBY CERTIFY THAT THIS PLAT AND NOTES HEREON, OR ATTACHED, ARE A CORRECT REPRESENTATION OF A SURVEY PERFORMED UNDER MY DIRECT SUPERVISION DURING THE MONTHS OF JUNE AND JULY 1979 FOR THE U. S. FOREST SERVICE, IN ACCORDANCE WITH THE STATUTES OF THE STATE OF OREGON AND WITH THE ARTICLES OF THE CONTRACT.

William R. Wells 7-30-79

WILLIAM R. WELLS, P. L. S.

OREGON LICENSE No. 1106

REGISTERED PROFESSIONAL LAND SURVEYOR

William R. Wells

OREGON JULY 22, 1977 WILLIAM R. WELLS 1106

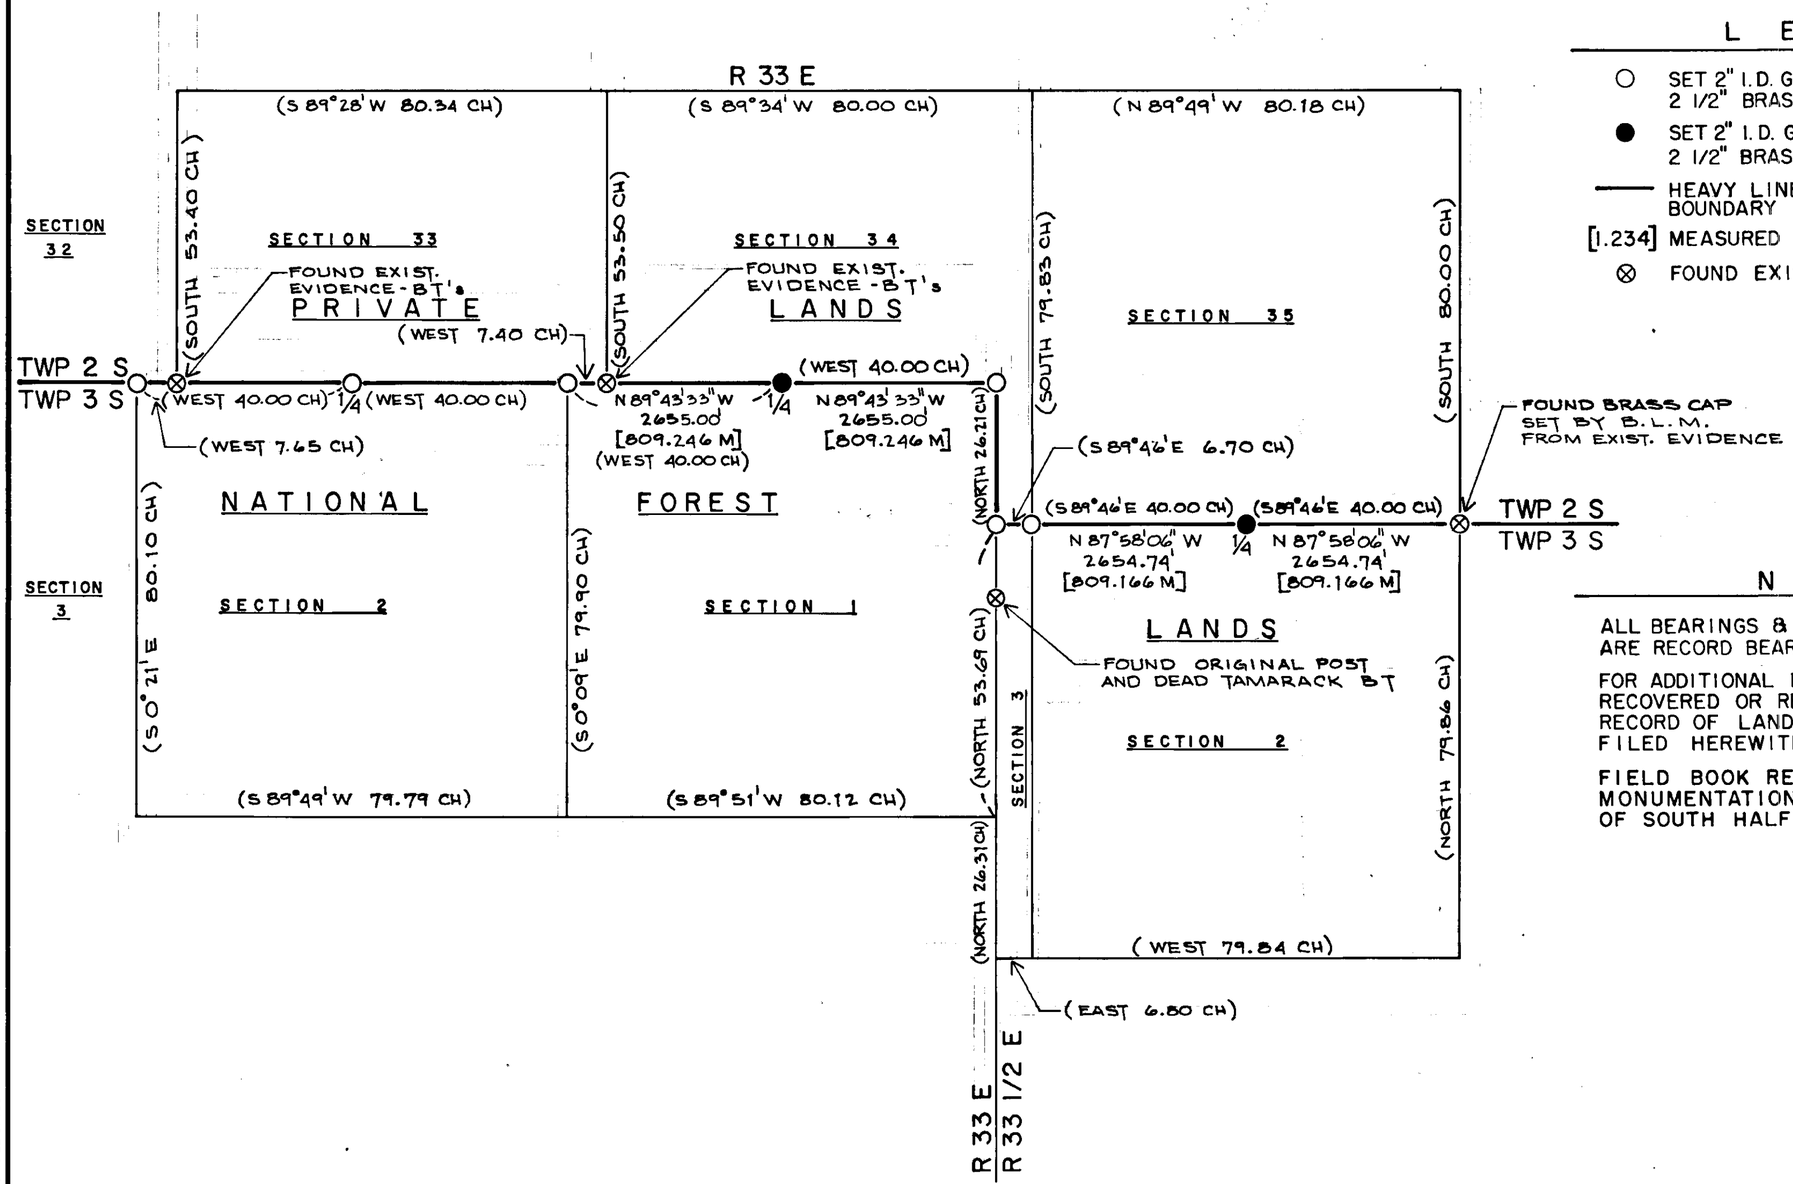

L E G E N D

- ○ SET 2" I.D. GALV. IRON PIPE 30" LONG WITH 2 1/2" BRASS CAP FROM EXISTING EVIDENCE
- ● SET 2" I.D. GALV. IRON PIPE 30" LONG WITH 2 1/2" BRASS CAP BY TRAVERSE SURVEY
- —— HEAVY LINES INDICATE U. S. FOREST BOUNDARY
- [1.234] MEASURED DISTANCE IN METERS
- ⊗ FOUND EXISTING EVIDENCE AS NOTED

N O T E S

ALL BEARINGS & DISTANCES IN PARENTHESIS ARE RECORD BEARINGS AND DISTANCES

FOR ADDITIONAL INFORMATION ON CORNERS RECOVERED OR RE-ESTABLISHED, SEE CERTIFIED RECORD OF LAND CORNER MONUMENTATION FILED HEREWITH.

FIELD BOOK REFERENCE - TRAVERSE AND MONUMENTATION BOOK(S) 1 OF SOUTH HALF '79 CADASTRAL SURVEY

WALLULIS PROJECT NO: 79-111

AGENCY PROJECT NO: U. S. F. S. CONTRACT NO. 53-04H1-9-7409N

PROJECT: SOUTH HALF '79 CADASTRAL SURVEY

PERFORMED FOR U. S. FOREST SERVICE UMATILLA NATIONAL FOREST

SCALE: 4" = 1 Mile

DATE: JULY 25, 1979

DES BY:

DR BY: C.A.A.

CK BY: W.R.W.

TITLE: UNION COUNTY, OR
- TOWNSHIP 3 SOUTH, RANGE 33 EAST, W. M.
- TOWNSHIP 2 SOUTH, RANGE 33 EAST, W. M.
- TOWNSHIP 3 SOUTH, RANGE 33 1/2 EAST, W. M.

REVISIONS

DRAWING:

SHEET 1 OF 1

56-79

BRUNING 40 22 37139