


R D CONSTRUCTION  
 RT 3 BOX 3429  
 LA GRANDE, OREGON  
 OCTOBER 15, 1979

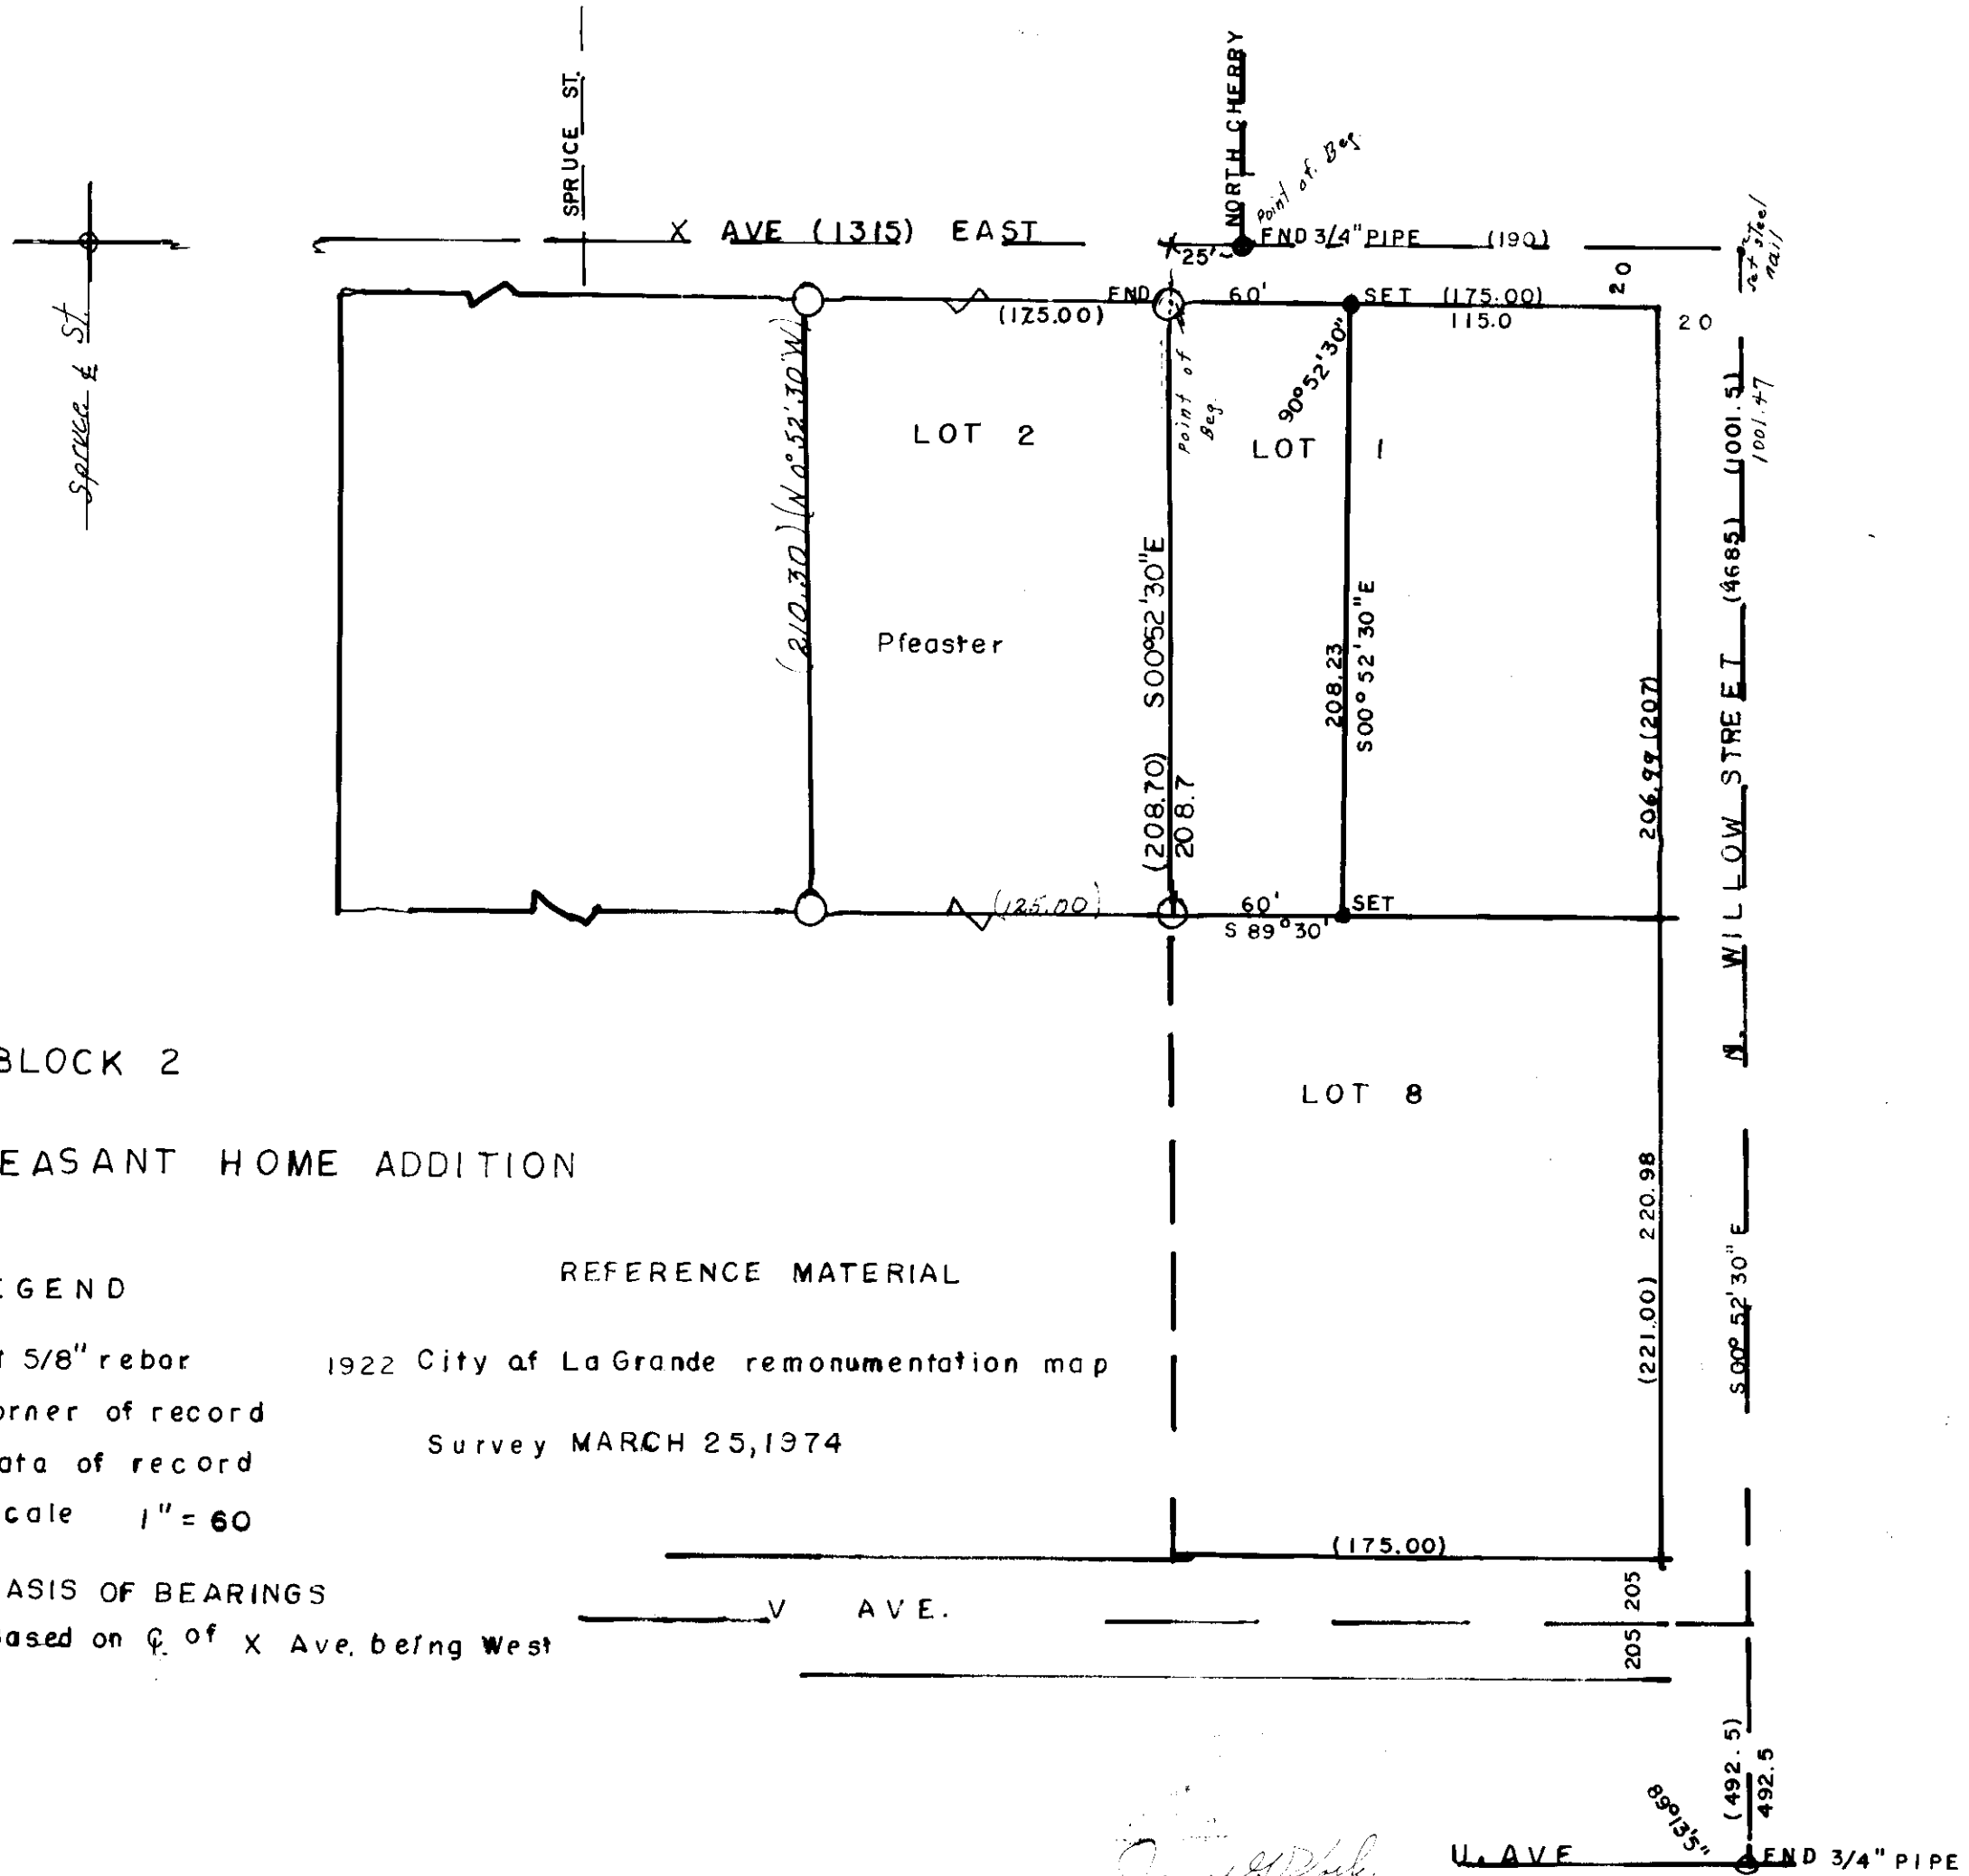

BLOCK 2  
 PLEASANT HOME ADDITION

LEGEND  
 • Set 5/8" rebar  
 ○ Corner of record  
 ( ) Data of record  
 Scale 1" = 60'

REFERENCE MATERIAL  
 1922 City of La Grande remonumentation map  
 Survey MARCH 25, 1974

BASIS OF BEARINGS  
 Based on  $\phi$  of X Ave. being West

*James D. White*  
 Surveyor

81-79