

R D CONSTRUCTION

RT 3 BOX 3429

LA GRANDE, OREGON

SEPTEMBER 21, 1979

LEGEND

• SET 5/8 REBAR ON CORNER

o CORNER OF RECORD

() DATA OF RECORD

SCALE 1" = 40'


BASIS OF BEARING

REFERENCE SURVEY

67-77 A 10/76

DIVISION

(388.00)  
(N 89° 31' 49" E)

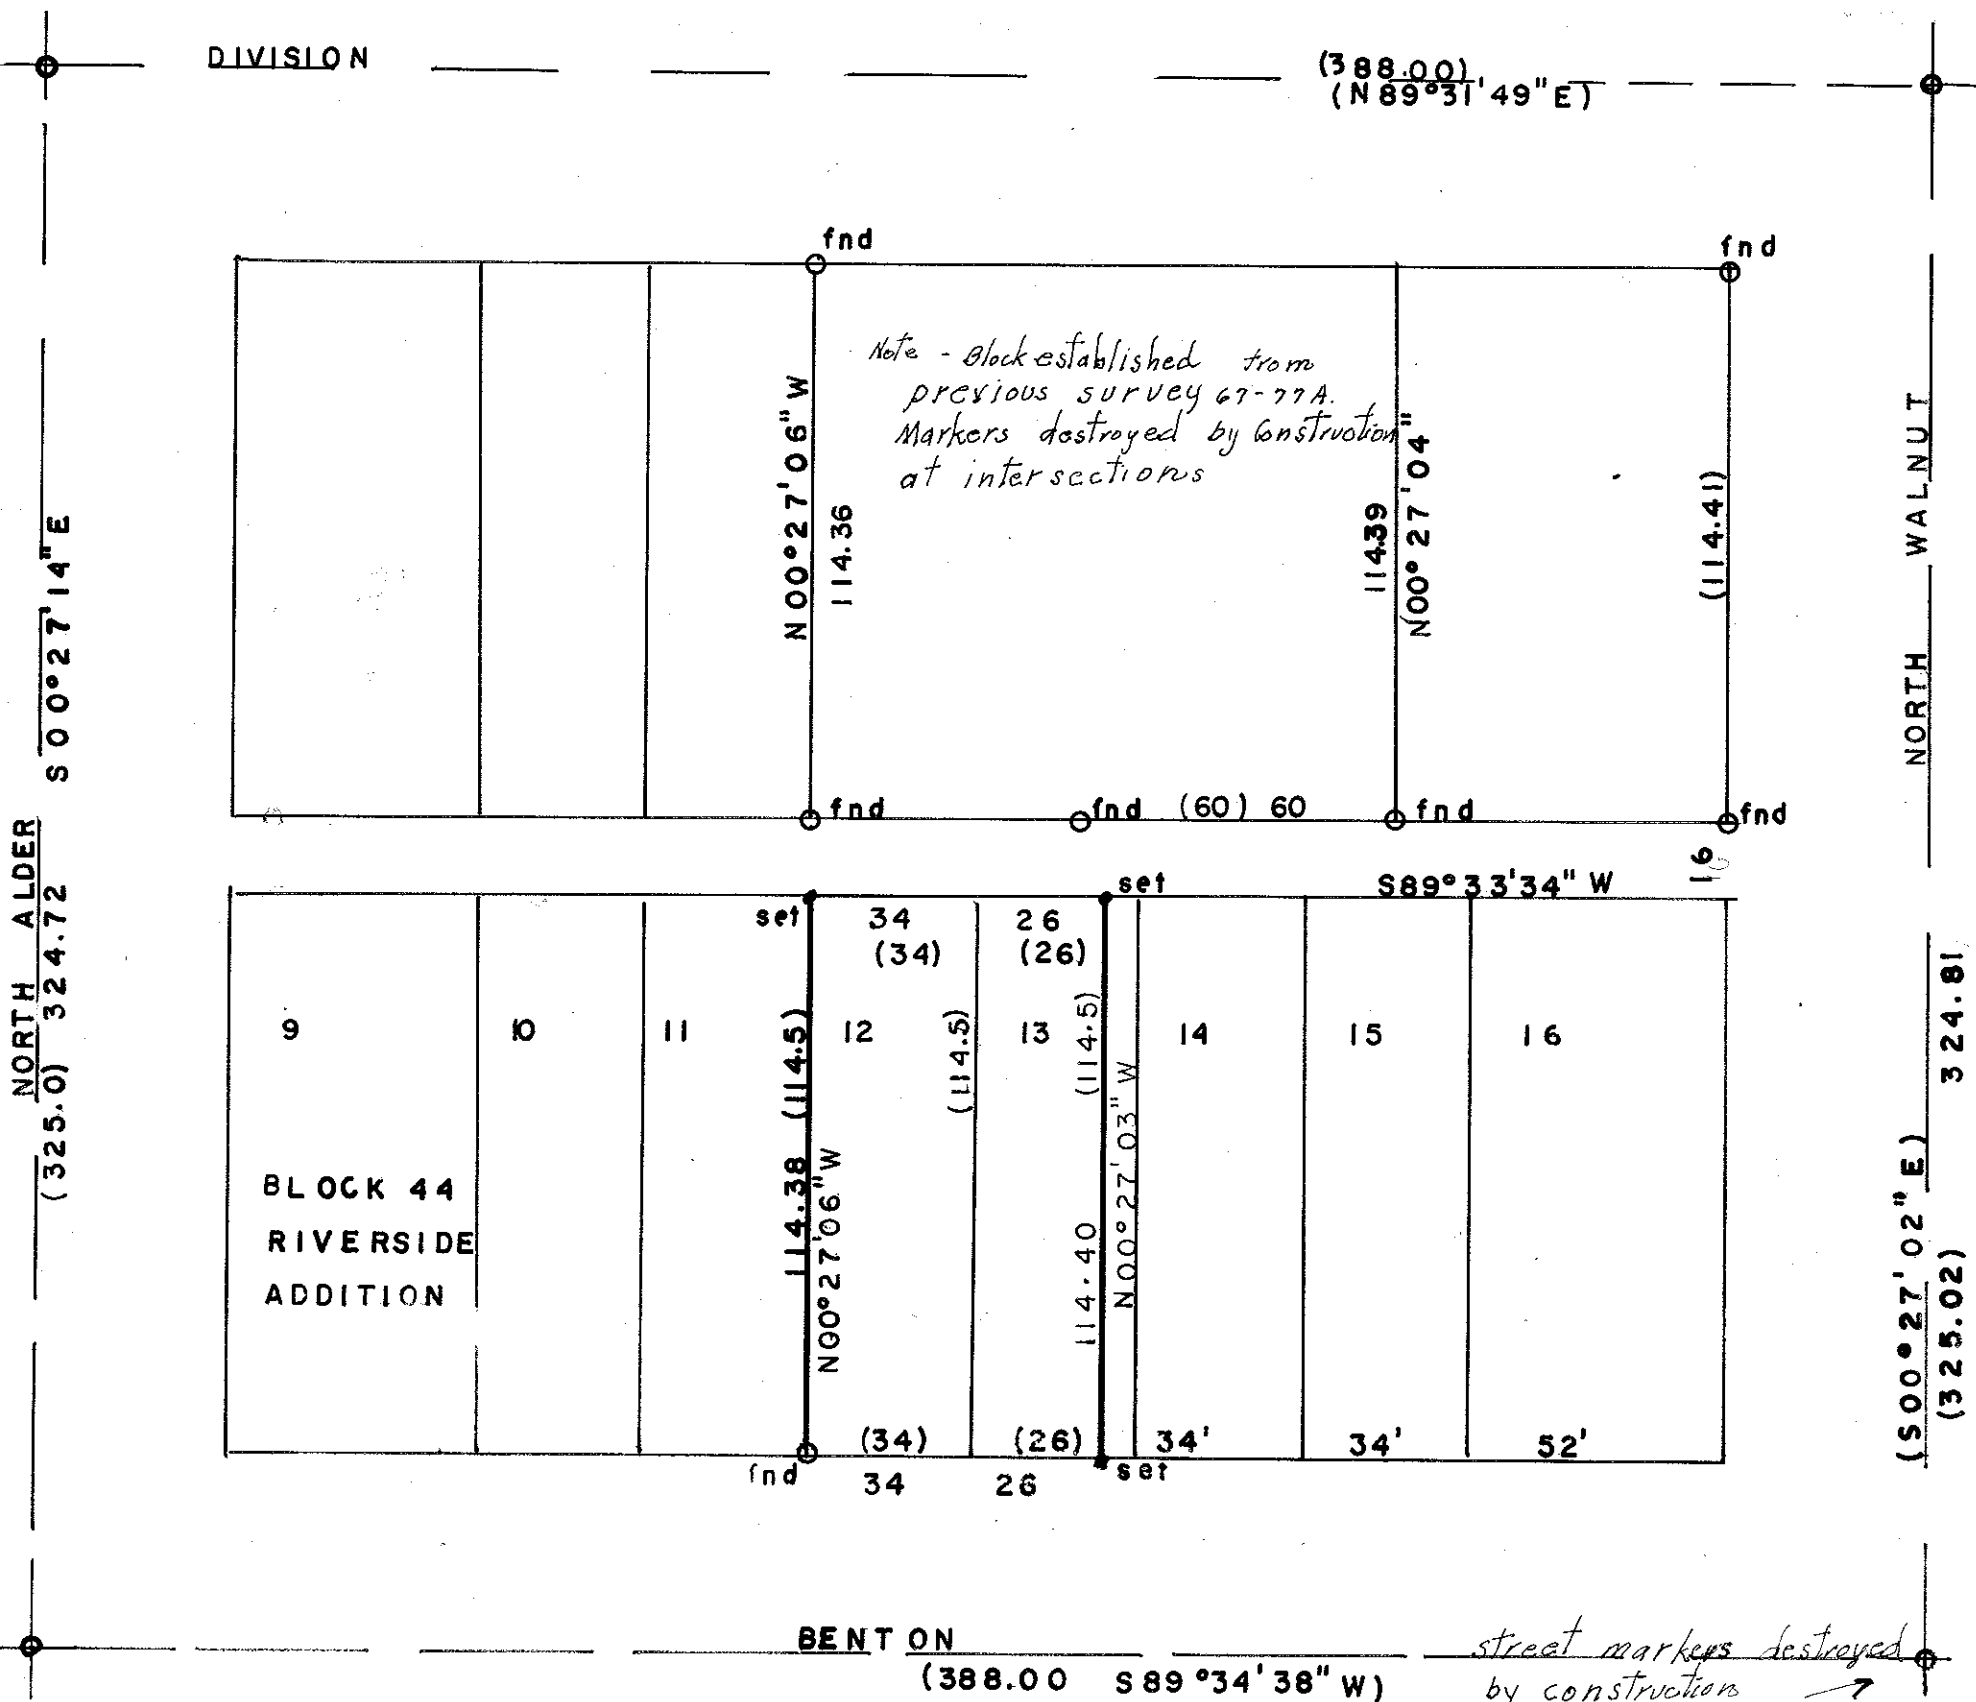

NORTH ALDER  
(325.0) 324.72

NORTH WALNUT  
(500° 27' 02" E)  
(325.02) 324.81

BENT ON  
(388.00 S 89° 34' 38" W)

street markers destroyed  
by construction →

REGISTERED  
PROFESSIONAL  
LAND SURVEYOR  
*James G. Voeltz*  
OREGON  
MAY 4, 1956  
JAMES G. VOELTZ  
SRS

82-79