

WILEY M & WILMA NEBEKER

RT 1, BOX 1517

La Grande, Oregon

Legend

scale 1" = 200'

() data of record


Sept 11, 1979

o corners fnd

• set 5/8" rods

basis of bearing
south line of S9

(N89°54'W)

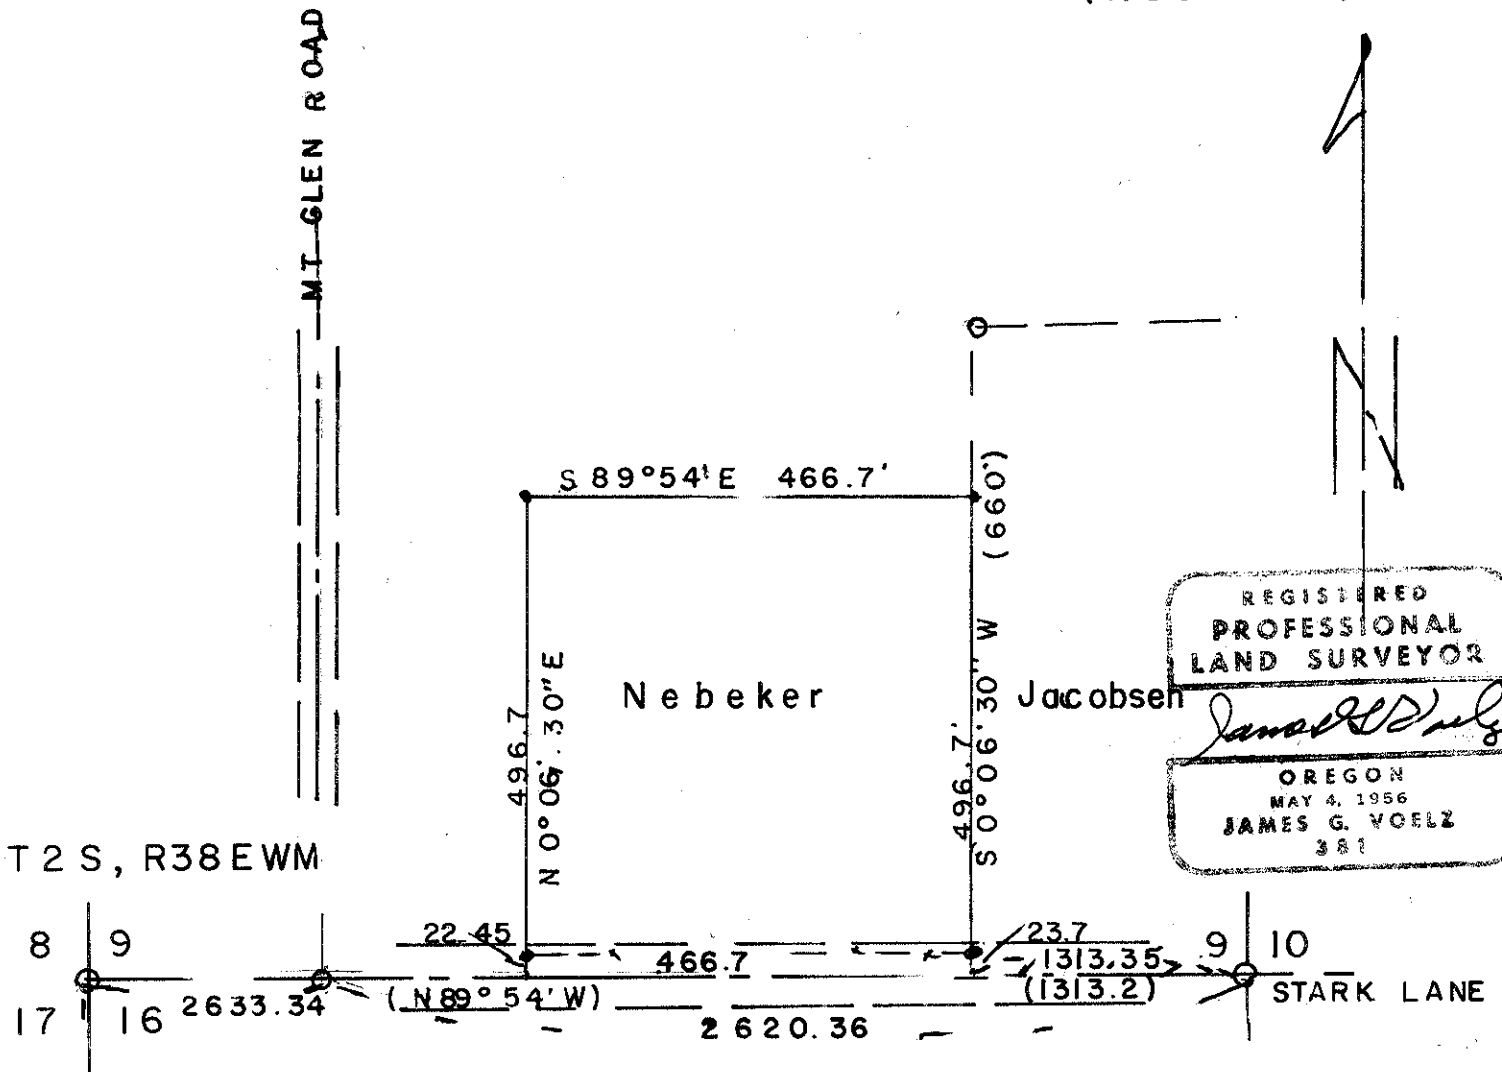

85-79