


BOB KOTTER  
 NORTH POWDER, OREGON

Date Aug. 26, 1979

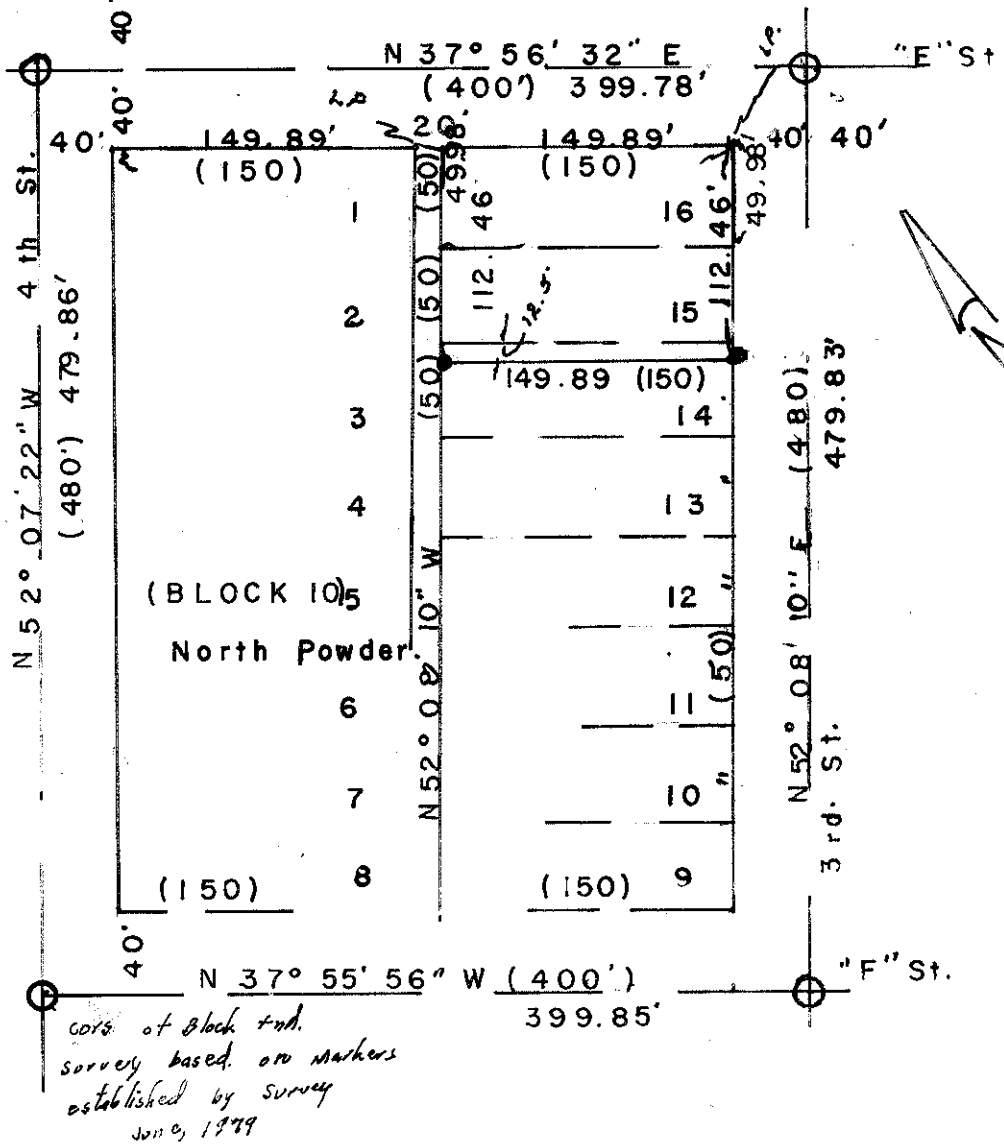

**LEGEND**  
 ( ) data of record  
 ○ fnd Brass caps  
 ● set 5/8" rods  
 -LP set lead plug & brass screw  
 Scale 1" = 100'

Basis of bearing:  
 Survey of Block 10: "E" St = N37° 56' 32" E; June 1979

REGISTERED  
 PROFESSIONAL  
 LAND SURVEYOR

*James G. Voyle*  
 MAY 4, 1966  
 JAMES G. VOYLE  
 281

86-79