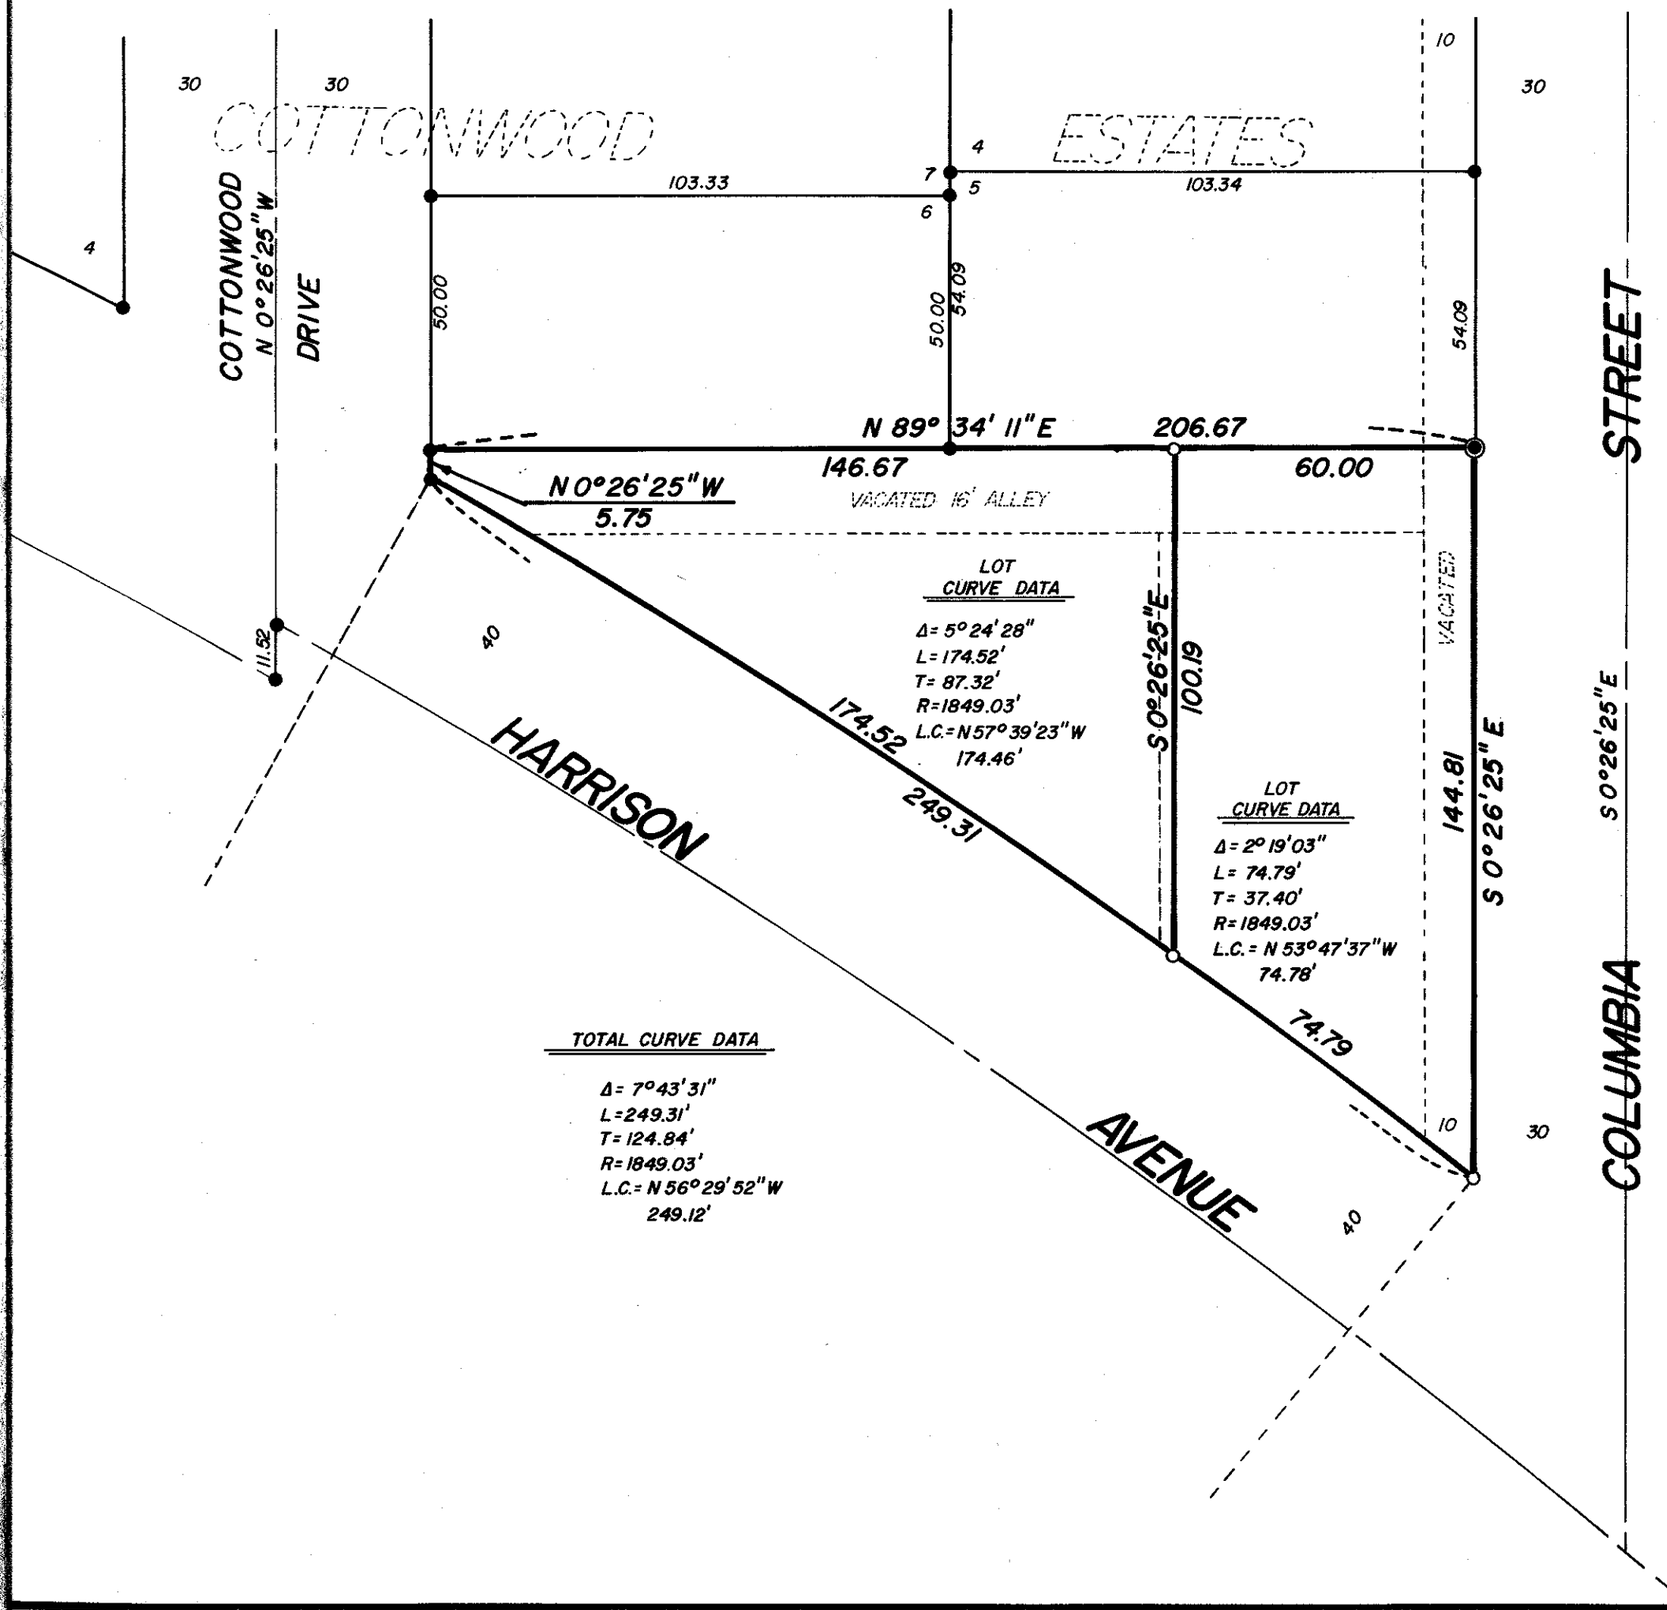

BASIS OF BEARING

FORWARD BEARING AS PUBLISHED BY U.S.C. & G.S.
FROM △ COLLEGE TO △ VALLEY

REFERENCE MATERIAL

1922 REMONUMENTATION OF LA GRANDE
U.P.R.R. RIGHT OF WAY MAP NO. 80710
PLAT OF RIVERSIDE ADDITION
PLAT OF COTTONWOOD ESTATES
SURVEY NO. 57-75

LEGEND

- ● FOUND MONUMENT OF RECORD
- ◉ INITIAL POINT OF COTTONWOOD ESTATES
- ○ SET 5/8" x 30" IRON PIN WITH PLASTIC CAP MARKED B·G·A SURVEY MARKER
- ——— CENTERLINE OF ROAD

REGISTERED PROFESSIONAL LAND SURVEYOR
Gregory T. Blackman
OREGON
JULY 13, 1973
GREGORY T. BLACKMAN
991

BAGETT, GRIFFITH & ASSOCIATES
La Grande, Oregon

Map of Survey
LOTS 9 & 10 AND THE VACATED ALLEY OF BLOCK 73, RIVERSIDE ADDITION AND THE VACATED WEST 10' OF COLUMBIA STREET
LA GRANDE
UNION COUNTY, OREGON

SURVEYED FOR	LARRY SWEET	
SURVEYED BY	GTB	1/80
Scale: 1"=30'	Drawn by: RGR	1/80