


NOTE: R6-7100-57 FILED UNION COUNTY SURVEYOR'S FOR STANDARD INDEX FILE NUMBER A-7, A-9, B-7, B-8, C-4, C-8, C-9, D-4, D-5, E-5, E-7 AND E-9

I, BARRY B. BARBOUR, a registered land surveyor in the State of Oregon, hereby certify that this plat and the notes hereon, or attached, are a correct representation of a survey I performed during May - June, 1980 for Crown Zellerbach Corporation in accordance with the Statutes of the State of Oregon.

*Barry B. Barbour*  
 BARRY B. BARBOUR  
 REGISTERED LAND SURVEYOR  
 OREGON LICENSE 1051

SECTIONS 5 & 6

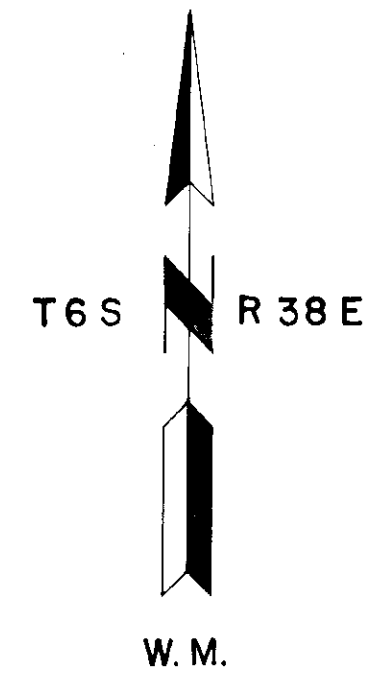

BASIS OF BEARING

SOLAR OBSERVATION  
 AUGUST 7, 1979

LEGEND

- BRASS CAP MONUMENT SET IN 1979.
- BRASS CAP MONUMENTS SET FROM ORIGINAL CORNER EVIDENCE.
- ⊕ BRASS CAP MONUMENTS SET BY SURVEY.
- 1" x 3/8" GALVANIZED PIPE AND CROWN ZELLERBACH BRASS CAP MONUMENTS SET BY SURVEY.
- POSTED BOUNDARY LINE.
- ( ) G.L.O. RECORD DATA.
- ⑤ SECTION NUMBERS

REFERENCE MATERIAL

ORIGINAL G.L.O. NOTES AND PLATS.  
 SURVEY # 95-79.  
 FIELD BOOKS 1 & 2.

MEAN MAGNETIC DECLINATION

N 20° 00' E

REGISTERED  
 PROFESSIONAL  
 LAND SURVEYOR

*Barry B. Barbour*  
 OREGON  
 OCT 17 1975  
 BARRY B. BARBOUR  
 1051

SECTIONS 5 & 6, T6S, R 38E, W. M.		
UNION COUNTY,		OREGON
FOR: CROWN ZELLERBACH CORPORATION		
SCALE 1" = 1000'	BARRY B. BARBOUR PROFESSIONAL LAND SURVEYOR	1 of 1
DATE JUNE, 1980		