

NOTES:

Bearings are based on observations with a Wild GA4-1 North seeking Gyro. All bearings and distances are true.

All field notes on traverses for Sections 3 and 4 are in Books 1 and 2. Notes used to set Brass Caps are in Book 2, pages 349-380. Accessory ties for all corners set are described in Certified Record of Land Monumentation.

All found corners are part of a closed traverse. Computations for all corners set are based on the Manual of Surveying Instruction 1973, Chapter 5.

All lines plotted were performed by the Offset Method from the traverse lines.

LEGAL DESCRIPTIONS


Section 3
 U.S. Forest Service ownership, all of Section 3, excepting the west half of the Northeast one-quarter and the Northeast one-quarter of the Northwest one-quarter of Section 3, Township 1 North, Range 38 East of the Willamette Meridian.

Section 4
 U.S. Forest Service ownership, all of Section 4, excepting the South half of the Southwest one-quarter of Section 4, Township 1 North, Range 38 East of the Willamette Meridian.

I, James H. Buisman, a registered land surveyor in the State of Oregon, hereby certify that this plat and the notes hereon are a correct representation of a survey I performed during September 1979 thru August 1980, for the U.S. Forest Service in accordance with the statutes of the State of Oregon and with the Articles of my contract.

(S) James H. Buisman
 Registered Land Surveyor
 Oregon License No. 1097

- denotes Brass Cap set by proportionate method
- denotes Brass Cap found or set from existing evidence
- () denotes G.L.D. record bearing and distance
- denotes Forest Service Boundary and Dotted line

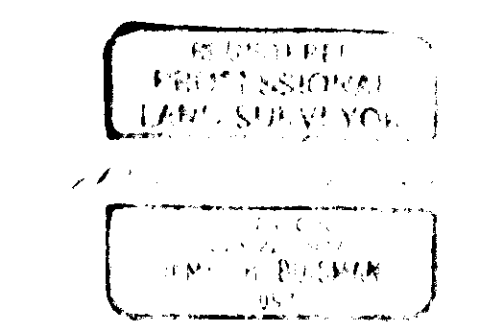

KRUMBEIN ENGINEERING CO. ENGINEERS - SURVEYORS - PLANNERS 221 S. Main, Pendleton, Oregon	SCALE	1" = 200'
	DATE	JULY 22, 1980
	DRN BY	MB
	CKD BY	JHB
Survey for U.S. FOREST SERVICE Sections 3 & 4, T.1N., R.38E., W.M.		DRAWING NO. 80-200

59-80