

NOTES

Bearings are based on observations with a Wild GAK-1 North seeking Gyro. All bearings and distances are true.
 All field notes on traverses for Sections 28, 33, and 34, are in Books 1 and 4. Notes used to set Brass Caps are in Book 4, pages 347-369. Accessory ties for all corners set are described in Certified Record of Land Monumentation.
 All found corners are part of a closed traverse. Computations for all corners set are based on the Manual of Surveying Instruction 1973, Chapter 5.

LEGAL DESCRIPTIONS

Section 28
 U.S. Forest Service ownership; all of Section 28, excepting the Southwest one-quarter of the Northeast one-quarter, the Northwest one-quarter of the Southeast one-quarter, the South half of the Southeast one-quarter, the East half of the Northwest one-quarter, and the Northeast one-quarter of the Southwest one-quarter of Section 28, Township 2 North, Range 38 East of the Willamette Meridian.


Section 33
 U.S. Forest Service ownership; all of Section 33, excepting the North half of the Northeast one-quarter, the Southeast one-quarter of the Northeast one-quarter, and the East half of the Southeast one-quarter of Section 33, Township 2 North, Range 38 East of the Willamette Meridian.

Section 34
 U.S. Forest Service ownership; all of Section 34, excepting the West half of the Northwest one-quarter, the Northwest one-quarter of the Southwest one-quarter, and the South half of the Southwest one-quarter of Section 34, Township 2 North, Range 38 East of the Willamette Meridian.

I, James H. Buismann, a registered land surveyor in the state of Oregon, hereby certify that this Plat and the notes hereon, are a correct representation of a survey I performed during September 1979 thru October 1980, for the U.S. Forest Service in accordance with the statutes of the state of Oregon and with the Articles of my contract.

James H. Buismann (S) James H. Buismann
 Registered Land Surveyor
 Oregon License No. 1097

- ⊙ denotes Brass Cap found or set from existing evidence
- denotes Brass Cap set by proportionate method
- 000000m denotes distance in meters
- () denotes G.L.O. record bearing or distance
- denotes U.S. Forest Service Boundary

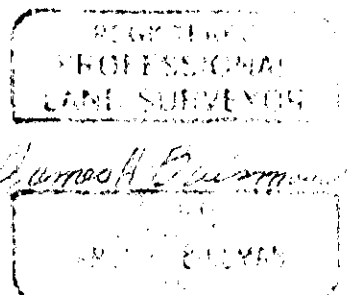

NOTE
 Corners on the Township line are portions of this job, see Krumbain Engineering, Ltd. drawing no. 80-32D.

K	KRUMBEIN ENGINEERING CO ENGINEERS - SURVEYORS - PLANNERS 221 S. Main, Pendleton, Oregon	SCALE 1" = 1000'
	Control Survey for U.S. FOREST SERVICE Sections 28, 33, & 34, T2N, R36E, W.M.	DATE October 14, 1980
	DRN BY M.M.	CKD BY J.H.B.
	DRNG NO. 80-40C	JOB NO. 79-204

0848