
Ø

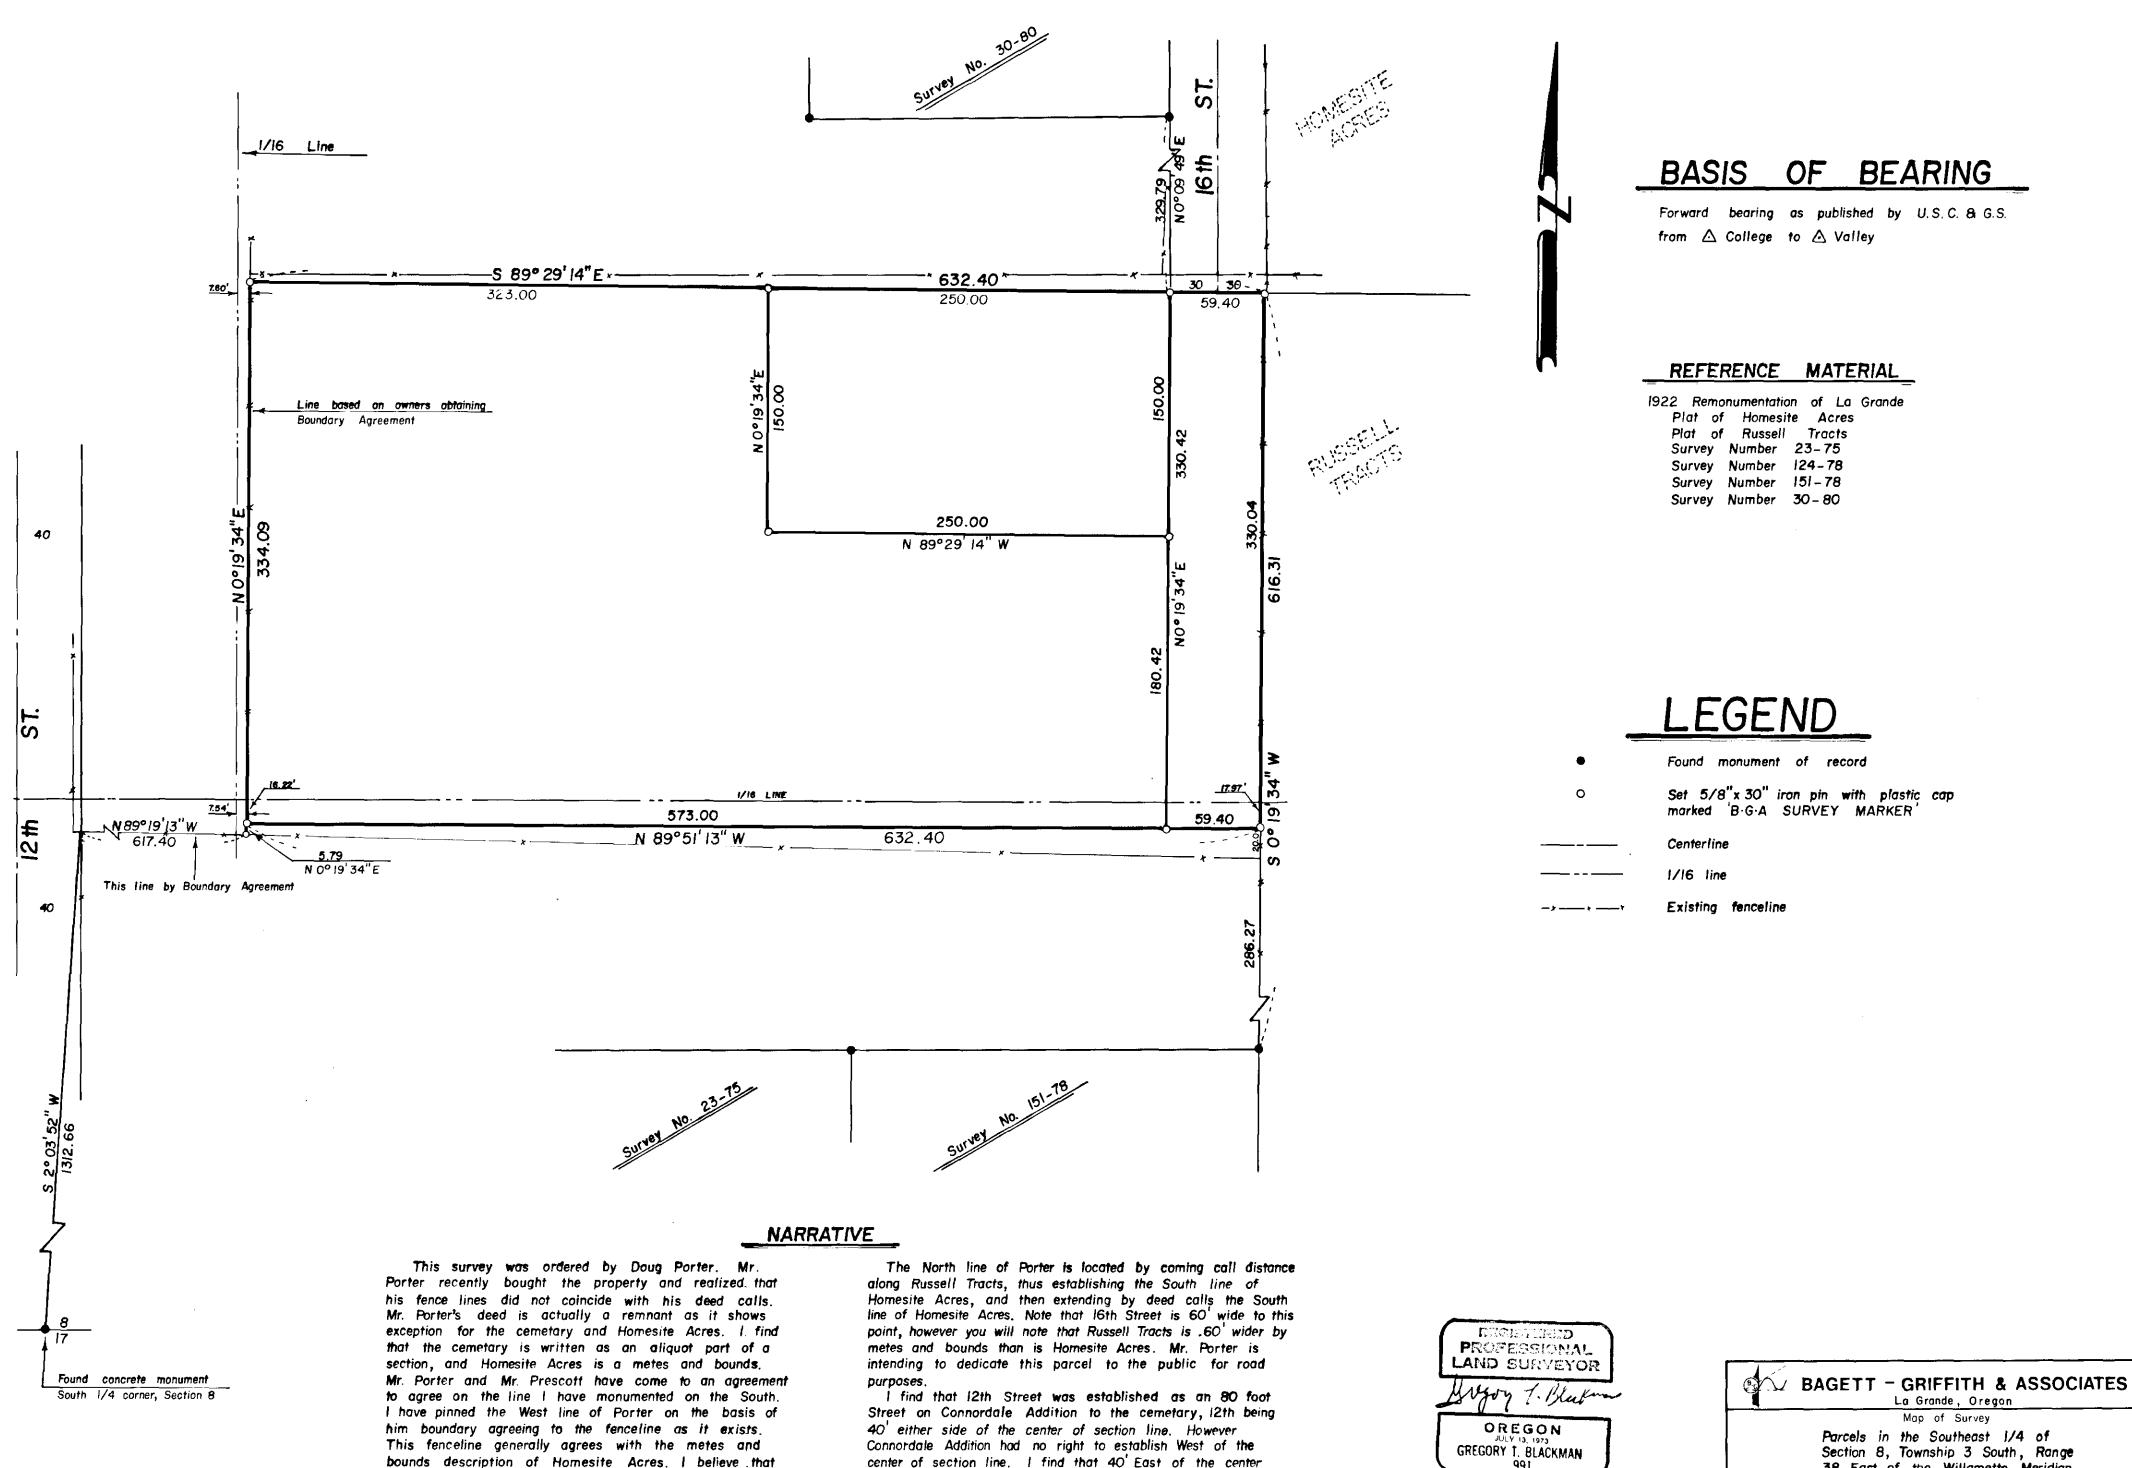

of section line will fit nicely with the older right of way

fence on the East side of 12th, hence I will use this

figure. I have used 40 East and 20 West of center

I find no other problems in this area.

and it fit existing conditions.

of section line on other surveys within Homesite Acres,

the fenceline could possibly be adversed by the

cemetary. I have also shown a boundary agreement

between the cemetary and Prescott. It is my understanding

that Prescott is going to quit claim to the cemetary all

of the property between the fence and the North line

of the Southwest 1/4 of the Southeast 1/4. See

quit claim deed.